

EXISTING CONDITIONS WERE TAKEN FROM ORIGINAL DRAWINGS AND MAY NOT REFLECT EXACT "AS-BUILT" CONDITIONS. CONTRACTOR SHALL FIELD VERIFY ALL EXISTING CONDITIONS PRIOR TO SUBMITTING FINAL BIDS. CONTRACTOR SHALL CAREFULLY COORDINATE NEW WORK AND DEMOLITION WITH ALL OTHER DISCIPLINES AND EXISTING CONDITIONS.

EACH SUBCONTRACTOR IS RESPONSIBLE FOR HAVING A THOROUGH KNOWLEDGE OF ALL DRAWINGS AND SPECIFICATIONS IN THEIR RELATED FIELD. THE FAILURE TO ACQUAINT HIMSELF WITH THIS KNOWLEDGE DOES NOT RELIEVE THE RESPONSIBILITY OF PERFORMING HIS WORK PROPERLY. NO ADDITIONAL COMPENSATION SHALL BE ALLOWED BECAUSE OF CONDITIONS THAT OCCUR DUE TO FAILURE TO FAMILIARIZE WORKERS WITH THIS KNOWLEDGE.

KEYNOTES


- PUMP DISCHARGE (PD) TO EXIT SUMP PIT AT 18" ABOVE BOTTOM OF SUMP PIT. REF ARCH DETAILS. MAKE CONNECTION TO PUMP WITH HOSE COUPLING FOR QUICK REMOVAL.
- EXISTING PIPING AND PIPING ACCESSORIES TO REMAIN UNLESS SHOWN OTHERWISE. FIELD VERIFY EXACT LOCATION.
- RELOCATE 1/2" AND 3/8" STUB-OUTS WITH QUICK DISCONNECT'S MOUNTED ON EXTERIOR WALL. KEEP FILTER(S), PRESSURE REGULATOR, AND LUBRICATOR INSIDE BUILDING. REF 3-YM3.0
- RELOCATE EXISTING AIR DROP AND ASSOCIATED ACCESSORIES TO COLUMN. RECONNECT TO EXISTING 1/2" UNDERSLAB AIR PIPING AS SHOWN.
- INSTALL NEW CHASE AS SHOWN AND CONNECT TO EXISTING OIL PUMP. USE LONG SWEET ELBOWS WHERE TURNS IN CHASE ROUTING ARE SHOWN. COORDINATE ROUTING OF CHASE WITH UNDERGROUND PIPING AND FOOTINGS.
- DEMO EXISTING FOUNDATION DRAIN AS NECESSARY FOR NEW LUBE PIT. INSTALL NEW 4" PERFORATED FOUNDATION DRAIN DOWN AND CONNECT TO EXISTING DRAIN WHERE POSSIBLE.
- CAP AND REMOVE EXISTING VENT RISER IN DEMOLISHED WALL. EXTEND BELOW GRADE VENT PIPING AS SHOWN. CONNECT TO EXISTING VTR.

HFA ARCHITECTS ENGINEERS INTERIORS
HARRISON FRENCH & ASSOCIATES, LTD.
 1705 S. Walnut Blvd., Suite 3
 Bentonville, Arkansas 72712
 t 479.273.7780
 f 888.520.9685
 www.hfa-ac.com

STIPULATION FOR REUSE:
 THIS DRAWING WAS PREPARED FOR USE IN CONNECTION WITH THE PROJECT IDENTIFIED HEREIN. IT IS NOT TO BE REPRODUCED, COPIED, OR TRANSMITTED IN ANY FORM OR BY ANY MEANS, ELECTRONIC OR MECHANICAL, INCLUDING PHOTOCOPYING, RECORDING, OR BY ANY INFORMATION STORAGE AND RETRIEVAL SYSTEM, WITHOUT THE WRITTEN PERMISSION OF THE ORIGINAL AUTHOR. ANY REUSE OF THIS DRAWING WITHOUT THE WRITTEN PERMISSION OF THE ORIGINAL AUTHOR IS PROHIBITED AND WILL BE CONSIDERED A VIOLATION OF THE PROFESSIONAL ETHICS OF THE ENGINEER.

1127 TYSON RD
 HOPE HULL, AL 36043
Speedco Remodel
 PROJECT NUMBER: 03-19-0718

Loves
 Travel Stop &
 Country Stores

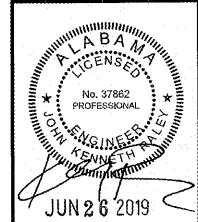


ISSUE BLOCK	
08/24/19	ADD #1

STORE NO.	718
DOCUMENT DATE:	04/11/19
CHECKED BY:	JKR
DRAWN BY:	PRC
PROTO CYCLE:	

PLUMBING FLOOR PLAN

SHEET: YM2.1

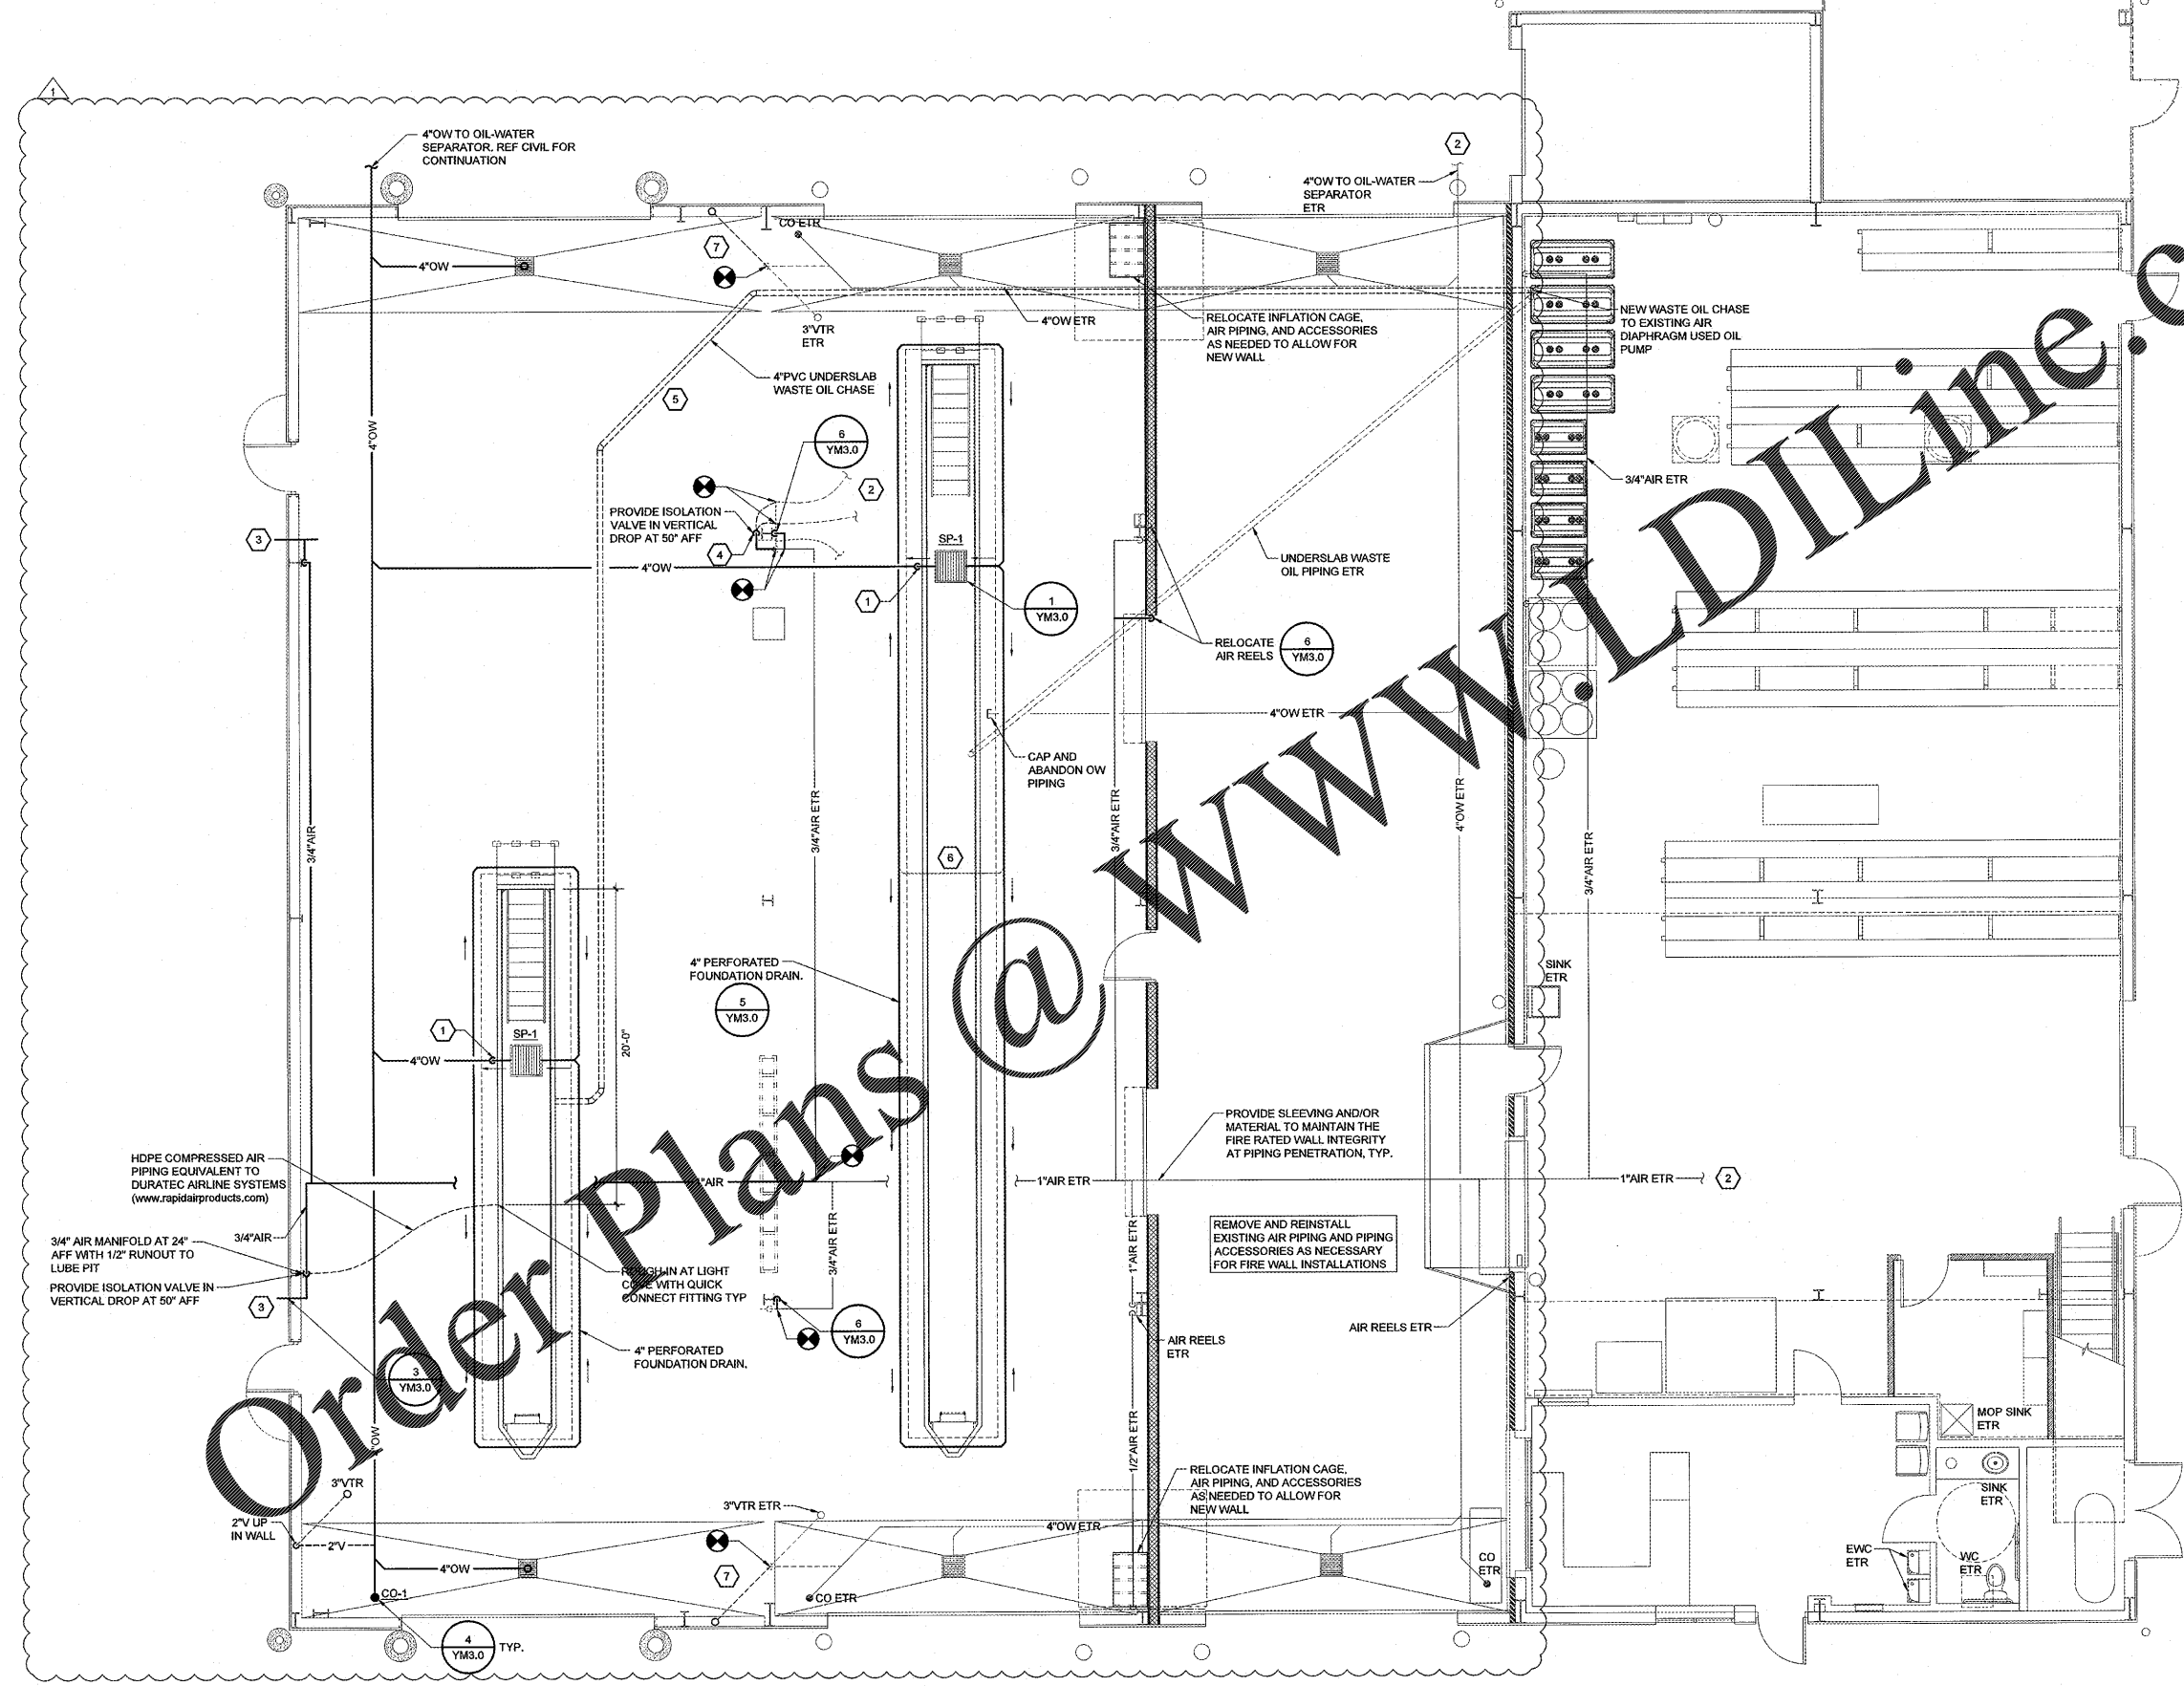

1 PLUMBING FLOOR PLAN
 SCALE: 3/16"=1'-0"

11/22/2019 3:44pm - User: pdiller_ah@hfa.com
 M:\2019-2020\03-19-0718 Lines - Hope Hull, AL\718CONDOCS\MEP_310_YM2.1_718.dwg