

**GENERAL NOTES:**



- DIMENSIONS TO FLOOR DRAINS AND FLOOR SINKS ARE TO CENTER OF DRAINS, MEASURED FROM SUBSTRATE FACE OF EXTERIOR WALLS AND FACE OF STUD AT NEW INTERIOR WALLS.
- SEE 3/4"x10" FOR WALL BASE DETAILS.
- CONCRETE SLAB JOINT FILLER (EXPOSED CONCRETE AREAS); PROVIDE SEMI-RIGID POLYUREA JOINT FILLER AT ALL CONCRETE CONTROL JOINTS AND TOOLED JOINTS, SPAL PRO RS-88, COLOR: "TURKISH COFFEE"
- SODA & BEER SLEEVES: PROVIDE GREY ELECTRICAL CONDUIT WITH FULL RADIUS SWEEPS WHERE SLEEVE COMES OUT OF FLOOR. SWEEPS TO BE COMPLETELY VERTICAL WHERE EXITING SLAB & CUT OFF 6" ABOVE SLAB. PLUMBER TO PROVIDE PVC CAP BEFORE LINES ARE PULLED SO THAT HOLES CAN BE CUT IN CAP AND LINES CAN BE PULLED THROUGH CAP AT INSTALL.
- PROVIDE CLEAR SILICONE JOINT WHERE FLOORING SYSTEM MEETS FRP IN ALL KITCHEN & BAR AREAS.
- FLOOR STAINING PROCESS:
  - APPLY (2) COATS AMERIPOLISH SURELOCK CONCRETE DYE, FOLLOW MFR. APPLICATION INSTRUCTIONS. REFER TO WEB LINK <http://www.ameripolish.com/TDS/AP-Surelock-TDS.pdf>
  - APPLY (2) COATS AMERIPOLISH SURELOCK STAIN PROTECTOR, FOLLOW MFR. APPLICATION INSTRUCTIONS. REFER TO WEB LINK <http://www.polishedconcretesolutions.com/template/images/mstds/wb-stain-protector.pdf>

**KEY NOTES:**

- ALUMINUM THRESHOLD AT FLOOR TRANSITION.
- BEER SLEEVES: DASHED LINE INDICATES 6" UNDERSLAB SLEEVES FOR BEER LINES. SEE GENERAL NOTE #6.
- SODA SLEEVES: DASHED LINE INDICATES (1) 6" UNDERSLAB SLEEVE FOR SODA LINES. CONTROL POINTS INDICATE ROUTING TO AVOID COLUMN AND STAIR FOUNDATIONS. SEE GENERAL NOTE #6.
- FLOOR SINK (8" DEEP), LOCATE AS DIMENSIONED.
- FLOOR DRAIN, LOCATE AS DIMENSIONED.
- FLOOR TRANSITION STRIP (TILE TO CONCRETE): TBD
- WALK-IN FREEZER BOX COMPARTMENT FURNISHED WITH INSULATED FLOOR. GC TO INSTALL KEG PROVIDED ALUMINUM DECKPLATE.
- NOT USED.
- CARPET TRANSITION STRIP: JOHNSONITE CTA-40-J (BLACK).
- 6" X 60" TRENCH DRAIN. SLOPE FLOOR 1/8"/FT TO DRAIN. ELEVATION OF DRAIN TO BE -3/32" AFF. LOCATE AS DIMENSIONED.
- 8" X 60" TRENCH DRAIN. SLOPE FLOOR 1/8"/FT TO DRAIN. ELEVATION OF DRAIN TO BE -3/8" AFF. LOCATE AS DIMENSIONED.
- LOCATE WATER LINE AS DIMENSIONED, SEE PLUMBING.
- PROVIDE NEW COMPLETE SLAB AT BAD DADDY'S INTERIOR, SEE STRUCT.

**MATERIALS SCHEDULE** SEE A600 FOR COMPLETE SCHEDULE

FINISH	DESCRIPTION	LOCATION	FINISH NO.	MFR	MFR NO.
BASE	QUARTZ BASE	KITCHEN	QB-1	SILIKAL	-
	QUARTZ BASE	BAR	QB-2	SILIKAL	-
	WOOD BASE	DINING/RESTROOMS	WB-1	CUSTOM	-
	METAL BASE	WALK-IN FREEZER	WB-4	SCHLUTER	DESIGNBASE-SL, 3-1/8" TALL
CEILING	CEILING TILE	KITCHEN	ACT-1	USG	CUMAPLUS #3690
	CEILING TILE	KITCHEN	ACT-2	USG	CUMAPLUS #3270
FLOOR	SEALED CONCRETE	DINING	SC-1	-	-
	CARPET	DINING	CPT	TANDUS	STACK 9 04332
	QUARTZ FLOORING	KITCHEN	QF-1	SILIKAL	-
	QUARTZ FLOORING	BAR	QF-2	SILIKAL	-
MILLWORK	BAR COUNTER	BAR	CTR-1	CUSTOM	-
	METAL WAINSCOT	DINING, RESTROOMS	PLAM-1	McNICHOLS	-
WALLS	WAINSCOT	BAR	PLAM-2	-	-
	WOOD SIDING	BAR, DINING (SEE INTERIOR ELEVATIONS)	WW-1	-	-
	FIBERGLASS REINFORCED PLASTIC	KITCHEN	FRP-1	CRANE COMPOSITES	GLASBOARD-P (PIF)
FIBERGLASS REINFORCED PLASTIC	BAR AT BARTENDER SIDE ONLY	FRP-2	CRANE COMPOSITES	GLASBOARD-P (PIF)	
	STAINLESS STEEL	KITCHEN	SS	CUSTOM	CUSTOM
MISC	EXPANDED METAL	METAL SCREENS	MS-1	McNICHOLS	-
	FABRIC	UPHOLSTERY, BOOTHS BACKS & SIDES	FAB1	KNOLL	ABACUS
	FABRIC	UPHOLSTERY, BOOTHS BACKS & SIDES	FAB2	ARCHITEX	SPRINKLE
	FABRIC	UPHOLSTERY, BOOTHS SEATS	FAB3	NASSIMI	CLASSIC

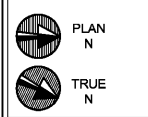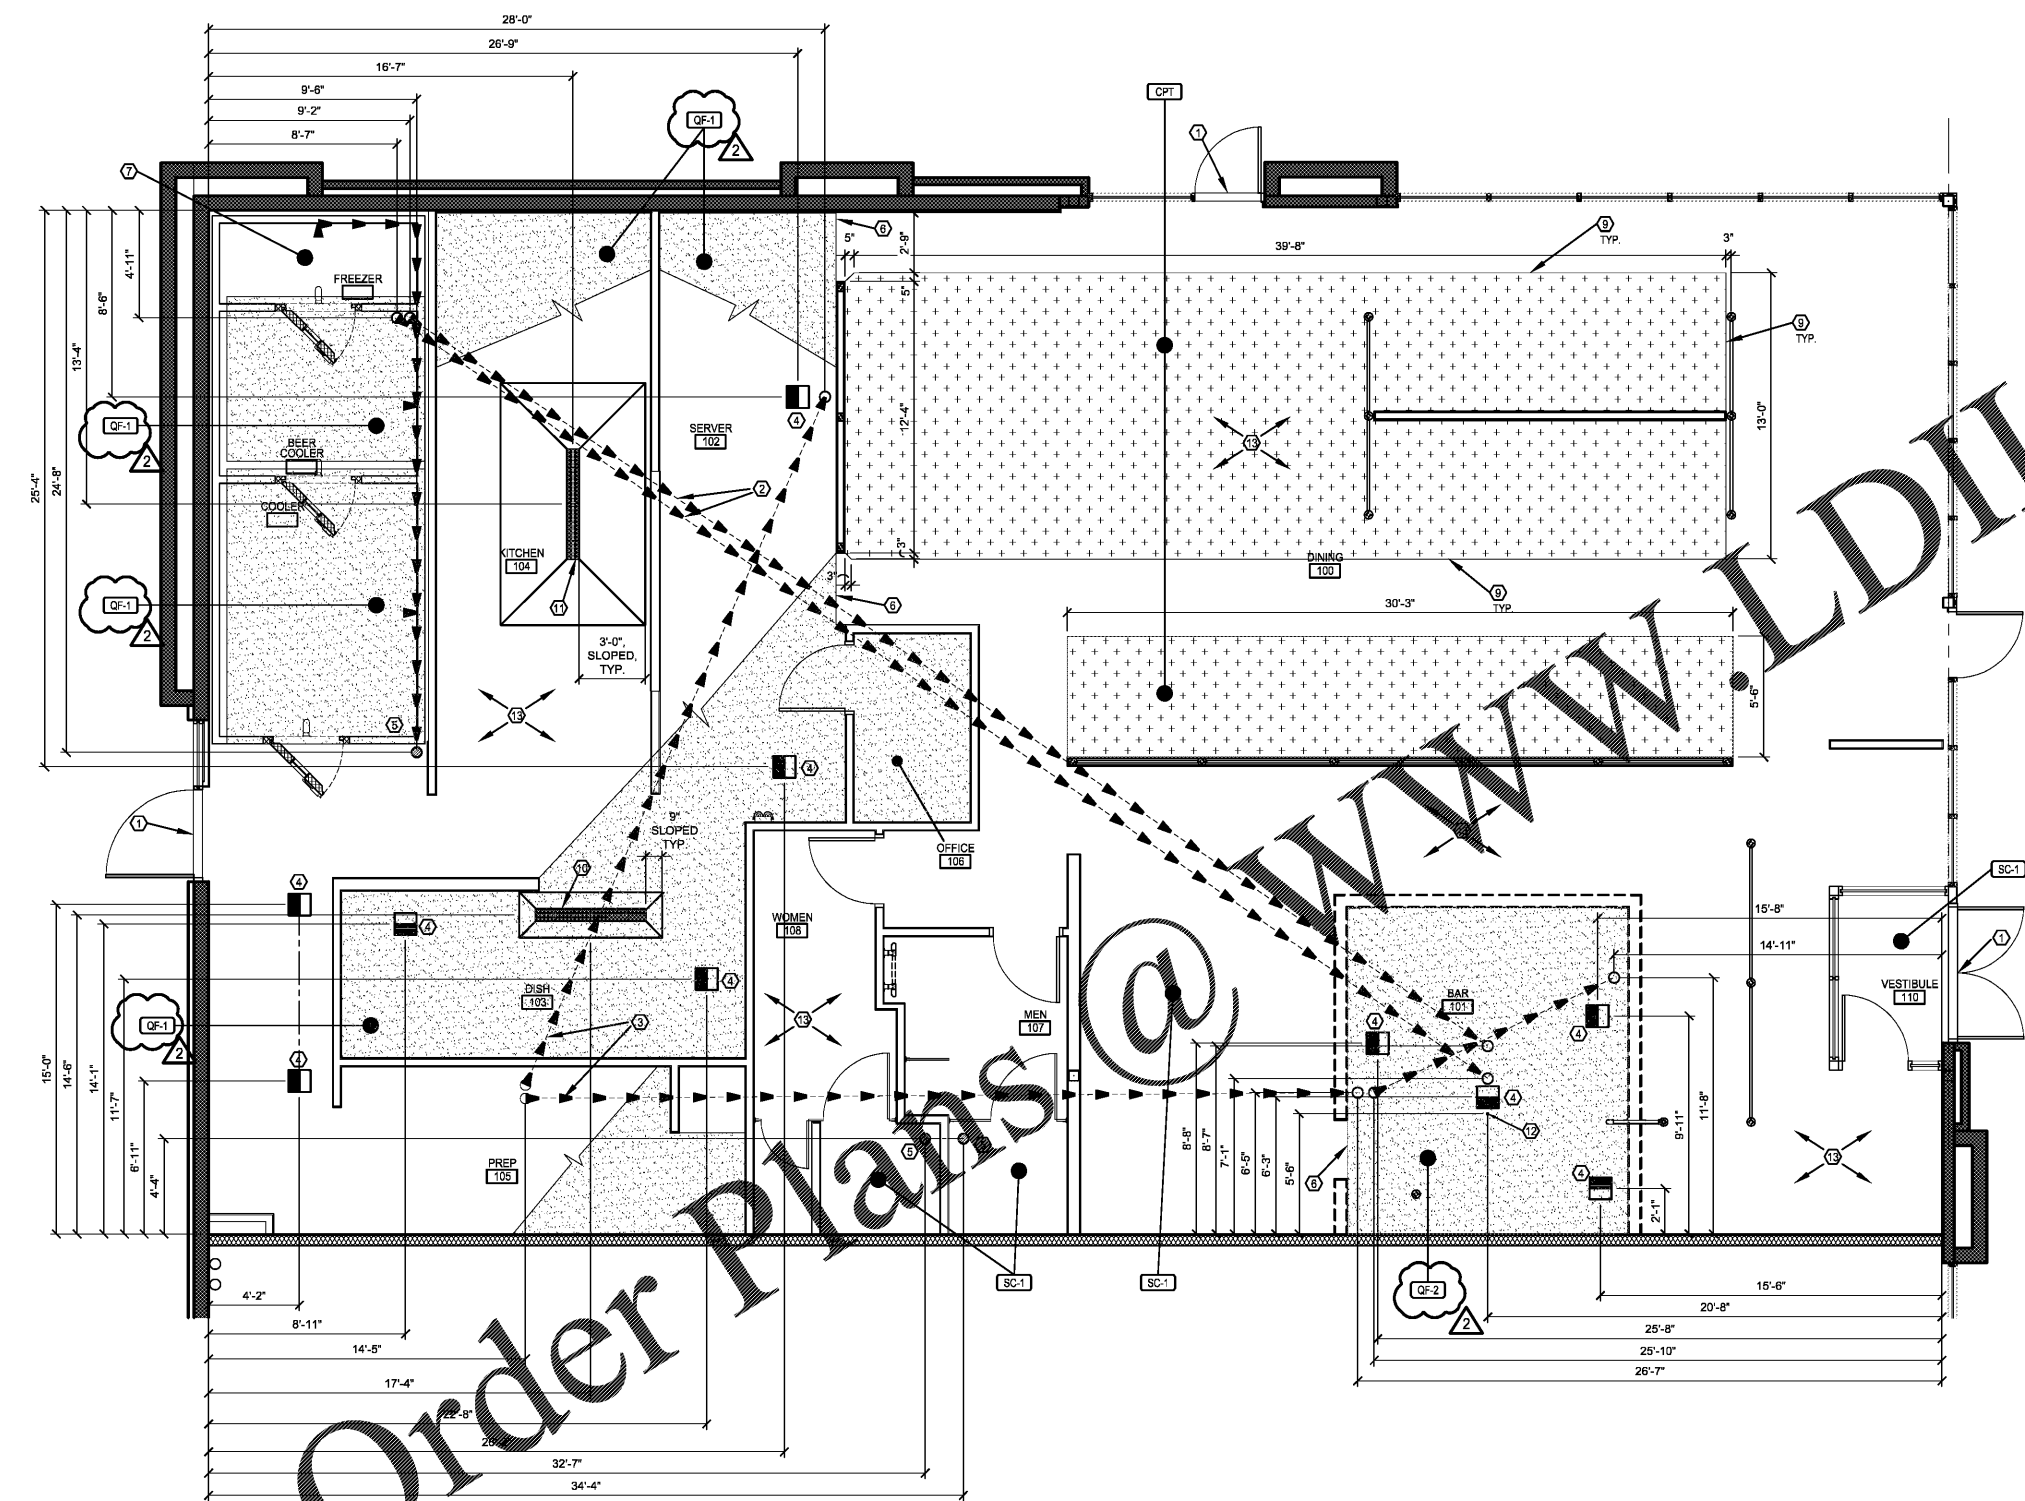

1 FLOOR FINISH PLAN  
1/4" = 1'-0" NOTE:

CONSULTANT:  
**JOHN SPONSELLER, ARCHITECT**  
8025 W. 25TH PL.  
LAKEWOOD, CO 80214  
TEL: (303) 815-0161

**GOOD TIMES RESTAURANTS, INC.**  
141 Union Blvd., Suite 400  
Lakewood, CO 80228  
303-384-1430

**BAD DADDY'S BURGER BAR**  
"SANDY PLAINS"  
3460 SANDY PLAINS RD N.E.  
SUITE 110  
MARIETTA, GA 30062

Issue Record:

6.7.2019	FOR PLAN REVIEW

Revisions:  
08.01.2019 BAR FIXT. TO GREASE WST.  
08.28.2019 OWNER REVS

Drawn:  
**DRAWN BY: JS, KC**

Checked:  
**CHECKED BY: JS**

Project No.  
**PROJECT#: 19-213**

**FLOOR FINISH PLAN**

**A125**

Date of Last Print:  
8.28.2019