

GENERAL NOTES:

- SS CORNER GUARDS AT ALL OUTSIDE KITCHEN CORNERS FURNISHED BY KITCHEN SUPPLIER.
- SEE 2/A420 FOR WALL BASE DETAILS.
- PAINT ALL EXPOSED STEEL COLUMNS PT-1B.
- DIAMOND PLATE WAINSCOT (PLAM-1) SHALL BE ADHERED, NOT MECHANICALLY FASTENED. ANGLE & FLAT STOCK OVER CORNERS & SEAMS TO BE ADHERED WITH SILICONE.
- ELECTRICAL/DATA/PHONE OUTLET COLORS:
 - WHITE FRP WALL AREAS: WHITE
 - STAINLESS STEEL WALL FINISH AREAS: STAINLESS STEEL
 - ALL OTHER AREAS: BLACK.
- DRYWALL TO BE LEVEL 5 FINISH WHERE PAINTED.
- PAINT NOTES: PREP ALL SURFACES PER MANUFACTURERS' DATA PAGE. ALL SURFACES TO RECEIVE 1 PRIMER COAT AND 2 FINISH COATS PER MANUFACTURERS' DATA PAGE.
- POPULAR WAINSCOT CAP TO BE SELECT GRADE, TYP. ALL PUBLIC AREAS.

KEY NOTES: Ⓢ


- PAINT DOOR PT-4A (DK BLUE) & FRAME PT-6 (BLACK), TYP. BOTH SIDES AT INTERIOR DOOR.
- PAINT DOOR & FRAME PT-7 (WHITE), BOTH SIDES AT INTERIOR DOOR.
- 5-1/2" HIGH, COVED STAINLESS STEEL WALL BASE.
- STAINLESS STEEL WALL FINISH AT JUNCTION, SEE INTERIOR ELEVATION.
- SEAL WB-1 EDGE TO DOOR, RESTROOMS W/ BLACK SILICONE.
- INSTALL FULL HEIGHT SS PANEL ON INSIDE OF DOOR.
- WB-1 WALL FINISH TO UNDERSIDE OF BAR SCREEN (12'-0") PAINT PT-3 ABOVE SOFFIT
- FULL HEIGHT GALVANIZED CORNER GUARD.

MATERIALS SCHEDULE SEE A600 FOR COMPLETE SCHEDULE


FINISH	DESCRIPTION	LOCATION	FINISH NO.	MFR	MFR NO.
BASE	QUARTZ BASE	KITCHEN	QB-1	SILIKAL	-
	QUARTZ BASE	BAR	QB-2	SILIKAL	-
	WOOD BASE	DINING/RESTROOMS	WB-1	CUSTOM	-
	METAL BASE	WALK-IN FREEZER	WB-4	SCHLUTER	DESIGNBASE-SL, 3-1/8" TALL
WALLS	METAL WAINSCOT	DINING, RESTROOMS	PLAM-1	McNICHOLS	-
	WAINSCOT	BAR	PLAM-2	-	-
	WOOD SIDING	BAR, DINING (SEE INTERIOR ELEVATIONS)	WW-1	-	-
MISC	FIBERGLASS REINFORCED PLASTIC	KITCHEN	FRP-1	CRANE COMPOSITES	GLASBOARD-P (PIF)
	FIBERGLASS REINFORCED PLASTIC	BAR AT BARTENDER SIDE ONLY	FRP-2	CRANE COMPOSITES	GLASBOARD-P (PIF)
	STAINLESS STEEL	KITCHEN	SS	CUSTOM	CUSTOM
	EXPANDED METAL	METAL SCREENS	MS-1	McNICHOLS	-
MISC	FABRIC	UPHOLSTERY, BOOTHS BACKS & SIDES	FAB1	KNOLL	ABACUS
	FABRIC	UPHOLSTERY, BOOTHS BACKS & SIDES	FAB2	ARCHITEX	SPRINKLE
	FABRIC	UPHOLSTERY, BOOTHS SEATS	FAB3	NASSIMI	CLASSIC

PAINT SCHEDULE

PAINT	DESCRIPTION	LOCATION	FINISH NO.	MFR	MFR NO.
PAINT	DRYWALL SOFFITS & CEILINGS		PT-1	SHERWIN WILLIAMS	#SW0038 LIBRARY PEWTER
PAINT	DINING EXPOSED CEILING		PT-1A	SHERWIN WILLIAMS	#SW0038 LIBRARY PEWTER
PAINT	INTERIOR STAIR RAILINGS AND STEEL COLUMNS		PT-1B	SHERWIN WILLIAMS	#SW0038 LIBRARY PEWTER
PAINT	RESTROOM CEILINGS		PT-2	SHERWIN WILLIAMS	#SW156 RAMIE
PAINT	DRYWALL WALLS		PT-3	SHERWIN WILLIAMS	#SW6424 TANSY GREEN
PAINT	RESTROOM WALLS		PT-3A	SHERWIN WILLIAMS	#SW6424 TANSY GREEN
PAINT	DRYWALL WALLS, DRYWALL SOFFITS & CEILINGS		PT-4	SHERWIN WILLIAMS	#SW2739 CHARCOAL BLUE
PAINT	RESTROOM DOORS & STORAGE & OFFICE DOORS WHEN VISIBLE TO CUSTOMER		PT-4A	SHERWIN WILLIAMS	#SW2739 CHARCOAL BLUE
PAINT	DRYWALL WALLS		PT-5	SHERWIN WILLIAMS	#SW0033 REMBRANDT RUBY
PAINT	WOOD TRIM, DINING & RR DOOR FRAMES, EXT. RAILING, PATIO STRUCTURE		PT-6	SHERWIN WILLIAMS	#SW6991 BLACK MAGIC
PAINT	KITCHEN DOORS (INTERIOR FACE) & KITCHEN COLUMNS		PT-7	SHERWIN WILLIAMS	#SW7006 EXTRA WHITE
PAINT-PRIMER	DRYWALL WALLS		PRIMER-1	SHERWIN WILLIAMS	
PAINT-PRIMER	WOOD (DOORS, TRIM)		PRIMER-2	SHERWIN WILLIAMS	
PAINT-PRIMER	METAL (DOOR FRAMES, STEEL COLUMNS, RAILINGS)		PRIMER-3	SHERWIN WILLIAMS	
FIRE TREATMENT	WOOD SIDING CLEAR COAT		FTR-1		FLAME CONTROL 1291

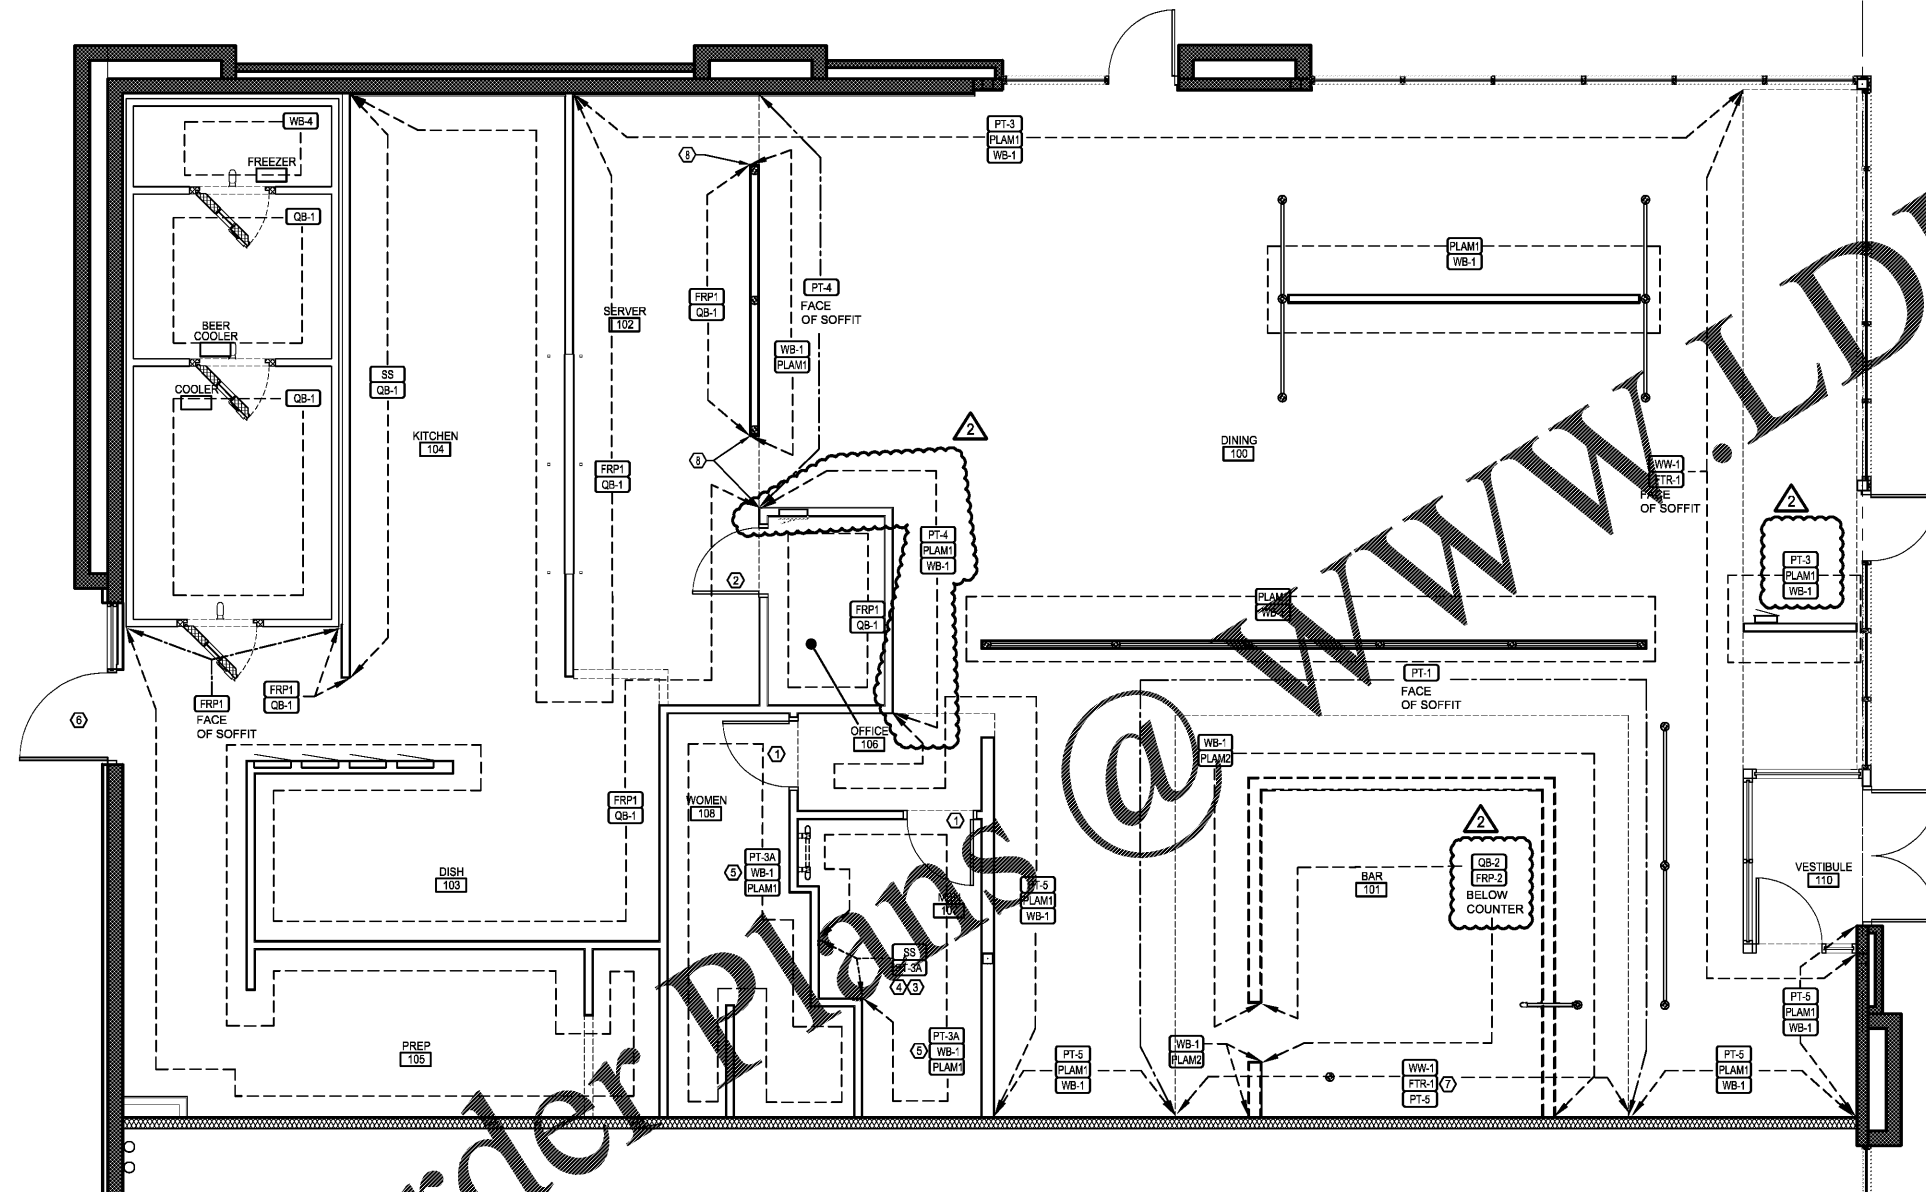

Order Plans @ WWW.LDILLIUM.COM

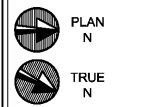

1 WALL FINISH PLAN
1/4" = 1'-0" NOTE:

CONSULTANT:
JOHN SPONSELLER, ARCHITECT
8025 W. 25TH PL.
LAKEWOOD, CO 80214
TEL: (303) 815-0161

GOOD TIMES RESTAURANTS, INC.
141 Union Blvd., Suite 400
Lakewood, CO 80228
303-384-1430

BAD DADDY'S BURGER BAR
"SANDY PLAINS"
3460 SANDY PLAINS RD N.E.
SUITE 110
MARIETTA, GA 30062

Issue Record:
6.7.2019 FOR PLAN REVIEW
Revisions:
08.01.2019 BAR FIXT. TO GREASE WST.
08.28.2019 OWNER REVS

Drawn:
DRAWN BY: JS, KC
Checked:
CHECKED BY: JS
Project No.
PROJECT#: 19-213

WALL FINISH PLAN

A127

Date of Last Print:
8.28.2019