


1 ELEVATION : SERVER/ KITCHEN  
1/4" = 1'-0" NOTE:

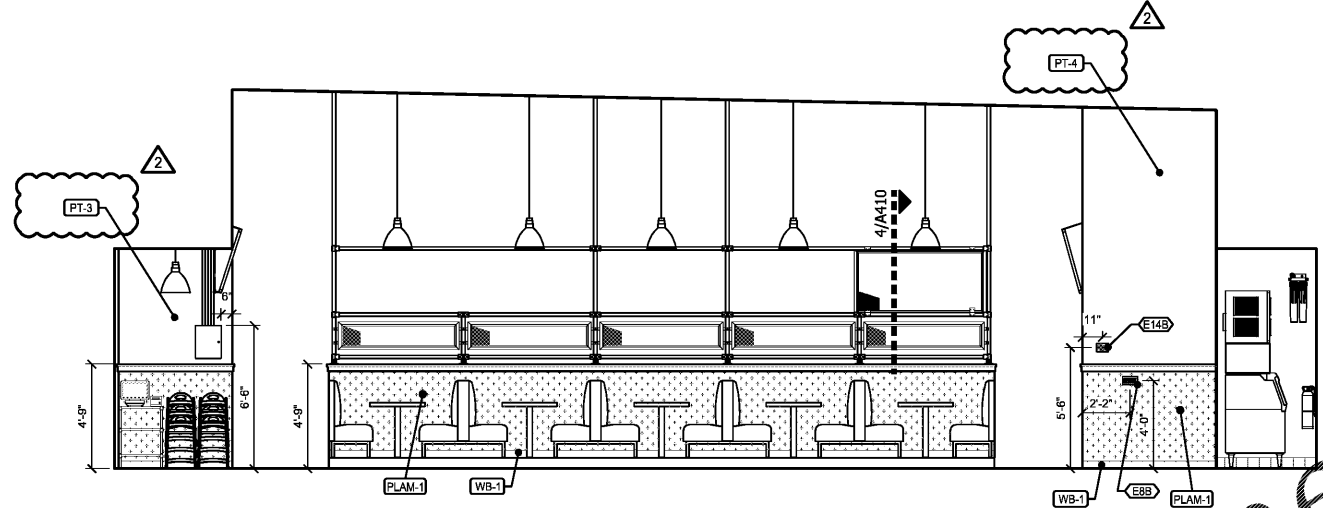

2 ELEVATION : DINING  
1/4" = 1'-0" NOTE:

- GENERAL NOTES:**
- SEE SHEETS K3-K5 FOR EQUIPMENT SCHEDULE.
  - SEE SHEET A127 FOR WALL FINISH PLAN.
  - ALL NOTES SHOWN ARE TYP. AT SIMILAR CONDITIONS.
  - PLAM-1 JOINTS: INSTALL OWNER-SUPPLIED 1-1/2" X 1-1/2" GALVANIZED STEEL ANGLE TRIM AT CORNERS. 1-1/2" GALVANIZED STEEL FLAT STOCK TO COVER BUTT PANEL JOINTS, ATTACH WITH SILICONE ADHESIVE.

- KEY NOTES:**
- 1X4 SELECT GRN. POPLAR TRIM, FINIT PT-6.
  - METAL SCREEN. SEE DETAIL ON SHEET A420.
  - SCREEN MOUNTED METAL SCREEN W/ TV. SEE DETAIL 7/A410.
  - LIGHT FIXTURE. SEE A600 FOR MOUNTING HEIGHTS.

CONSULTANT:  
**JOHN SPONSELLER, ARCHITECT**  
8025 W. 25TH PL.  
LAKEWOOD, CO 80214  
TEL: (303) 815-0161



GOOD TIMES RESTAURANTS, INC.  
141 Union Blvd, Suite 400  
Lakewood, CO 80228  
303-584-1430

BAD DADDY'S BURGER BAR  
"SANDY PLAINS"  
3460 SANDY PLAINS RD N.E.  
SUITE 110  
MARIETTA, GA 30062

Issue Record:


6.7.2019	FOR PLAN REVIEW

Revisions:  
 08.01.2019 BAR FIXT. TO GREASE WST.  
 08.28.2019 OWNER REVS


Drawn:  
DRAWN BY: JS, KC  
Checked:  
CHECKED BY: JS  
Project No.  
PROJECT#: 19-213  
Contractor:

INTERIOR ELEVATIONS


A220  
Date of last Print:  
8.28.2019

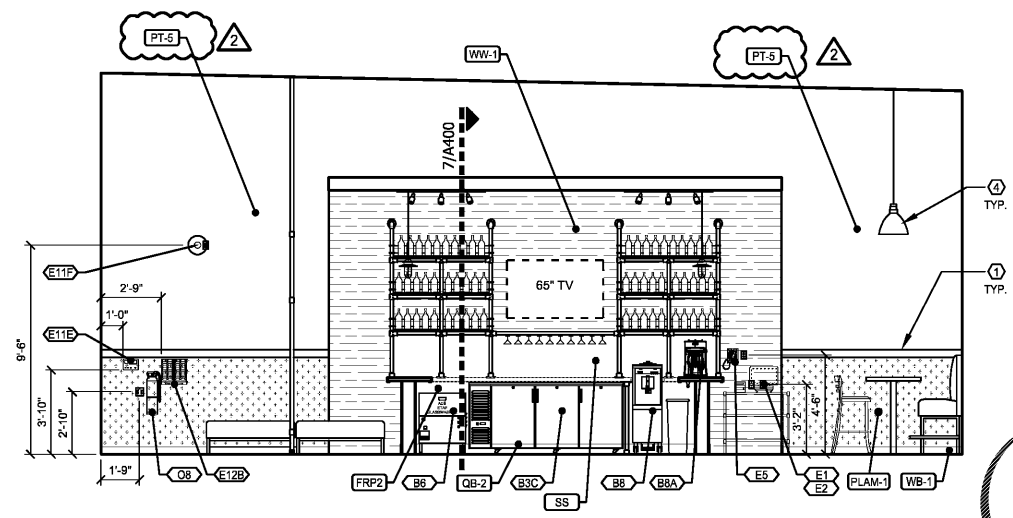


3 ELEVATION : BAR  
1/4" = 1'-0" NOTE:

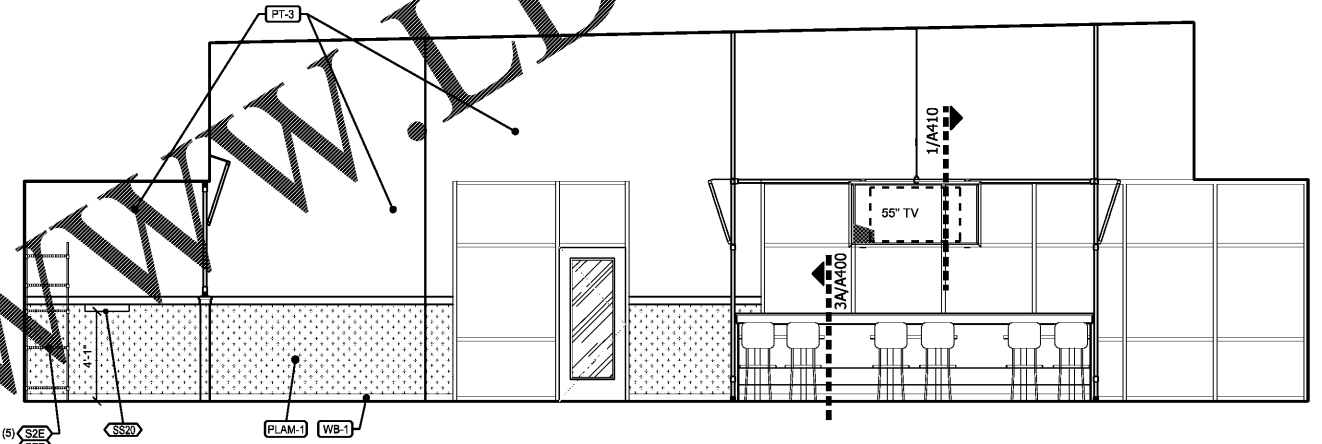

4 ELEVATION : DINING  
1/4" = 1'-0" NOTE:

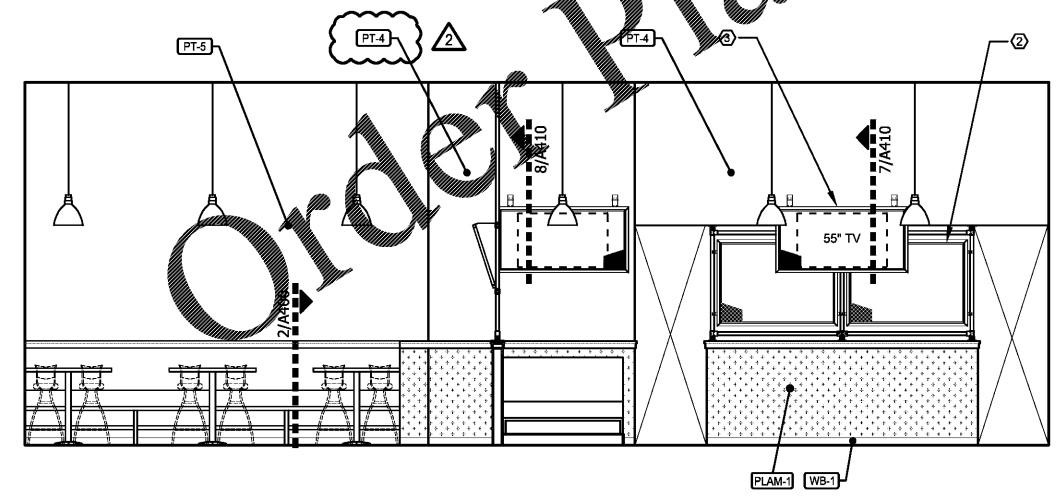

5 ELEVATION : DINING  
1/4" = 1'-0" NOTE:

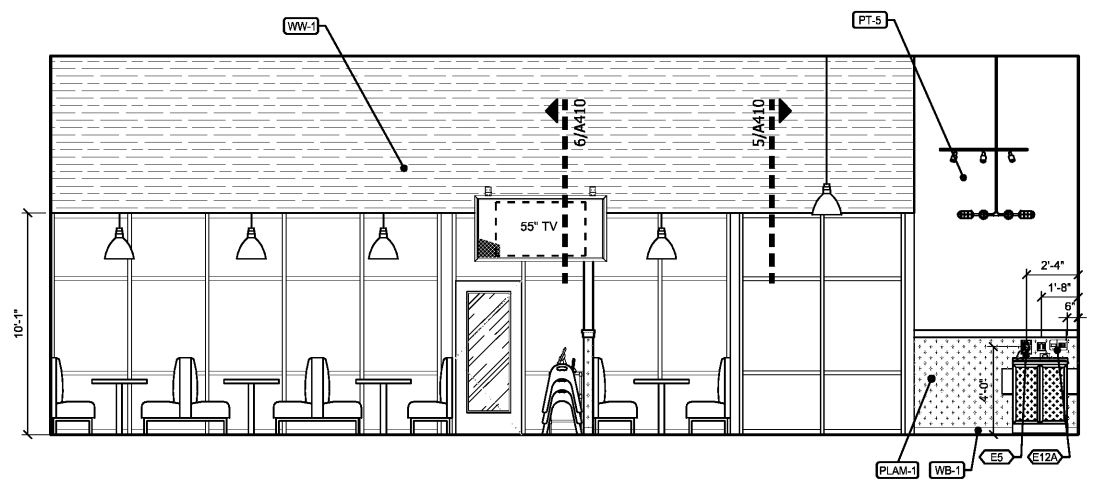

6 ELEVATION : DINING  
1/4" = 1'-0" NOTE:

Order Plans @

WWW.LDILine.com