


CONSULTANT:  
**JOHN SPONSELLER, ARCHITECT**  
 8025 W. 25TH PL.  
 LAKEWOOD, CO. 80214  
 TEL: (303) 815-0161

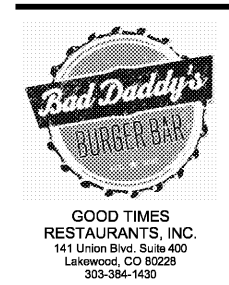

**BAD DADDY'S BURGER BAR  
 "SANDY PLAINS"  
 3460 SANDY PLAINS RD N.E.  
 SUITE 110  
 MARIETTA, GA 30062**

Issue Record:


6.7.2019	FOR PLAN REVIEW

Revisions:  
 ▲ 08.01.2019 BAR FIXT. TO GREASE WST.  
 ▲ 08.28.2019 OWNER REVS

Drawn:  
**DRAWN BY: JS, KC**  
 Checked:  
**CHECKED BY: JS**  
 Project No.  
**PROJECT#: 19-213**  
 Contact:

**WALL SECTIONS**

**A300**  
 Date of Last Print:  
**8.28.2019**

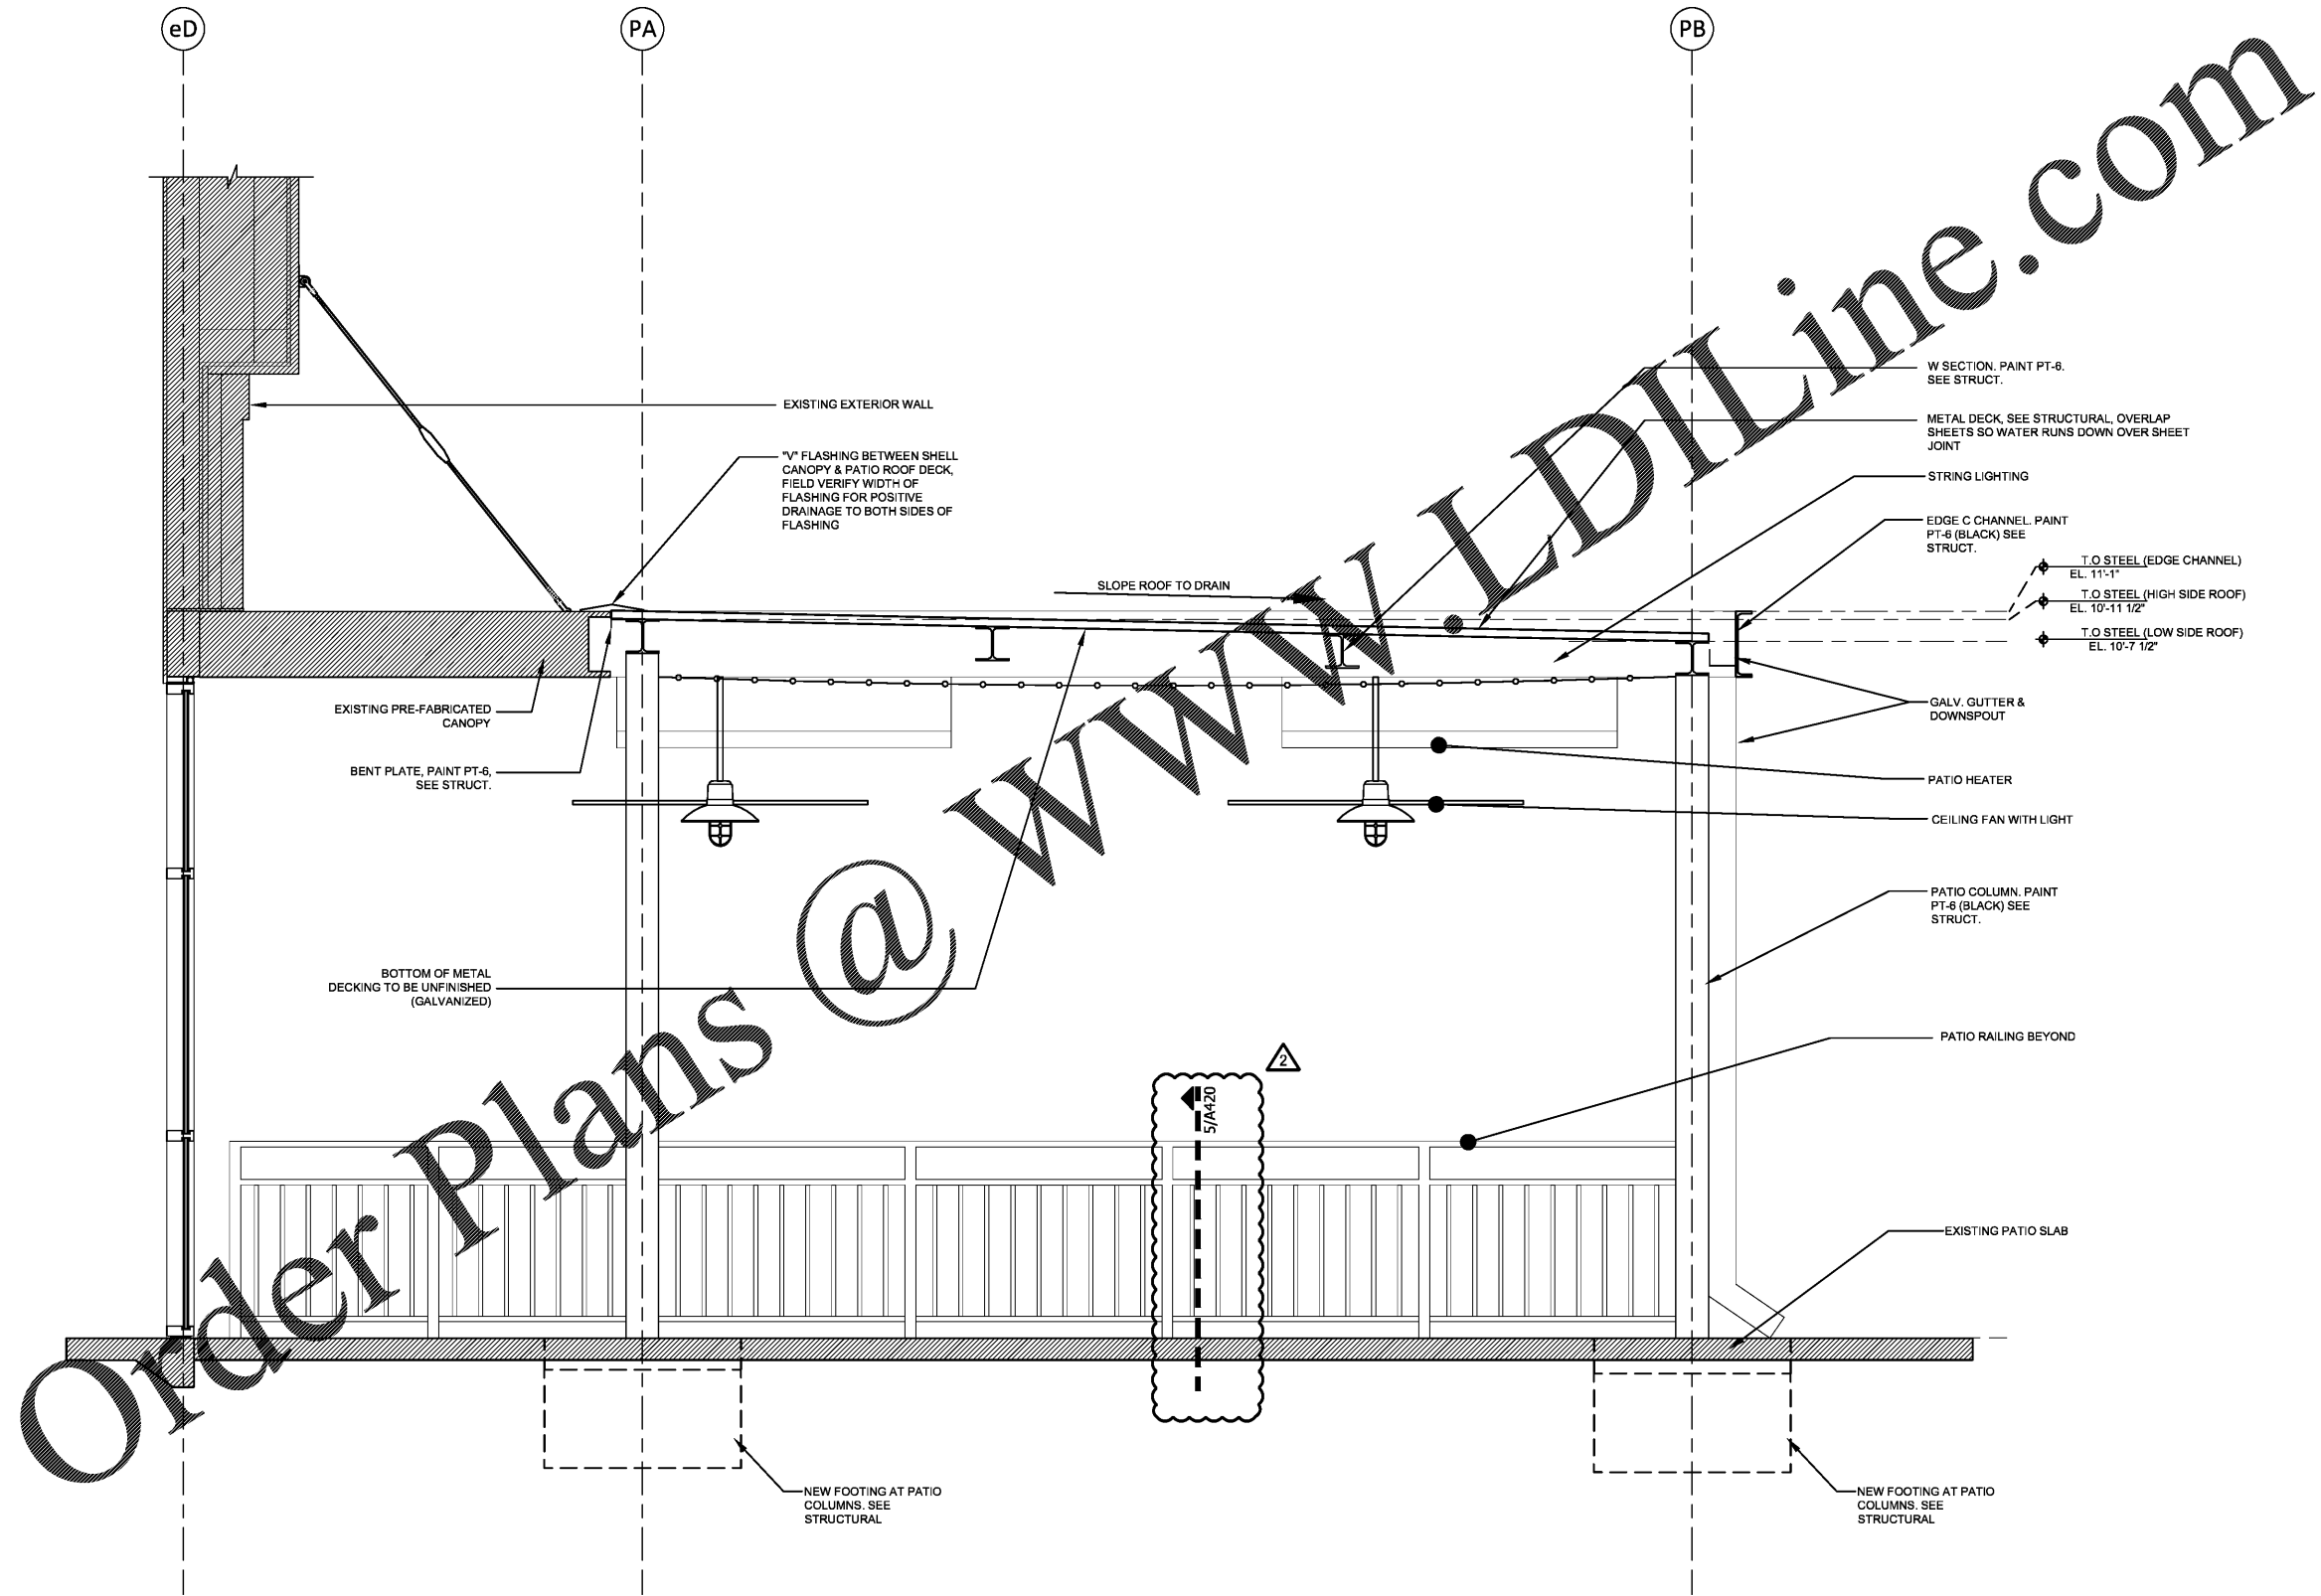

Order plans @ [www.LDILine.com](http://www.LDILine.com)