

**PLUMBING SHEET NOTES**

- 1 Field verify location of existing sanitary waste; verify all sizes, inverts & points-of-connection.
- 2 Field verify location of existing grease waste; verify all sizes, inverts & points of connection.

Consultant:  
**ARWIN PRIEST P.E., P.Eng.**  
 MECHANICAL \* ENGINEER \* ELECTRICAL  
 242 MOUNTAIN CLOUD CIRCLE  
 HIGHLANDS RANCH, CO 80126  
 (303) 898-2664 pc5744@gmail.com

**5280 Engineering**  
 www.DesignMEP.com  
 720-320-7744 rpe@5280engineering.com

SEAL

DATE :



**GOOD TIMES RESTAURANTS, INC.**  
 141 Union Blvd, Suite 400  
 Lakewood, CO 80228  
 tel: (303) 384-1430

**BAD DADDY'S BURGER BAR**  
 "SANDY PLAINS"  
 3460 SANDY PLAINS RD  
 SUITE 110  
 MARIETTA, GA 30062

Issue Record:  
 06.07.2019 FOR PLAN REVIEW

Revisions:  
 08.01.2019 BAR FIXT. TO GREASE WST  
 08.28.2019 QCR


Drawn:  
 DRAWN BY: F Long

Checked:  
 CHECKED BY: R Blank

Project No.  
 PROJ.FCT#: 2019-041

Contract:  
 PLUMBING:  
 WASTE & VENT ISOMETRIC

**P-5**  
 of 5

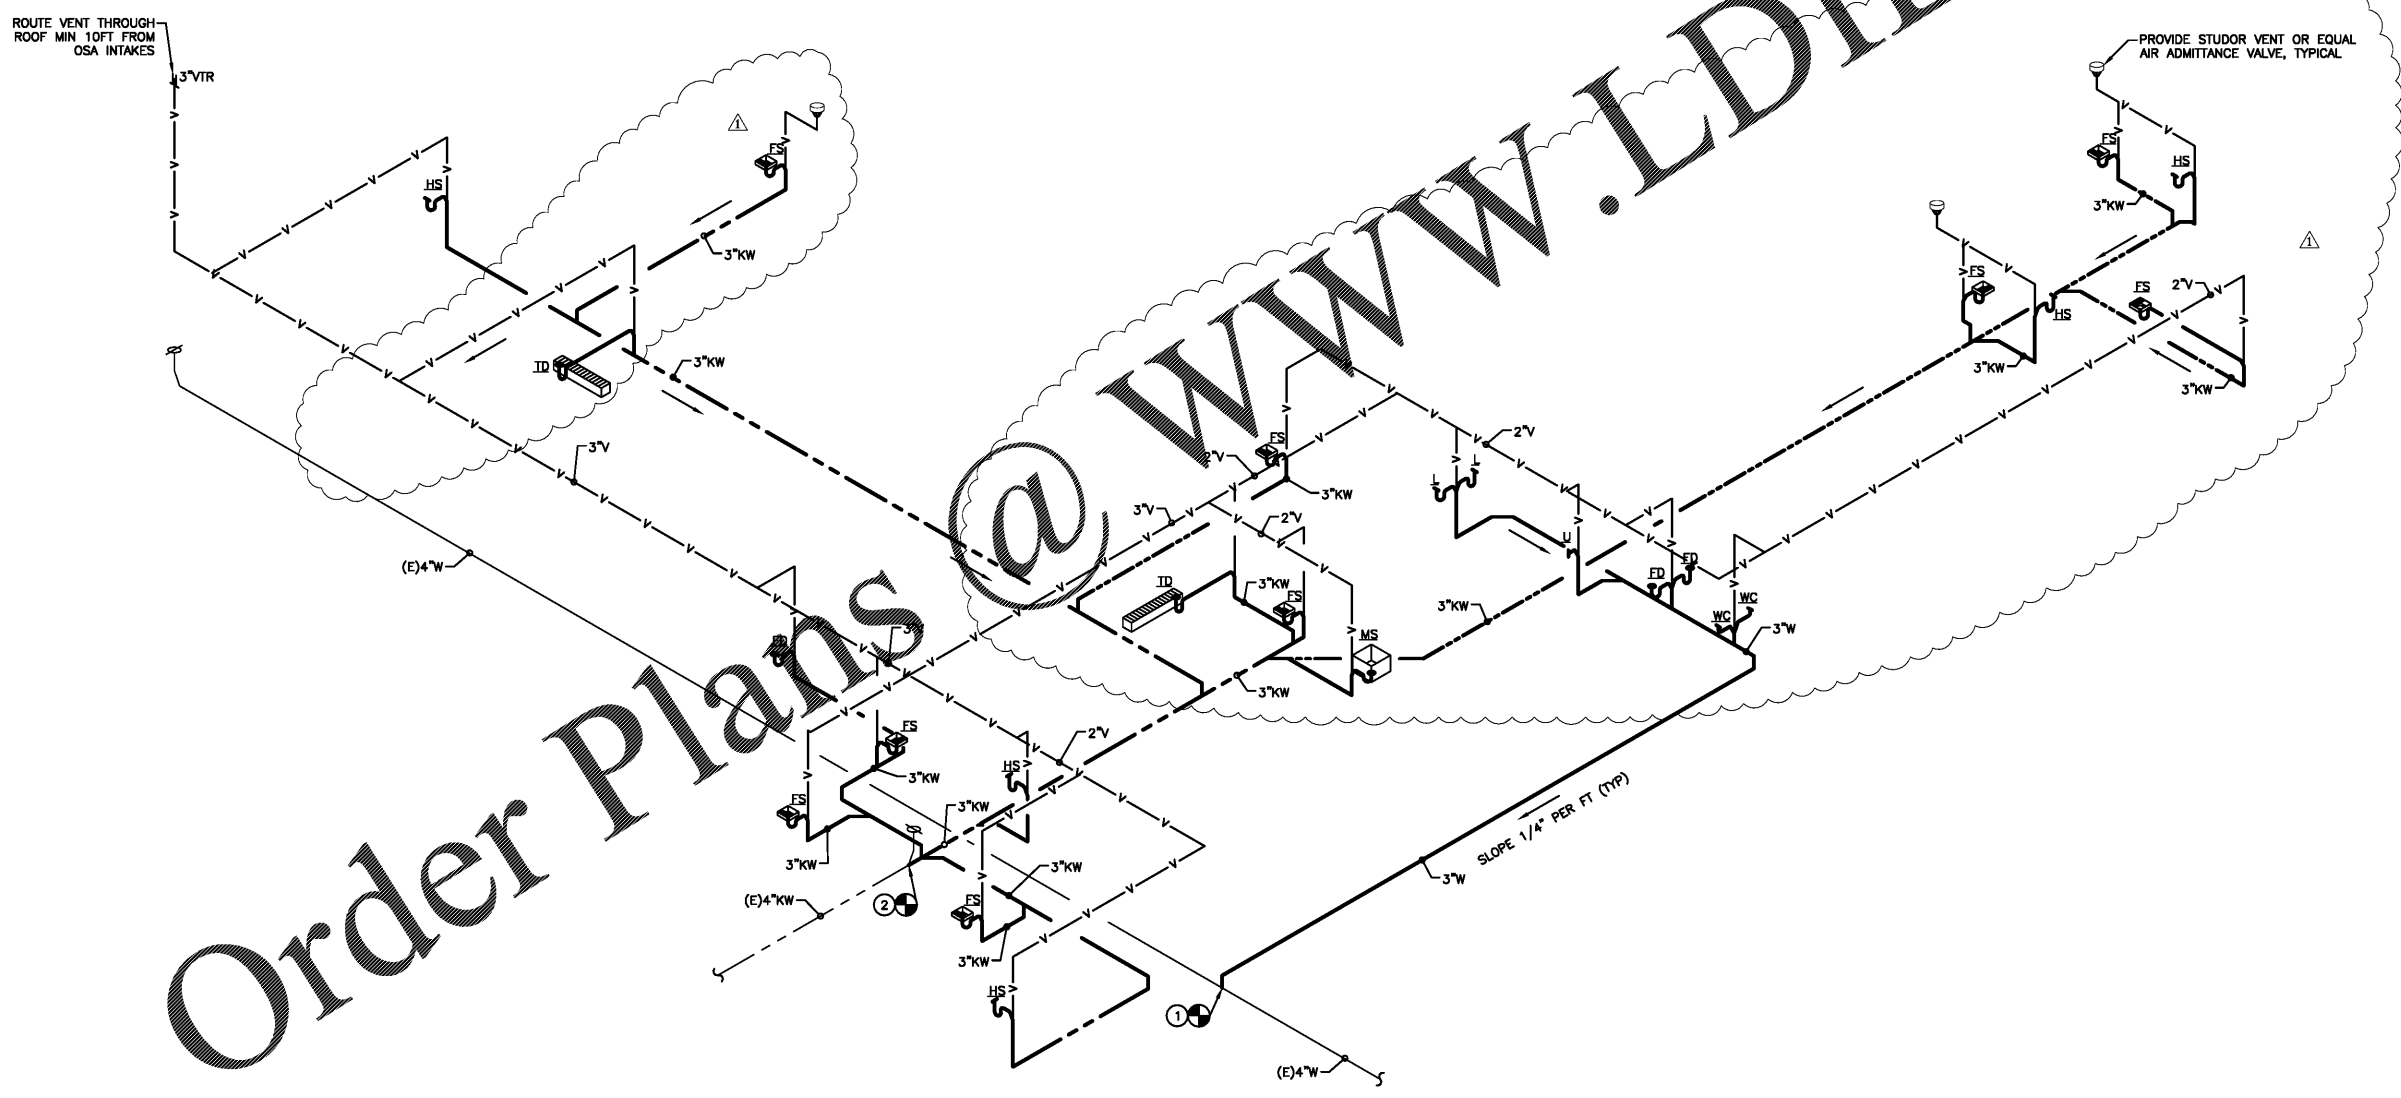

Order Plans @ WWW.LDILine.com

**1 GREASE/SANITARY WASTE & VENT ISOMETRIC**  
 P-5 NO SCALE