
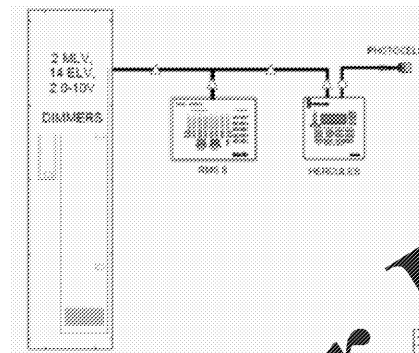


ELECTRICAL SPECIFICATIONS:

- THE ELECTRICAL CONTRACTOR SHALL PROVIDE ALL LABOR AND MATERIAL NECESSARY FOR A COMPLETE AND FUNCTIONAL ELECTRICAL SYSTEM.
- MATERIALS AND INSTALLATION SHALL COMPLY WITH CODES, LAWS AND ORDINANCES OF FEDERAL, STATE AND LOCAL GOVERNING BODIES HAVING JURISDICTION.
- MATERIALS AND EQUIPMENT SHALL BE LISTED AND/OR LABELED BY U.L., E.T.L., CSA OR ANOTHER RECOGNIZED TESTING LAB.
- THE CONTRACTOR SHALL SECURE AND PAY FOR ALL PERMITS, GOVERNMENTAL FEES, TAXES AND LICENSES NECESSARY FOR THE PROPER EXECUTION AND COMPLETION OF THE ELECTRICAL WORK.
- THE CONTRACTOR SHALL CAREFULLY EXAMINE THE CONTRACT DOCUMENTS, VISIT THE SITE, AND THOROUGHLY BECOME FAMILIAR WITH THE BUILDING STANDARDS AND LOCAL CONDITIONS RELATING TO WORK. FAILURE TO DO SO WILL NOT RELIEVE THE CONTRACTOR OF THE OBLIGATIONS OF THE CONTRACT.
- THE CONTRACTOR SHALL PROVIDE TEMPORARY POWER AND WIRING FOR THE PERFORMANCE OF ALL TRADES FOR THE ENTIRE PERIOD OF CONSTRUCTION.
- ALL MATERIALS AND EQUIPMENT SHALL BE ERECTED, INSTALLED, CONNECTED, CLEANED, ADJUSTED AND PLACED IN SERVICE IN ACCORDANCE WITH THE MANUFACTURER'S RECOMMENDATIONS AND DIRECTIONS.
- DRAWINGS ARE NOT TO BE SCALED FOR LOCATIONS. ALL WORK TO BE COORDINATED WITH HVAC, PLUMBING AND SUSPENDED CEILING FOR PROPER FIT, RELATION, CLEARANCE AND LOCATION.
- FURNISH AND INSTALL ALL POWER WIRING TO MOTORS, HEATER AND OTHER MECHANICAL EQUIPMENT AS INDICATED ON DRAWINGS. WIRING INTO MOTOR OR EQUIPMENT TERMINALS SHALL BE COMPLETE WITH CONNECTIONS THROUGH ASSOCIATED MOTOR STARTERS AND DISCONNECT SWITCHES.
- ALL EXPOSED NON-CURRENT-CARRYING METALLIC PARTS OF ELECTRICAL EQUIPMENT, CONDUIT SYSTEMS AND NEUTRAL CONDUCTOR OF THE WIRING SYSTEM SHALL BE GROUNDED.
- DEVICE PLATES SHALL BE INSTALLED FOR ALL DEVICES, BOXES ETC., AND SHALL BE SUITABLE FOR THE DEVICE INSTALLED. PLATES SHALL BE STAINLESS STEEL, SATIN FINISH.
- ALL MATERIALS, EQUIPMENT, WIRING, DEVICES ETC. SHALL BE NEW AND FREE OF DAMAGE.
- ELECTRICAL METALLIC TUBING OR MC CABLE WHERE ALLOWED BY CODE SHALL BE USED FOR ALL DEVICES IN PARTITIONS OR ABOVE CEILINGS. CONDUITS LARGER THAN 2" DIAMETER SHALL BE INTERMEDIATE METAL CONDUIT (IMC). ALL CONDUITS ROUTED UNDERGROUND SHALL BE GRC OR PVC. METALLIC CONDUITS SHALL BE USED FOR ALL EXPOSED WIRING AND FOR ALL LOW VOLTAGE WIRING INCLUDING DATA, AUDIO AND VIDEO.
- FINAL CONNECTIONS TO MOTORS SHALL BE MADE WITH LIQUID TIGHT FLEXIBLE STEEL CONDUIT.
- WIRE NO. 8 AND SMALLER FOR USE IN INTERIOR DRY LOCATIONS SHALL BE TYPE THHN/THWN THERMOPLASTIC 600 VOLT INSULATED COPPER CONDUCTORS. FEEDERS AND POWER WIRING NO. 6 AND LARGER SHALL BE TYPE THHN, 600 VOLT INSULATED COPPER. WIRE INSTALLED IN RACEWAY IN MOIST OR DAMP LOCATIONS SHALL BE TYPE XHHW, 600 VOLT INSULATED COPPER CONDUCTORS. NO WIRE SMALLER THAN NO. 12 AWG SHALL BE USED FOR LIGHTING OR POWER WIRING. WIRE NO. 10 AND SMALLER MAY BE SOLID OR STRANDED. WIRE NO. 8 AND LARGER SHALL BE STRANDED. ALL WIRING CONDUCTORS SHALL BE COPPER. NO ALUMINUM IS ALLOWED.
- PROVIDE TYPED DIRECTORIES FOR ALL PANEL BOARDS. ALL PANEL BOARDS SHALL HAVE PERMANENT IDENTIFICATION PLAQUES INSTALLED.
- EACH SWITCH, LIGHT, RECEPTACLE AND OTHER MISCELLANEOUS DEVICE SHALL BE PROVIDED WITH A GALVANIZED OR SHERARIZED PRESSED STEEL OUTLET BOX OF THE KNOCKOUT TYPE OF NOT LESS THAN NO. 14 US GAUGE STEEL. CONDUITS SHALL BE FASTENED WITH LOCK NUTS AND BUSHINGS AND ALL UNUSED KNOCKOUTS MUST BE LEFT SEALED. THERE MUST BE SUFFICIENT ROOM FOR WIRES AND BUSHINGS AND DEEP BOXES SHALL BE INSTALLED WHERE REQUIRED. BOXES SHALL BE SECURELY AND ADEQUATELY SUPPORTED.
- CONTRACTOR SHALL WIRE TO, SET AND CONNECT ALL MOTORS, CONTROLS AND EQUIPMENT. PROVIDE LOCAL DISCONNECT SWITCHES FOR ALL MOTORS. THE OVERCURRENT DEVICE RATING FOR EACH MOTOR SHALL BE PER MANUFACTURERS RECOMMENDATIONS.
- ALL PANEL BOARDS SHALL BE STANDARD DEE-FRONT, WITH SIZE AND NUMBER OF SINGLE AND MULTIPOLE BREAKERS AS INDICATED OR REQUIRED WITH MAIN LUGS AS INDICATED. BUS MAINS SHALL BE COPPER, RATED FOR SYSTEM VOLTAGE AND FEEDER SIZE AS INDICATED. PANELBOARDS SHALL BE COMPLETE WITH TRIMLOCKING DOOR, CONSEALED HINGES, DIRECTORY FRAME. ALL PANELBOARDS SHALL HAVE DISTRIBUTED BUSSING AND SEQUENCE NUMBERING. ALL PANELS AND BREAKERS SHALL BE SQUARE D, ITE, G.E. OR CUTLER HAMMER. NO OTHER ACCEPTABLE.
- ELECTRICAL CONTRACTOR SHALL COORDINATE WORK WITH LOCAL TELEPHONE COMPANY AND, IF REQUIRED, FURNISH AND/OR INSTALL CONDUITS, OUTLETS, DEVICE PLATES, PLYWOOD BACKBOARDS, ETC. FOR PHONE WIRING. GROUND TELEPHONE SERVICE TO COLD WATER LINE AS REQUIRED BY TELEPHONE COMPANY.
- ELECTRICAL CONTRACTOR SHALL LEAVE HIS WORK IN PERFECT OPERATING CONDITION AND SHALL GUARANTEE SAME FOR A PERIOD OF TWELVE (12) MONTHS FROM DATE OF FINAL ACCEPTANCE.

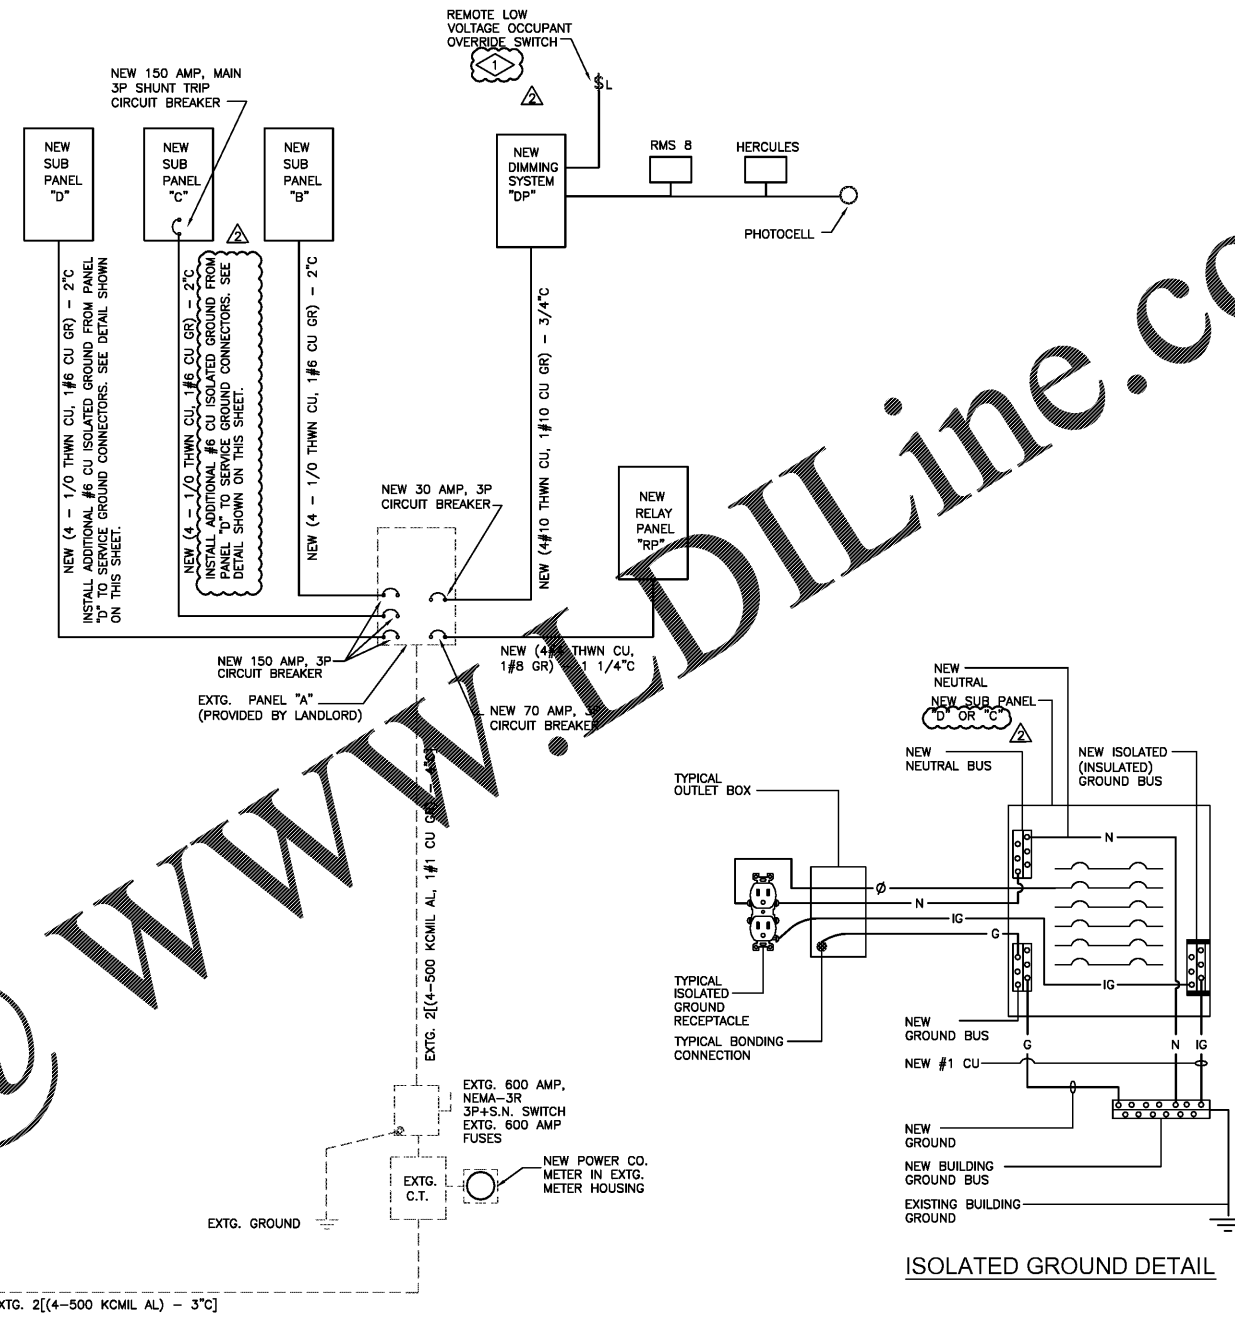

DIMMING PANEL DIAGRAM


NOTE ON MAXIMUM AVAILABLE FAULT CURRENT FIELD MARKINGS:
ELECTRICAL CONTRACTOR SHALL FIELD MARK ALL SERVICE EQUIPMENT WITH THE MAXIMUM AVAILABLE FAULT CURRENT AND THE DATE THE FAULT CURRENT CALCULATION WAS PERFORMED. REFER TO ELECTRICAL DRAWINGS FOR THE DATE OF CALCULATION. FIELD MARKINGS SHALL COMPLY WITH NEC 110.24

NOTE ON MAXIMUM AVAILABLE FAULT CURRENT FIELD MARKINGS:

ELECTRICAL CONTRACTOR SHALL FIELD MARK ALL SERVICE EQUIPMENT WITH THE MAXIMUM AVAILABLE FAULT CURRENT AND THE DATE THE FAULT CURRENT CALCULATION WAS PERFORMED. REFER TO ELECTRICAL DRAWINGS FOR THE DATE OF CALCULATION. FIELD MARKINGS SHALL COMPLY WITH NEC 110.24

Order Plans @

WWW.DILine.com

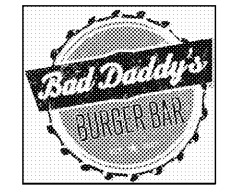

GOOD TIMES RESTAURANTS, INC.
141 Union Blvd, Suite 400
Lakewood, CO 80226
303-384-1430

BAD DADDY'S BURGER BAR
"SANDY PLAINS"
3460 SANDY PLAINS RD N.E.
SUITE 110
MARIETTA, GA 30062

Issue Record:	
6.7.2019	FOR PLAN REVIEW

Revised:
08.28.2019 QCR

Drawn:
DRAWN BY: WR

Checked:
CHECKED BY: WR

Project No.
PROJECT#: 19-213

Contractor:
ONE LINE DIAGRAM

E5.0