

SHEET NOTES - AS-BUILT PLAN:

A. THESE PLANS REPRESENT THE CURRENT CONDITION AND CONFIGURATION OF THE 3 EXISTING SUITES BEING COMBINED INTO 1 SINGLE TENANT SUITE. ALL CONTRACTORS SHOULD CONDUCT THEIR OWN ON-SITE INSPECTION AND CONFIRM EXISTING CONDITIONS. ANY DEVIATIONS FROM THE PLANS SHOWN HERE SHOULD BE DEVOTED IN WRITING TO THE OWNER AND DESIGN FIRM; AND ALL CONTRACTOR PRICING SHOULD REFLECT THE NECESSARY SCOPE TO COMPLETE THE RENOVATION SET FORTH IN THESE DOCUMENTS.

CROSSFIELDS
 CHIROPRACTIC OFFICE DESIGN

3265 Spangue Parkway Suite 3015
 Marietta, GA 30066
 Office: 770.434.9020
 Web: www.ChiropracticOfficeDesign.com

THIS DRAWING IS THE PROPERTY OF CROSSFIELDS, INC. AND ANY REPRODUCTION OR COPYING OF THIS DRAWING, IN WHOLE OR PART IS PROHIBITED WITHOUT WRITTEN PERMISSION.

**INNOVATION
 COMPOUNDING
 DR. SHAWN HODGES**
 6095 PINE MOUNTAIN RD. SUITE 104
 KENNESAW, GA 30152


REVISIONS:

NO.	DATE	DESCRIPTION

DRAWN BY: LEB/SEB CHECKED BY: CMB/SEB
 DATE: 09.24.19
 PROJECT NUMBER: 17125-IC
 SHEET NO:

A-0.5

FOR PERMIT

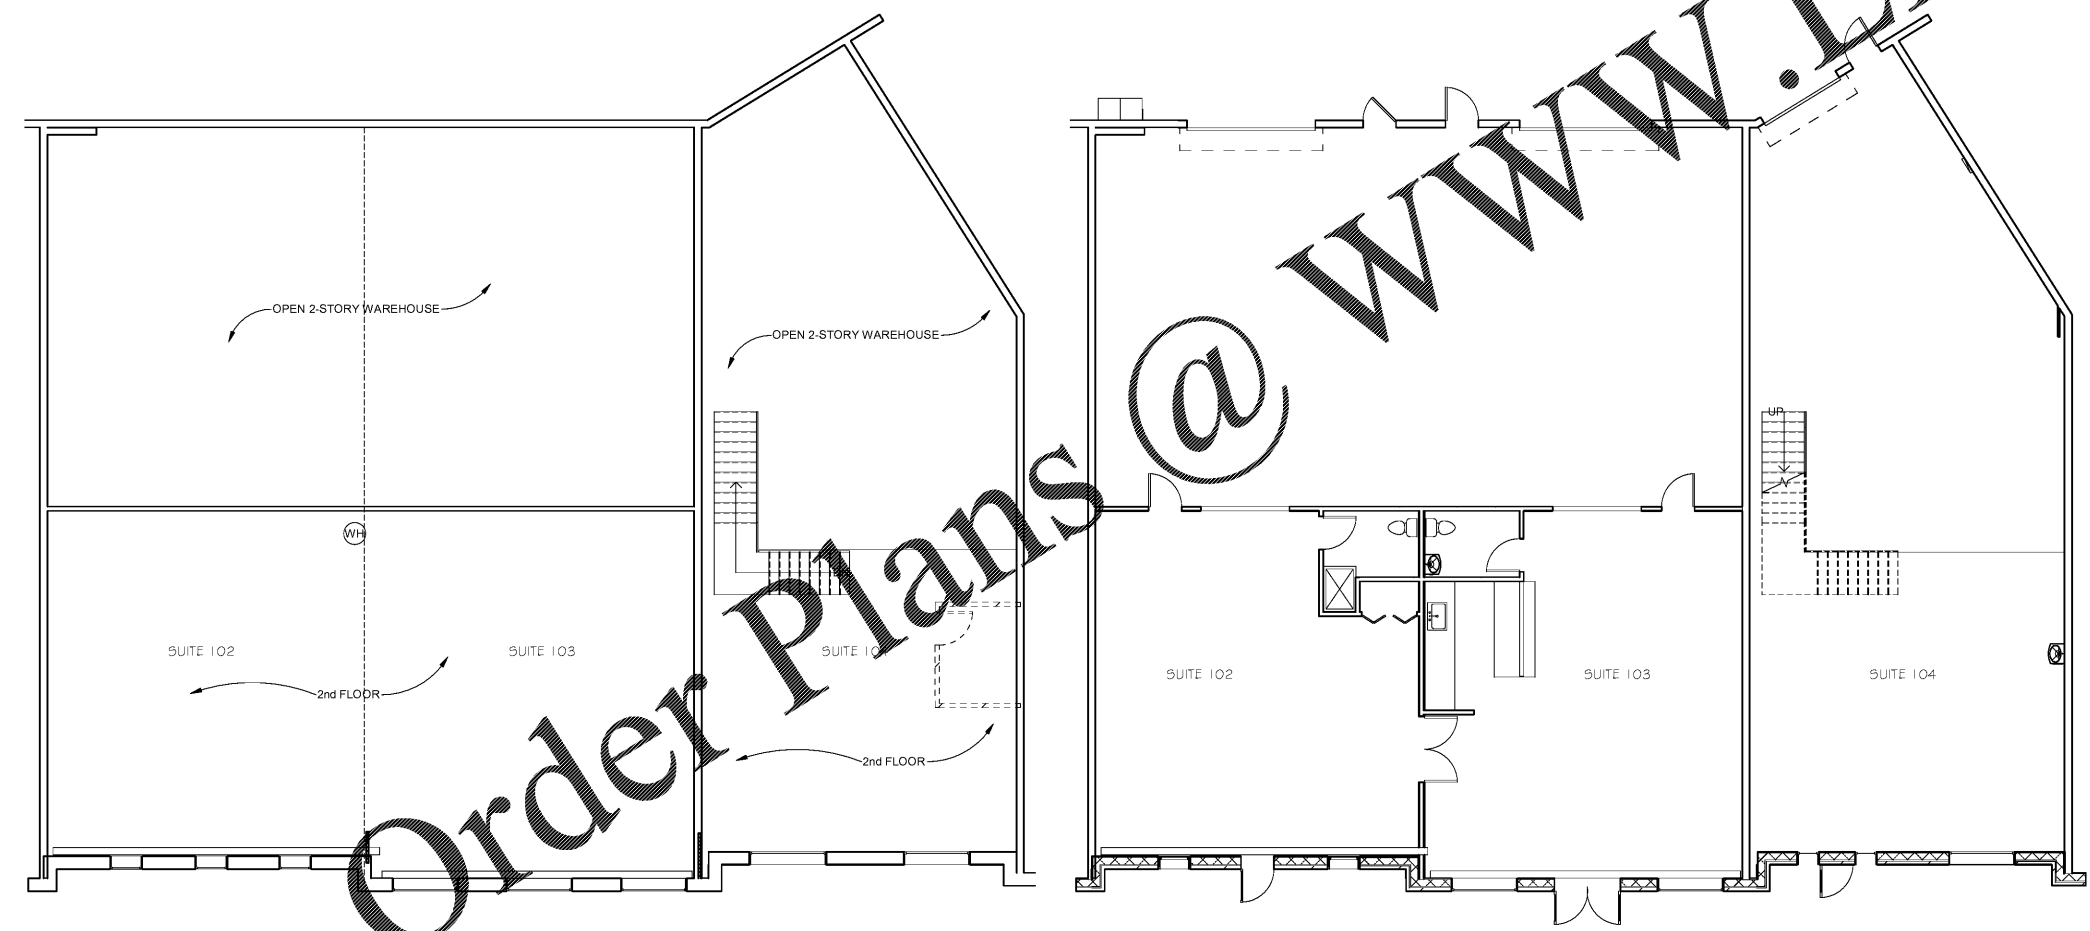

2 LEVEL 2 AS-BUILTS
 A-0.5 1/8" = 1'-0"

1 LEVEL 1 AS-BUILTS
 A-0.5 1/8" = 1'-0"