
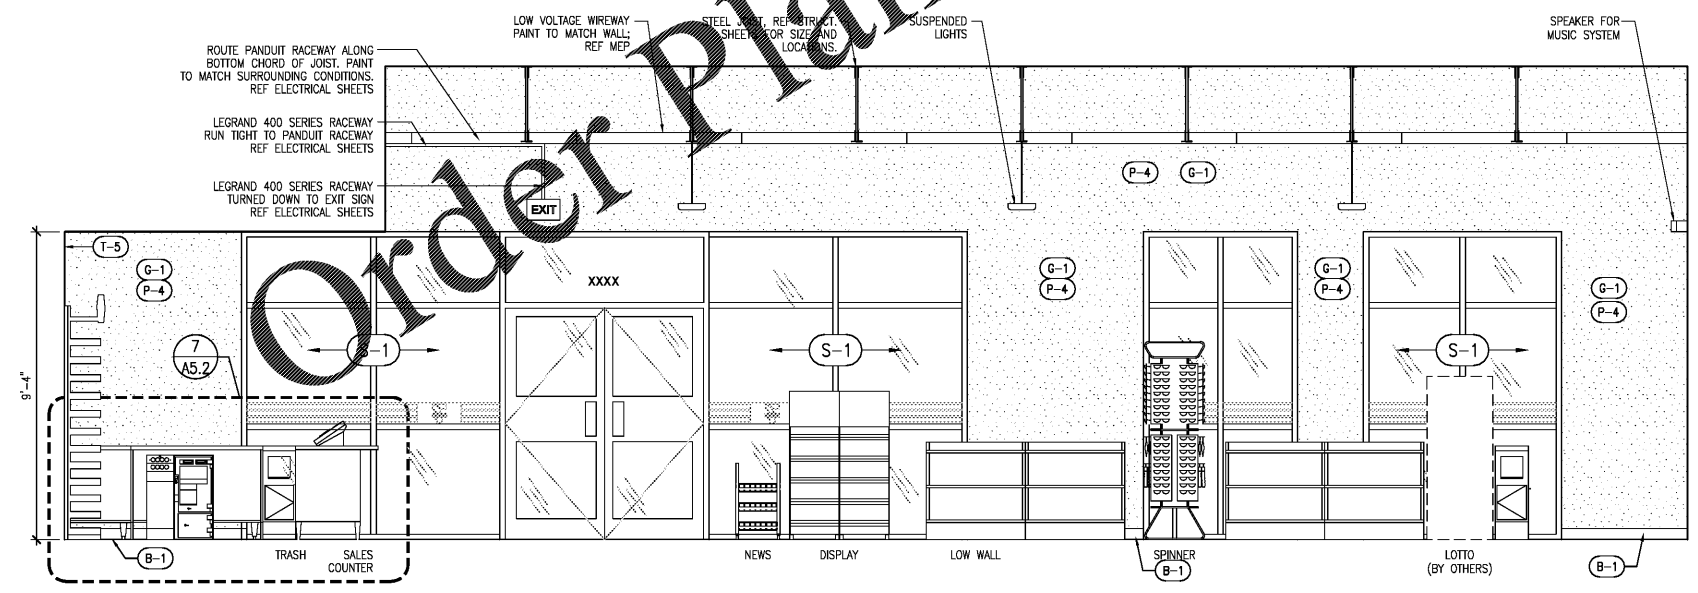
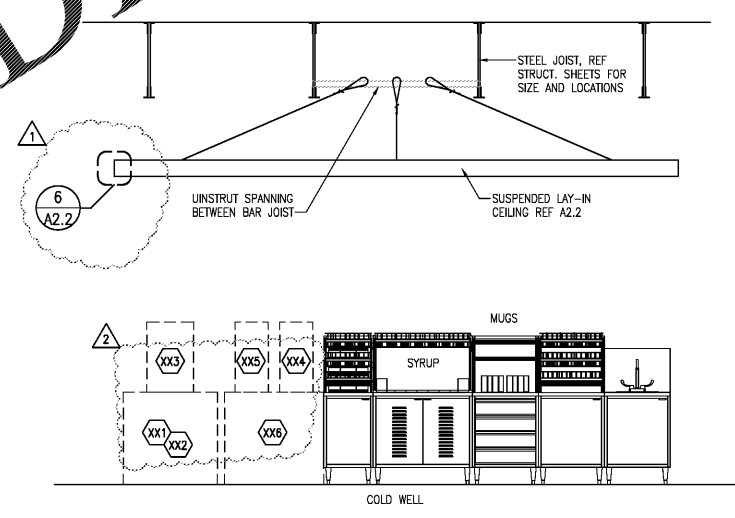
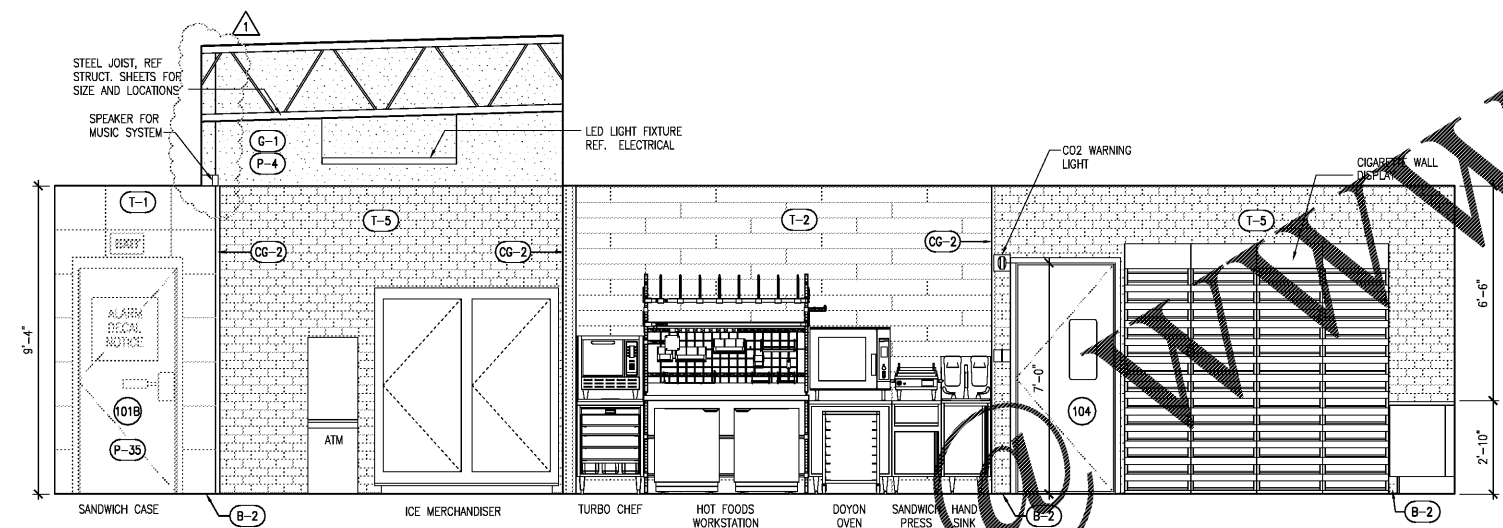
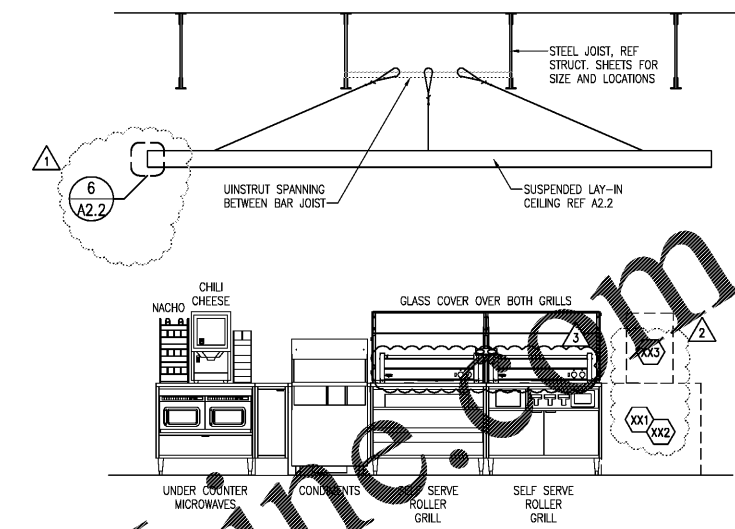



SEAL:
 THIS DOCUMENT IS NOT
 FOR REGULATORY
 APPROVAL, PERMITTING,
 OR CONSTRUCTION.

FOR BIDDING ONLY
 09/03/2020

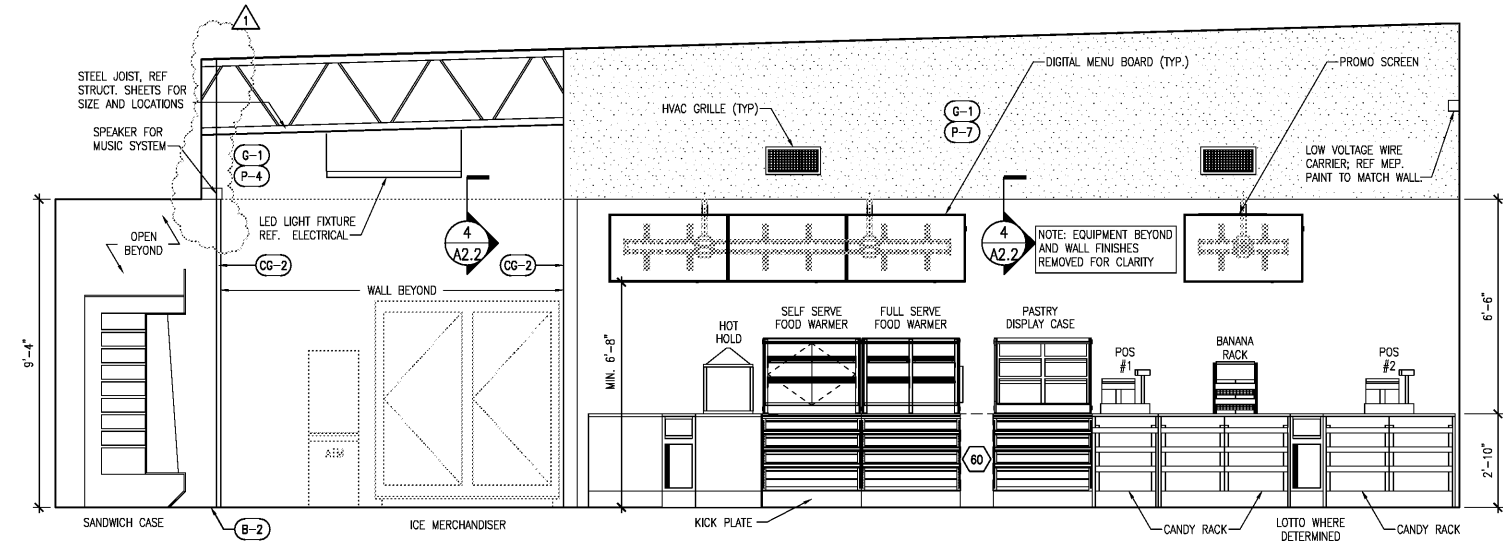

GENERAL NOTES

- A. REFERENCE SHEET A3.0 FOR ALL FINISH SCHEDULE.
- B. REFERENCE ELECTRICAL SHEETS FOR RECEPTACLES LOCATIONS AND HEIGHTS.
- C. ALL COUNTER SHALL BE 34" AFF UNLESS OTHERWISE NOTED.

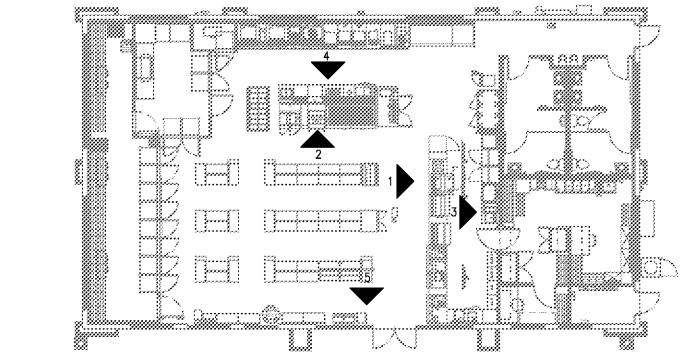

REVISIONS

3	08/28/20	PEER COMMENTS
2	07/30/20	PEER REVIEW COMMENTS
1	04/27/20	PEER COMMENTS
	NO DATE	REMARKS



7-ELEVEN
 STORE #41559

1245 S. VOLUSIA AVENUE
 Orange City, FL 32763

PROJECT NO: 2019.0743
 DATE: APRIL 7, 2020

A5.1
 INTERIOR ELEVATIONS

CHECKED: RW DRAWN: JM