



Order Plans @ www.LDILine.com

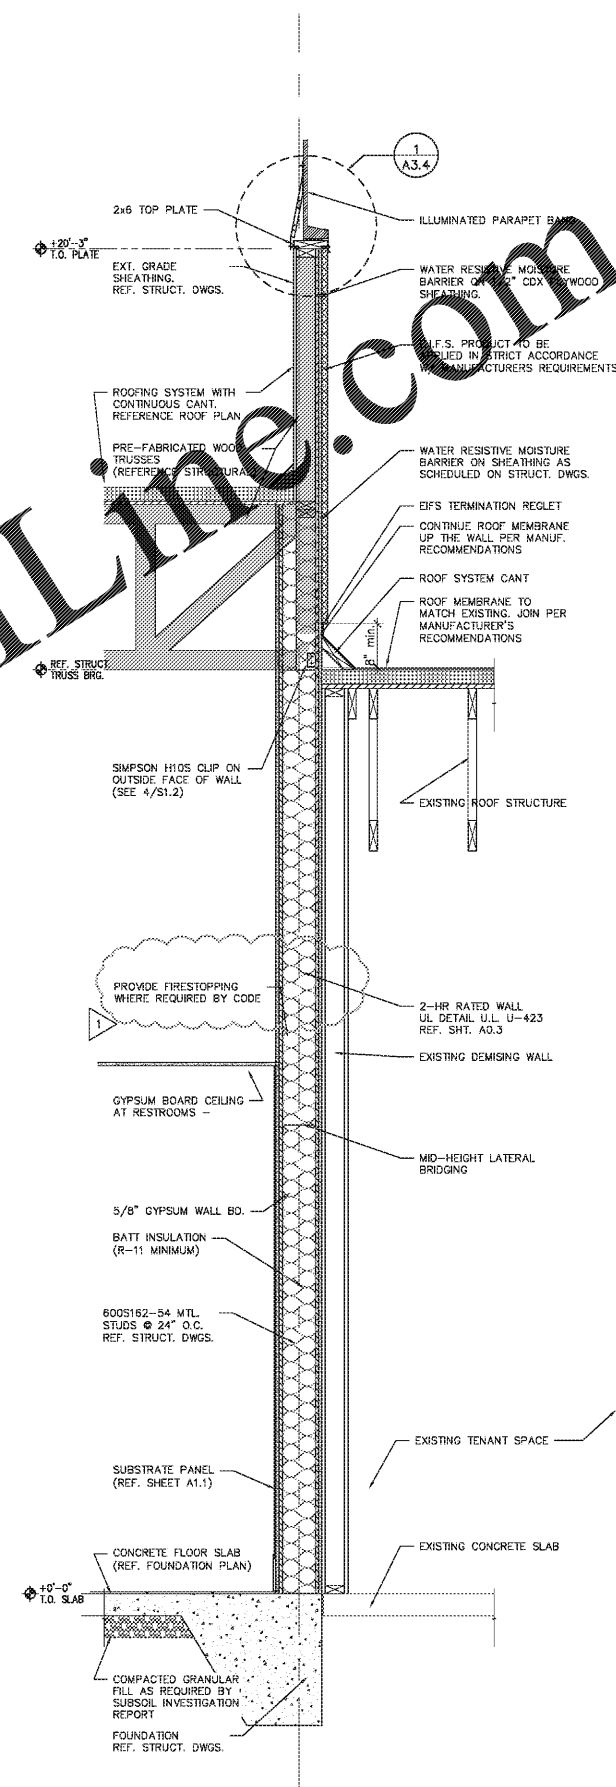

1 WALL SECTION
A3.2 SCALE: 3/4" = 1'-0"

ROBERTSON LOIA ROOF ARCHITECTS & ENGINEERS
3460 Preston Ridge Road · Suite 275 · Alpharetta, Georgia 30005
770-674-2600 · Fax 678-319-0745

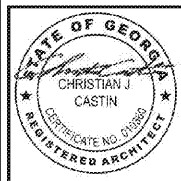

PALMETTO BURGER KING
9165 ROOSEVELT HWY, PALMETTO, GA.
FOR **JP DESIGN & CONSTRUCTION**
JACKSON, GA.

REVISIONS
12/01/20 PLAN REVIEW COMMENTS

SHEET TITLE
WALL SECTIONS

DATE	10-30-20
PROJECT NUMBER	20-197
SHEET NUMBER	A3.3