



Lancaster County, South Carolina
Indian Land Soccer Complex



10167 Harrisburg Road
Indian Land, SC 29707

Revisions:
△ PER REVIEW COMMENTS- 1 01/19/2021


Proj. No.: 80702
Date: 10/13/2020

Sheet Name:
Add Alternates
Plan

L-201

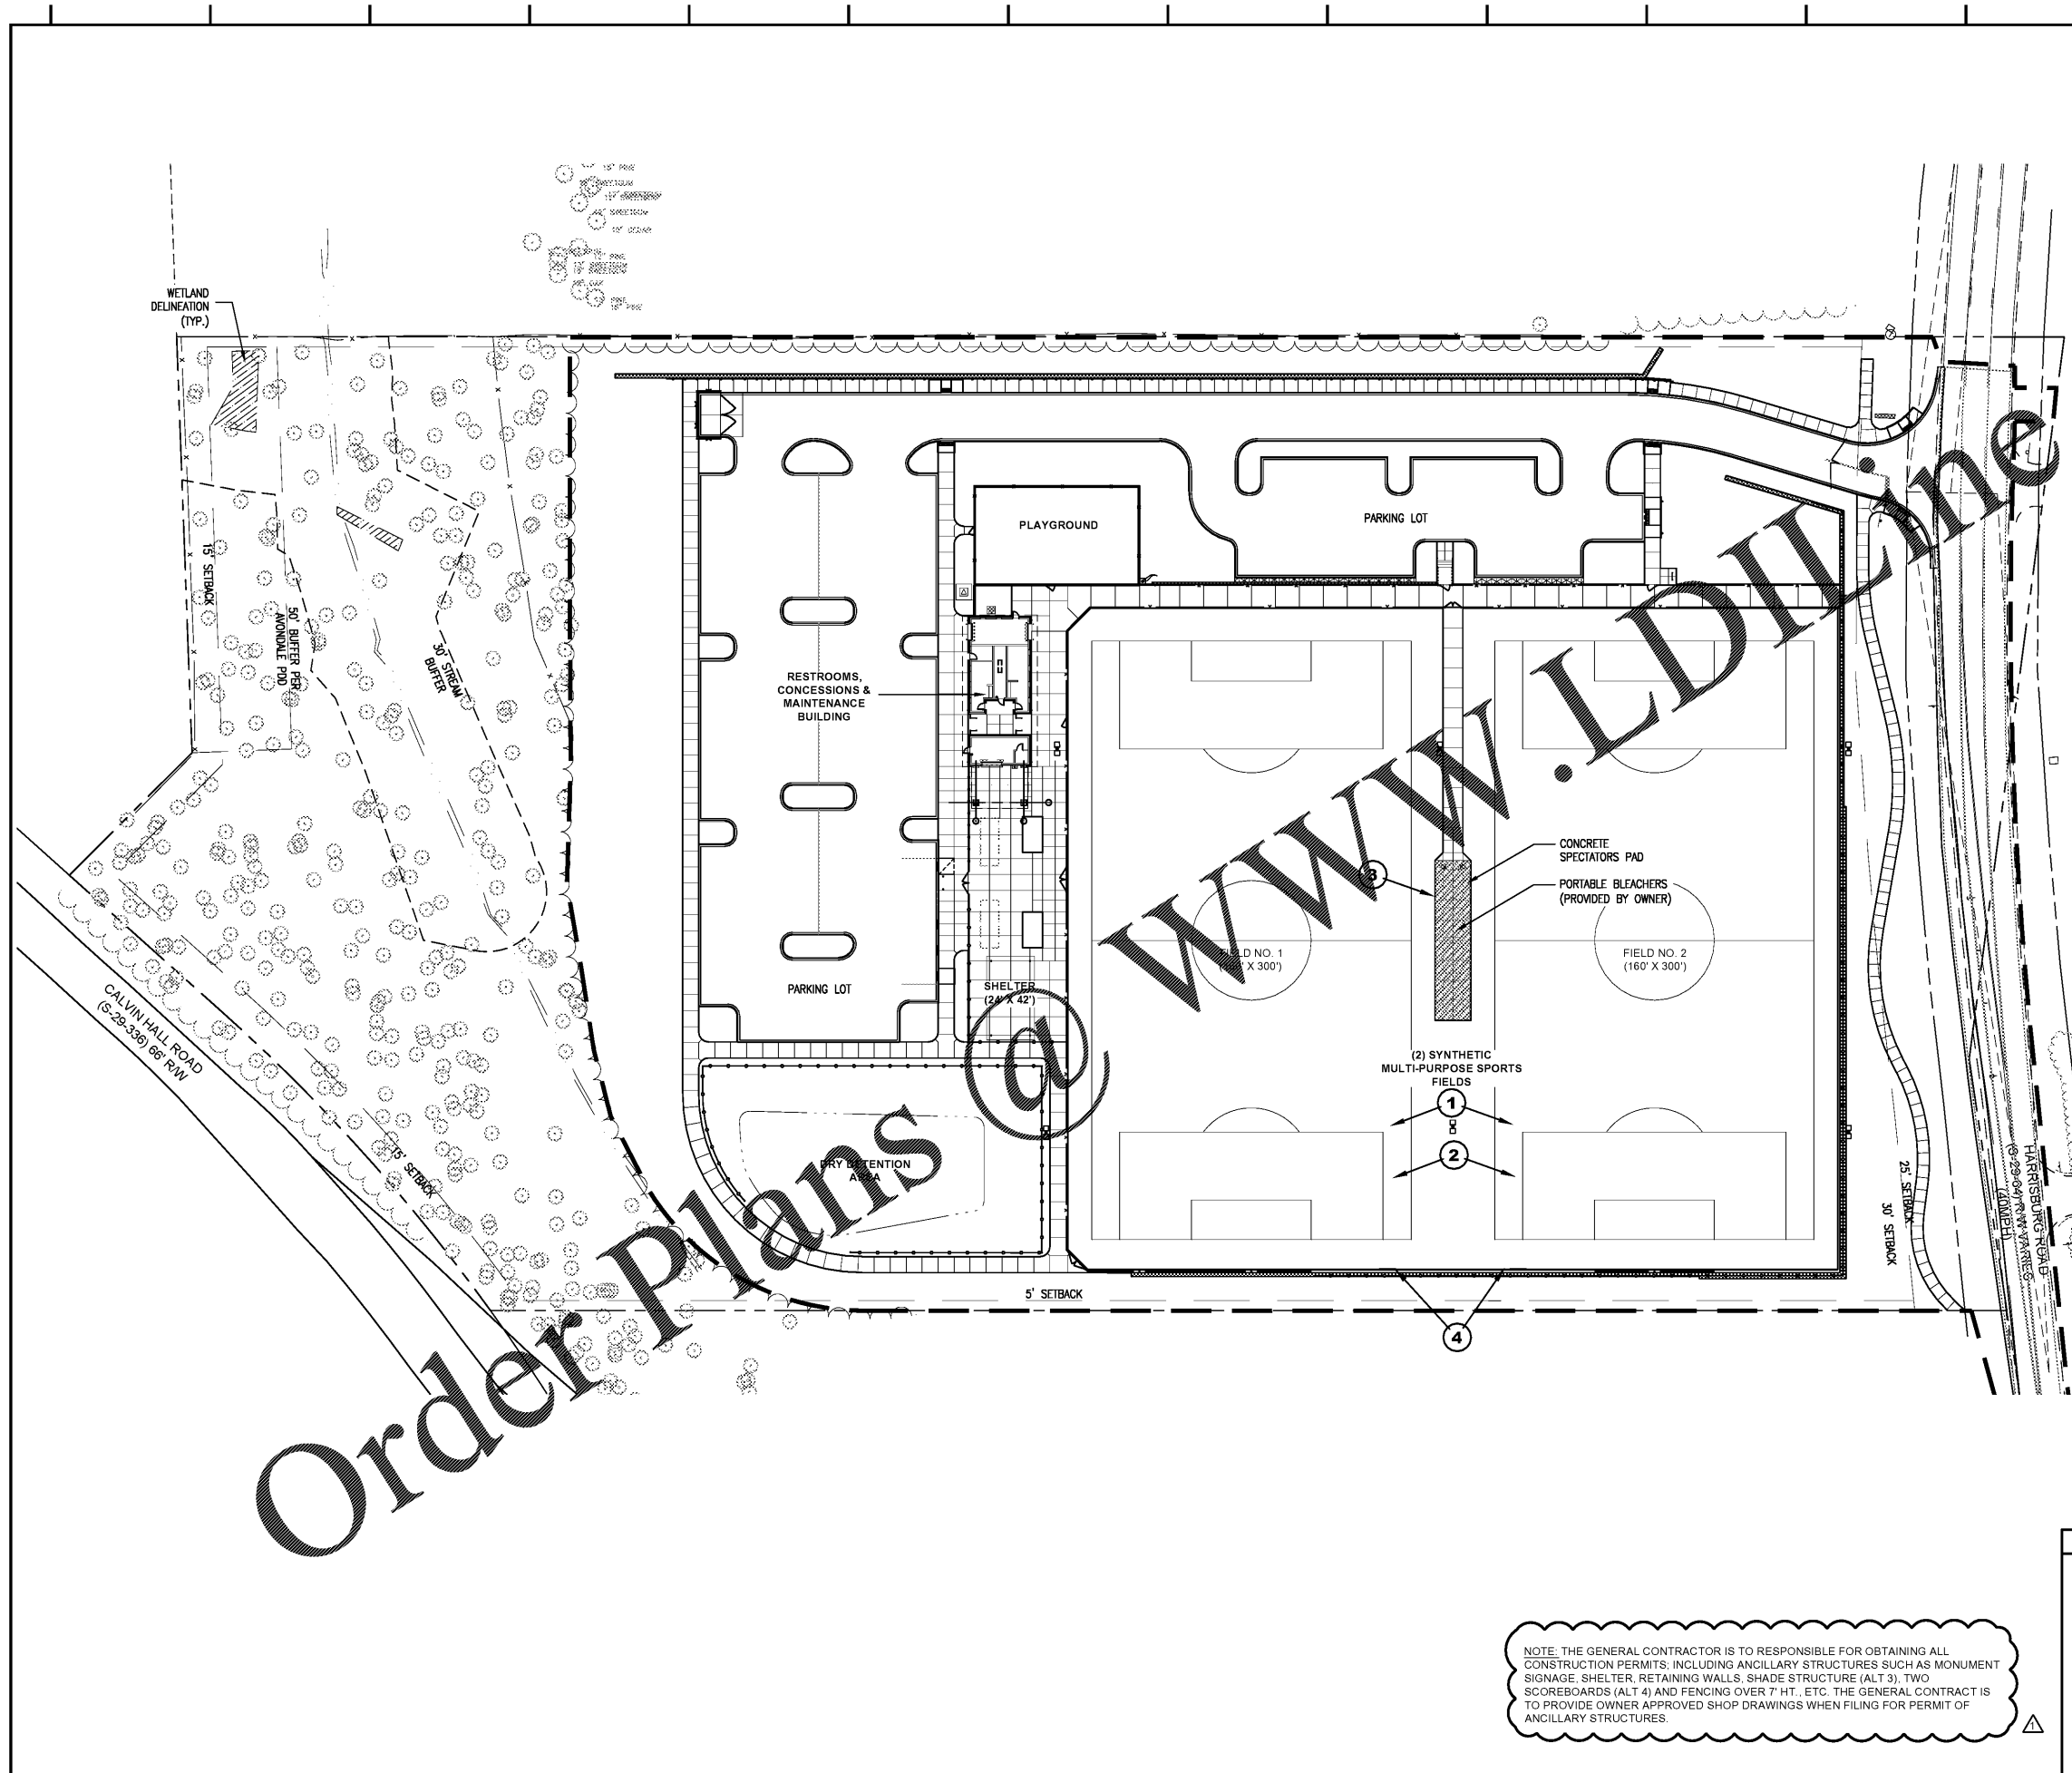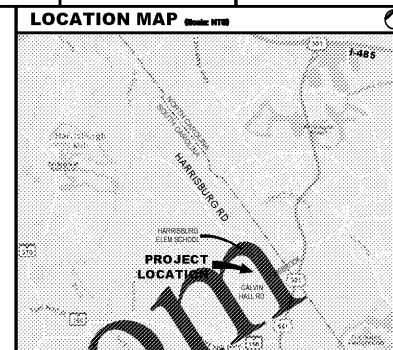

Order Plans @ www.LDPlans.com

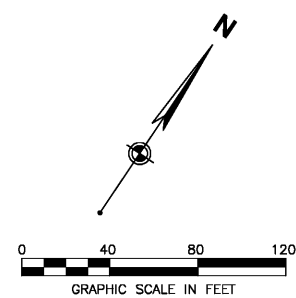

NOTE: THE GENERAL CONTRACTOR IS TO BE RESPONSIBLE FOR OBTAINING ALL CONSTRUCTION PERMITS, INCLUDING ANCILLARY STRUCTURES SUCH AS MONUMENT SIGNAGE, SHELTER, RETAINING WALLS, SHADE STRUCTURE (ALT 3), TWO SCOREBOARDS (ALT 4) AND FENCING OVER 7' HT., ETC. THE GENERAL CONTRACTOR IS TO PROVIDE OWNER APPROVED SHOP DRAWINGS WHEN FILING FOR PERMIT OF ANCILLARY STRUCTURES.

SUMMARY OF ADD ALTERNATES	
ALTERNATE NO. 1	BASE BID TURF SYSTEM USING PREFERRED BROCK PAD
ALTERNATE NO. 2	BASE BID TURF SYSTEM USING 100% NATURAL INFILL (new)
ALTERNATE NO. 3	SHADE STRUCTURE - OVER 18'x80' CENTER CONCRETE PAD IN BETWEEN SYNTHETIC FIELDS
ALTERNATE NO. 4	TWO SCOREBOARDS WITH A WIRELESS CONTROLLER: (1) SCOREBOARD AT EACH FIELD. ENSURE ELECTRICAL PANEL HAS ROOM FOR ADDITIONAL LOAD. CONDUIT IN BASE BID.