

Lancaster County, South Carolina
Indian Land Soccer Complex


10167 Harrisburg Road
Indian Land, SC 29707

Revisions:
PER REVIEW COMMENTS-1 01/15/21

Proj. No.: 80702
Date: 10/13/2020

Sheet Name:
Grading
Enlargement
& Drainage Details

L-508

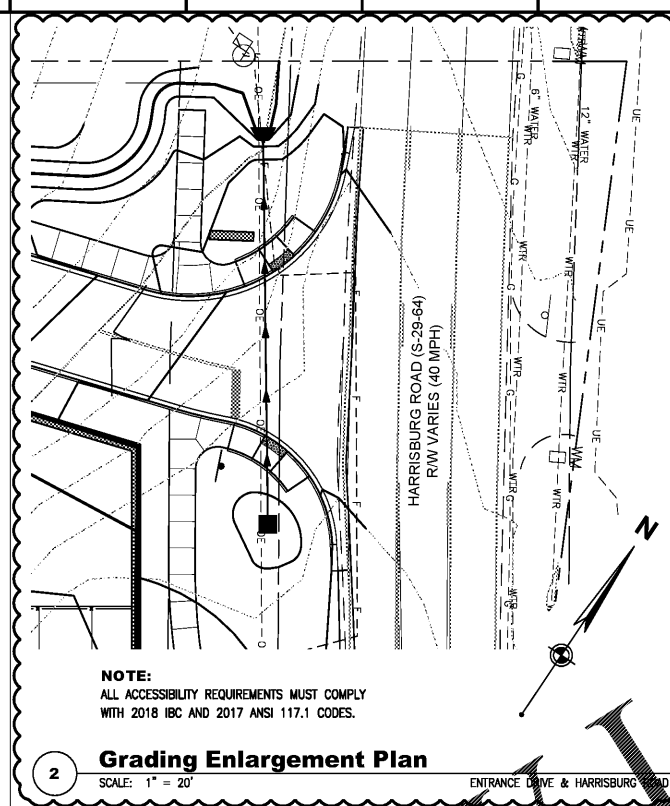


NOTE:
ALL ACCESSIBILITY REQUIREMENTS MUST COMPLY WITH 2018 IBC AND 2017 ANSI 117.1 CODES.

2 Grading Enlargement Plan

SCALE: 1" = 20'

ENTRANCE DRIVE & HARRISBURG ROAD

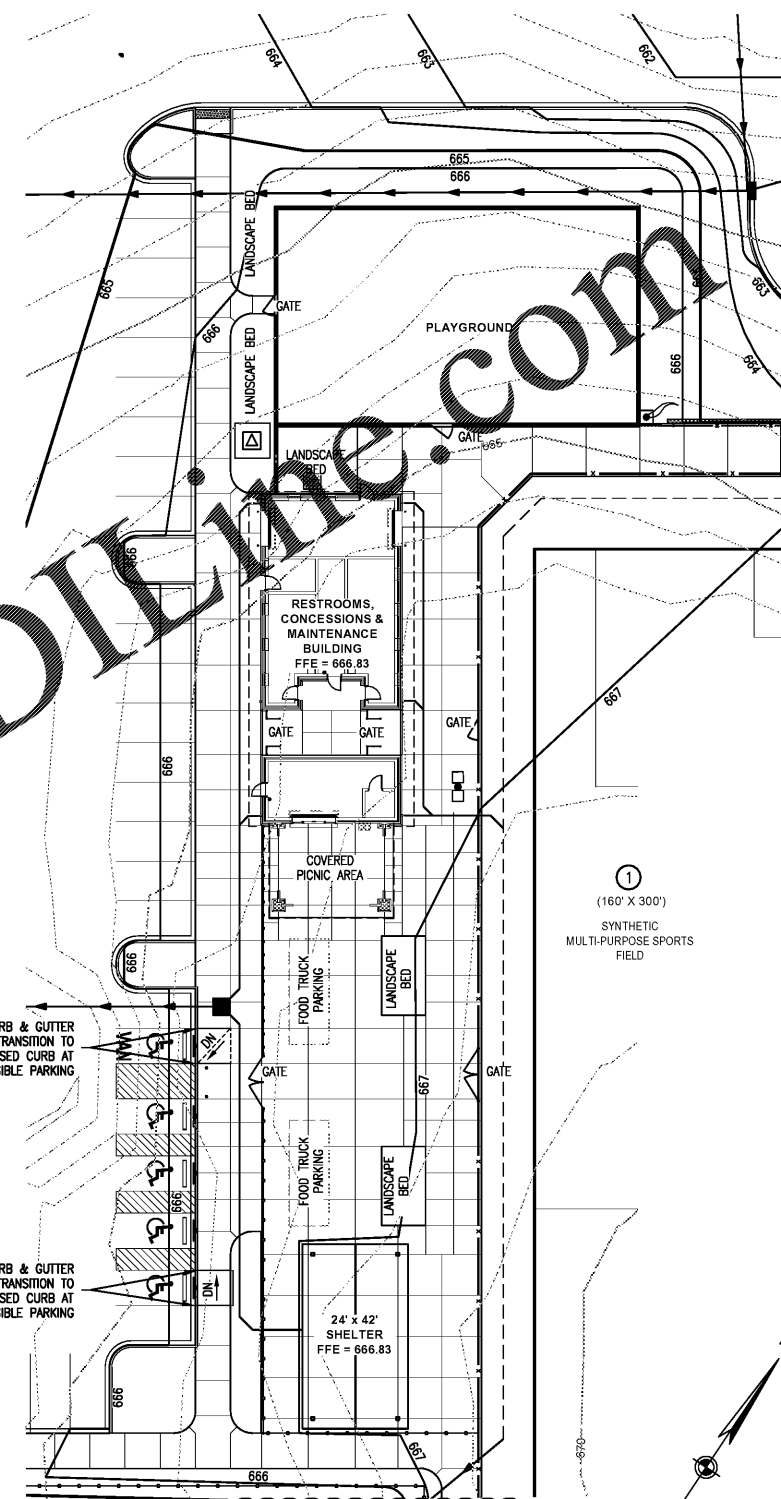



NOTE:
ALL ACCESSIBILITY REQUIREMENTS MUST COMPLY WITH 2018 IBC AND 2017 ANSI 117.1 CODES.

EXISTING		NEW	
	TREE (6" OR LARGER)		PLAYGROUND SURFACE
	SIGN		CONCRETE PAVEMENT
	TREE LINE		LIGHT DUTY ASPHALT PAVEMENT
	VEGETATION		HEAVY DUTY ASPHALT PAVEMENT
	CONTOUR LINE		CURB INLET
			CATCH BASIN
			STORM PIPE
			COLLECTOR DRAIN
			TREE LINE
			CONTOUR LINE
			SPOT ELEVATION-
			• HIGH PT (HP)
			• TOP/BOTTOM OF CURB (TC/BC)

1 Grading Enlargement Plan

SCALE: 1" = 20'

PLAZA & PLAYGROUND

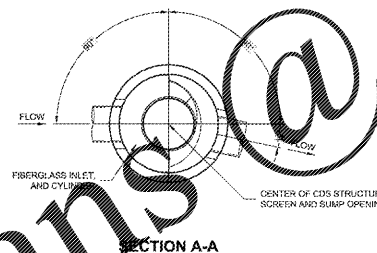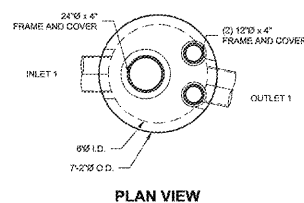

QUANTITY	DESCRIPTION	UNIT	INSTALLER
1	FIBERGLASS INLET AND CYLINDER		CONTECH
1	2400 HERRICK 3\"/>		

SITE DESIGN DATA	
WATER QUALITY FLOW RATE	3.58 CFS
PEAK FLOW RATE	10.91 CFS
RETURN PERIOD OF PEAK FLOW	10 YRS

GENERAL NOTES:
1. CONTRACTOR TO PROVIDE ALL MATERIALS UNLESS NOTED OTHERWISE.
2. FOR FABRICATION DRAWINGS WITH DETAILED STRUCTURE DIMENSIONS AND WEIGHT, PLEASE CONTACT YOUR CONTECH ENGINEERED SOLUTIONS LLC REPRESENTATIVE. www.conteches.com
3. CDS WATER QUALITY STRUCTURE SHALL BE IN ACCORDANCE WITH ALL DESIGN DATA AND INFORMATION CONTAINED IN THIS DRAWING. CONTRACTOR TO CONFIRM STRUCTURE MEETS REQUIREMENTS OF PROJECT.
4. STRUCTURE SHALL MEET AASHTO HS-20 LOAD RATING, ASSUMING EARTH COVER OF 1'-2\"/>


INSTALLATION NOTES:
A. ANY SURFACE BACKFILL DEPTH AND/OR WITH FLOTATION PROVISIONS ARE SITE SPECIFIC DESIGN CONSIDERATIONS AND SHALL BE SPECIFIED BY ENGINEER OF RECORD.
B. CONTRACTOR TO PROVIDE EQUIPMENT WITH SUFFICIENT LIFTING AND REACH CAPACITY TO LIFT AND SET THE CDS MARKOLE STRUCTURE.
C. CONTRACTOR TO INSTALL JOINT SEALANT BETWEEN ALL STRUCTURE SECTIONS AND ASSEMBLE STRUCTURE.
D. CONTRACTOR TO PROVIDE, INSTALL, AND GROUT INLET AND OUTLET PIPES. MATCH PIPE INVERTS WITH ELEVATIONS SHOWN. ALL PIPE CENTERLINES TO MATCH PIPE OPENING CENTERLINES.
E. CONTRACTOR TO TAKE APPROPRIATE MEASURES TO ASSURE UNIT IS WATER TIGHT, HOLDING WATER TO FLOWLINE INVERT MINIMUM. IT IS SUGGESTED THAT ALL JOINTS BELOW PIPE INVERTS ARE GROUTED.

STRUCTURE WEIGHT:
APPROXIMATE WEIGHT PER PIECE = 16500 LBS.
STRUCTURE IS DELIVERED IN 4 PIECES.

MAX FOOTPRINT = 37'-2"

CONTECH
PROPOSAL
DRAWING

NO.	DATE	DESCRIPTION
1	10/14/20	ISSUED FOR BIDDING
2	10/14/20	ISSUED FOR BIDDING
3	10/14/20	ISSUED FOR BIDDING
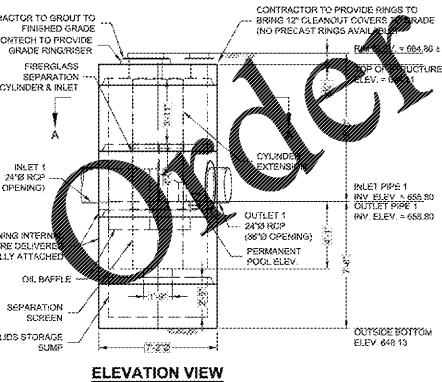

ELEVATION VIEW