

**PLANT SCHEDULE**

KEY	QUANTITY	SCIENTIFIC NAME	COMMON NAME	SIZE	SPECIFICATION	REMARKS
<b>TREES - CANOPY</b>						
QF	5	QUERCUS FALCATA	SOUTHERN RED OAK	2.5" CAL. MIN.	B&B	STRONG CENTRAL LEADER (NO CO-DOMINANT STEMS); TYPICAL IN SPECIES HABIT; GOOD LIVING CONDITION
QC	10	QUERCUS COCCINEA	SCARLET OAK	2.5" CAL. MIN.	B&B	STRONG CENTRAL LEADER (NO CO-DOMINANT STEMS); TYPICAL IN SPECIES HABIT; GOOD LIVING CONDITION
BN	5	"DURA HEAT" RIVER BIRCH	BETULA NIGRA 'BNMTF'	10'-12' MIN.	B&B	THREE STEMS/TRUNKS; TYPICAL IN SPECIES HABIT; GOOD LIVING CONDITION
LT	3	LIRIODENDRON TULIPIFERA	TULIP POPLAR	2.5" CAL. MIN.	B&B	STRONG CENTRAL LEADER (NO CO-DOMINANT STEMS); TYPICAL IN SPECIES HABIT; GOOD LIVING CONDITION
QN	5	QUERCUS NUTTALLII	NUTTALL OAK	2.5" CAL. MIN.	B&B	STRONG CENTRAL LEADER (NO CO-DOMINANT STEMS); TYPICAL IN SPECIES HABIT; GOOD LIVING CONDITION
PT	3	PINUS TAEDA	LOBLOLLY PINE	2.5" CAL. MIN.	B&B	STRONG CENTRAL LEADER (NO CO-DOMINANT STEMS); TYPICAL IN SPECIES HABIT; GOOD LIVING CONDITION
JV	3	JUNIPERUS VIRGINIANA	EASTERN RED CEDAR	2.5" CAL. MIN.	B&B	STRONG CENTRAL LEADER (NO CO-DOMINANT STEMS); TYPICAL IN SPECIES HABIT; GOOD LIVING CONDITION
<b>TREES - UNDERSTORY</b>						
AP	7	AESCULUS PARVIFLORA	BOTTLEBRUSH BUCKEYE	8'-10' HT. MIN.	#25G OR B&B	THREE TO FIVE STEMS/TRUNKS; TYPICAL IN SPECIES HABIT; GOOD LIVING CONDITION
CV	19	CHIONANTHUS VIRGINICUS	FRINGE TREE	8'-10' HT. MIN.	#25G OR B&B	THREE TO FIVE STEMS/TRUNKS; TYPICAL IN SPECIES HABIT; GOOD LIVING CONDITION
CC	12	CERCIS CANADENSIS	EASTERN REDBUD	2.5" CAL., 8' HT. MIN.	#25G OR B&B	ROUNDED CROWN; PRUNED TO 'U'-SHAPE CROTCH ANGLES, NOT 'V'
CF	7	CORNUS FLORIDA	DOGWOOD	2.5" CAL., 8' HT. MIN.	B&B	STRONG CENTRAL LEADER (NO CO-DOMINANT STEMS); TYPICAL IN SPECIES HABIT; GOOD LIVING CONDITION
OA	9	OXYDENRUM ARBOREUM	SOURWOOD	2.5" CAL., 8' HT. MIN.	#25G OR B&B	STRONG CENTRAL LEADER (NO CO-DOMINANT STEMS); TYPICAL IN SPECIES HABIT; GOOD LIVING CONDITION
IO	4	ILEX OPACA	AMERICAN HOLLY	2.5" CAL., 8' HT. MIN.	#25G OR B&B	STRONG CENTRAL LEADER (NO CO-DOMINANT STEMS); TYPICAL IN SPECIES HABIT; GOOD LIVING CONDITION
<b>SHRUBS</b>						
AG	84	ABELIA X GRANDIFLORA	GLOSSY ABELIA	18" HT. MIN.	#3G	FULLNESS OF BRANCHING
CS	5	CAMELLIA SASANQUA	SASANQUA CAMELLIA	36" HT. MIN.	#5G - #7G	FULLNESS OF BRANCHING TO THE GROUND
IG	162	ILEX GLABRA 'SHAMROCK'	INKBERRY HOLLY	36" HT. MIN.	#5G - #7G	FULLNESS OF BRANCHING TO THE GROUND
HQ	15	HYDRANGEA QUERCIFOLIA 'DOUGHILL'	GATSBY STAR OAKLEAF HYDRANGEA	36" HT. MIN.	#5G - #7G	FULLNESS OF BRANCHING TO THE GROUND
IV	208	ILEX VOMITORIA 'NANA'	YAUPON HOLLY	18" HT. MIN.	#3G	FULLNESS OF BRANCHING
IP	17	ILLICLIUM PARVIFLORUM 'SUNSHINE'	SUNSHINE SMALL ANISE TREE	36" HT. MIN.	#5G - #7G	FULLNESS OF BRANCHING TO THE GROUND
MO	35	PITOSPORUM TOBIRA 'VARIEGATA'	VARIEGATED MOCKORANGE	36" HT. MIN.	#5G - #7G	FULLNESS OF BRANCHING TO THE GROUND
<b>GRASSES AND GROUNDCOVERS</b>						
LM	532	LIRIOPE MUSCARI 'BIG BLUE'	BIG BLUE LILY TURF	6"	1G	SPECIMEN, FLATS OF 18
MC	79	MUHLENBERGIA CAPILLARIS	MUHLIY GRASS	6"	1G	SPECIMEN
PV	75	PANICUM VIRGATUM	SWITCH GRASS	24"	3G	SPECIMEN


PLANT LIST IS SUPPLIED FOR CONVENIENCE ONLY. CONTRACTOR IS RESPONSIBLE FOR ALL QUANTITIES ON THE PLAN.

**PLANT SCHEDULE**

NTS


THIS DETAIL APPLIES TO BOTH SINGLE-STEM AND MULTI-STEM TREES.

OPTIONAL: PLANTING SHALL NOT EXCEED 2.5 FEET SET BACK TO VERTICAL POSITION FROM TO EXISTING

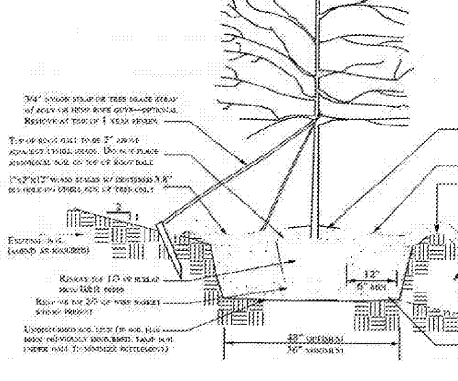


**PLANTING ON A SLOPE DETAIL**

NTS

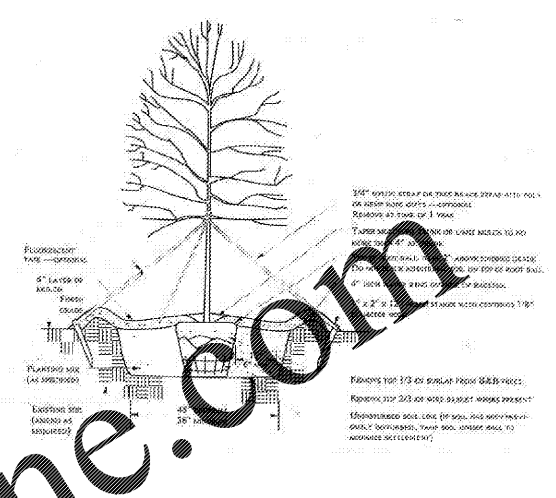


**SINGLE STEM TREE PLANTING DETAIL**

NTS

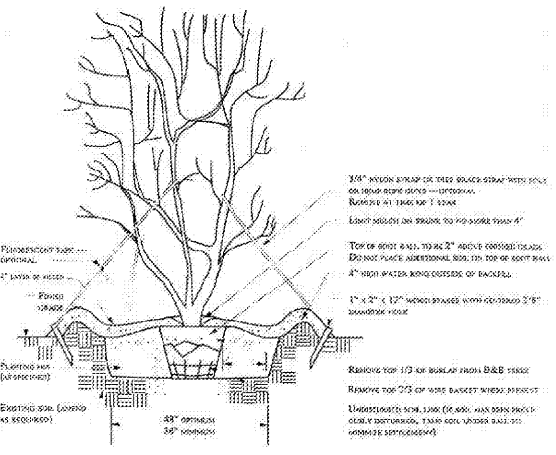

**MULTI-STEM TREE PLANTING DETAIL**

NTS

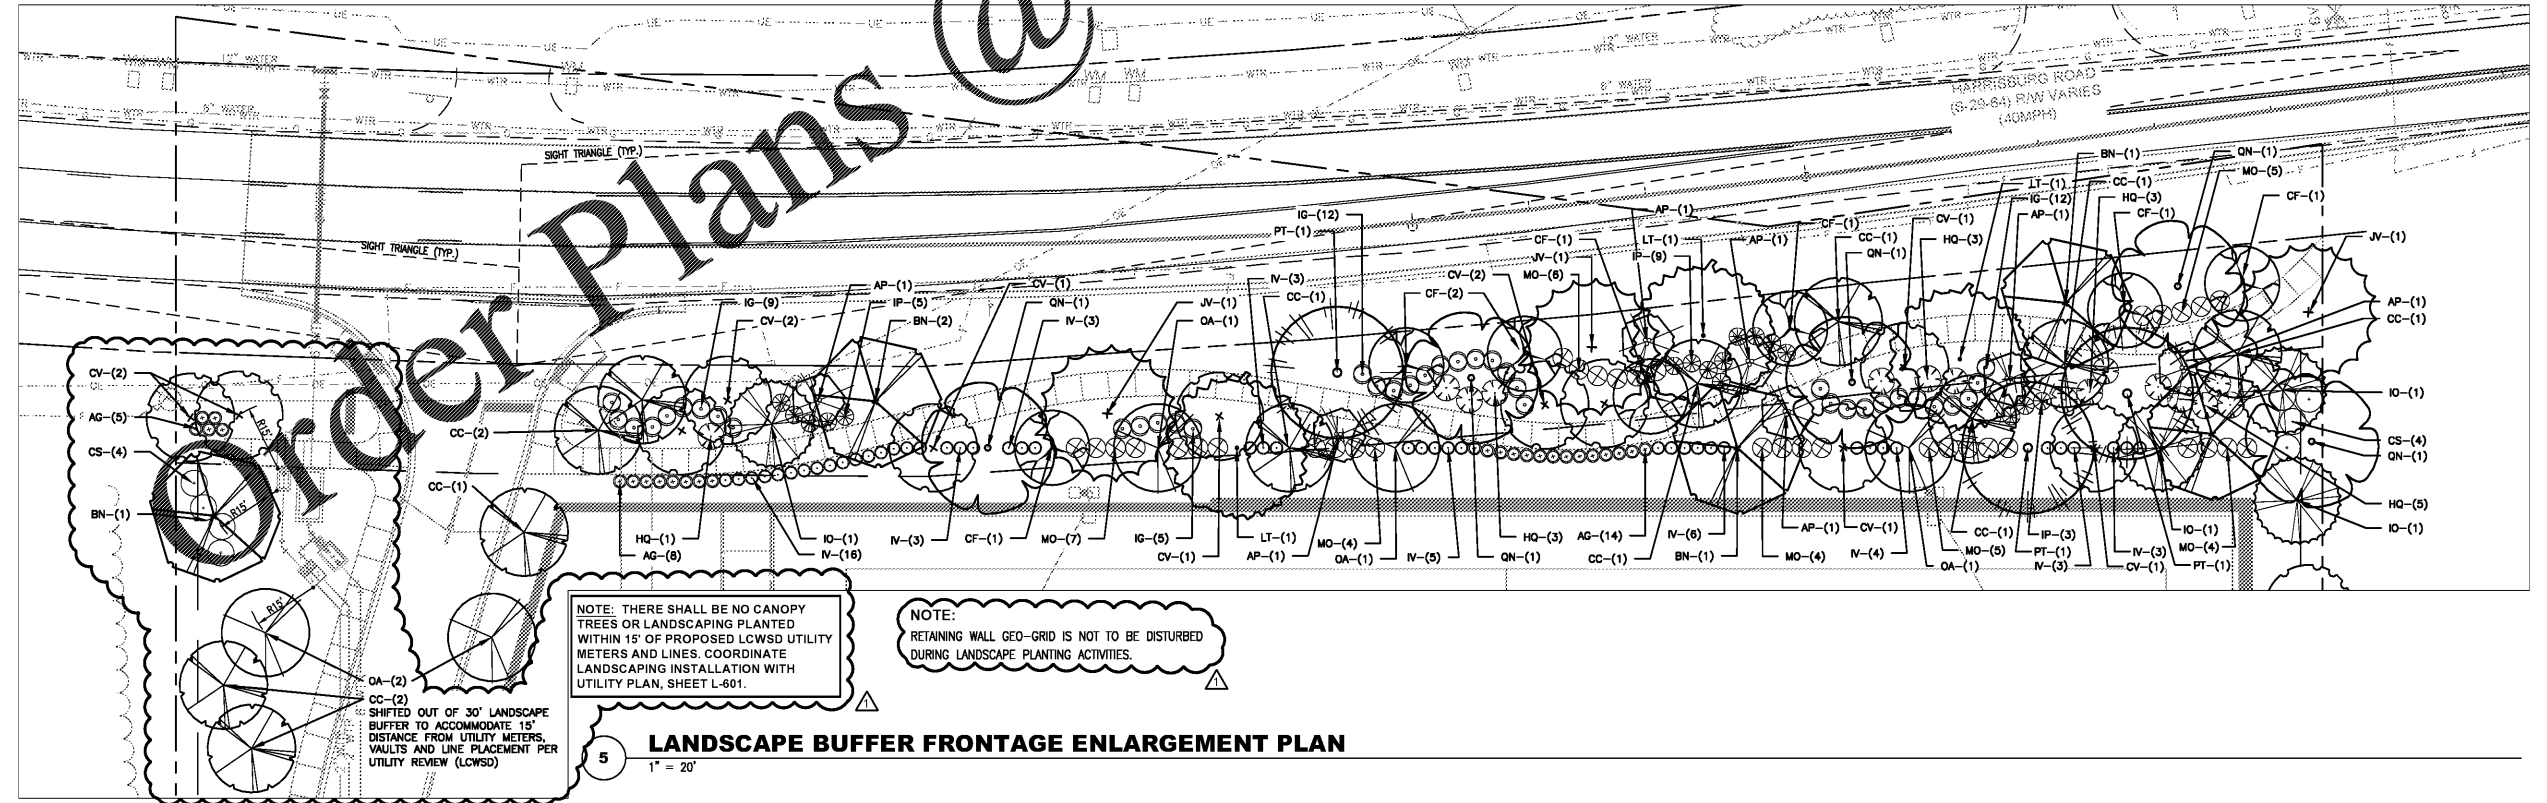


NOTE: THERE SHALL BE NO CANOPY TREES OR LANDSCAPING PLANTED WITHIN 15' OF PROPOSED LCWSD UTILITY METERS AND LINES. COORDINATE LANDSCAPING INSTALLATION WITH UTILITY PLAN, SHEET L-601.

NOTE: RETAINING WALL GEO-GRID IS NOT TO BE DISTURBED DURING LANDSCAPE PLANTING ACTIVITIES.

**LANDSCAPE BUFFER FRONTAGE ENLARGEMENT PLAN**

1" = 20'

NTS

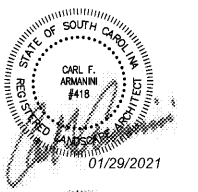

Revisions:  
PER REVIEW COMMENT - 1 01/25/2021

Proj. No.: 80702  
Date: 10/13/2020

Sheet Name:  
Plant Schedule & Landscape Details