

GENERAL NOTES:

1. ALL SIGNAGE IS SHOWN FOR REFERENCE ONLY AND WILL BE APPLIED FOR UNDER SEPARATE PERMIT.
2. SEE SHEET A800 FOR STOREFRONT TYPES.
3. ALL BUILDING ELEMENTS AS SHOWN ON ELEVATIONS OTHER THAN THOSE DESCRIBED IN KEY NOTES THIS SHEET ARE EXISTING.
4. PAINT UNDERSIDE OF STRUCTURAL DECKING AT PATIO PT-6 (BLACK).

KEY NOTES: ☒

1. PATIO BEAMS, COLUMNS, GUTTERS, DOWNSPOUTS, & RAILING, SEE 8/A410. PRIME WITH PRIMER-3 AND PAINT PT-6 (BLACK).
2. STRING PATIO LIGHTS SUSPENDED FROM UNDERSIDE OF PATIO STRUCTURE.
3. MOUNT CEILING FAN AT 7'-0" UNDER SIDE OF PATIO. LIGHT IS SHIELDED. SEE CEILING PLAN 8/A40.
4. PATIO HEATER MOUNT AT 9'-0" H.
5. PAN CHANNEL LETTERS ALL SIGN WITH INTERNAL ILLUMINATION, BY SIGN.
6. SHIPPING CONTAINER EXTERIOR & INTERIOR PAINT TO MATCH SUBS. LANTRESKO CLAY #4688.
7. LED TAPE LIGHT IN METAL ANGLE COVE, SEE ELEC. SEE 4/A420.
8. PATIO DOWNSPOUT.

CONSULTANT:
JOHN SPONSELLER, ARCHITECT
 8025 W. 25TH PL
 LAKEWOOD, CO 80214
 TEL: (303) 815-0161



BAD DADDY'S BURGER BAR
 "EASTCHASE"
 THE VENUE EASTCHASE
 NWC EASTCHASE PKWY &
 EASTCHASE LN.
 MONTGOMERY, AL 36117

Issue Record:

4.23.2019	FOR PLAN REVIEW

Revisions:

5.6.2019	WALKIN BOX
7.1.2019	CANOPY REVS
2.10.2021	TO GO REVS

Drawn:
DRAWN BY: JS, KC


Checked:
CHECKED BY: JS

Project No.
PROJECT#: 19-207


Contractor:

EXTERIOR ELEVATIONS

A205
 Date of Last Print:
 2.10.2021

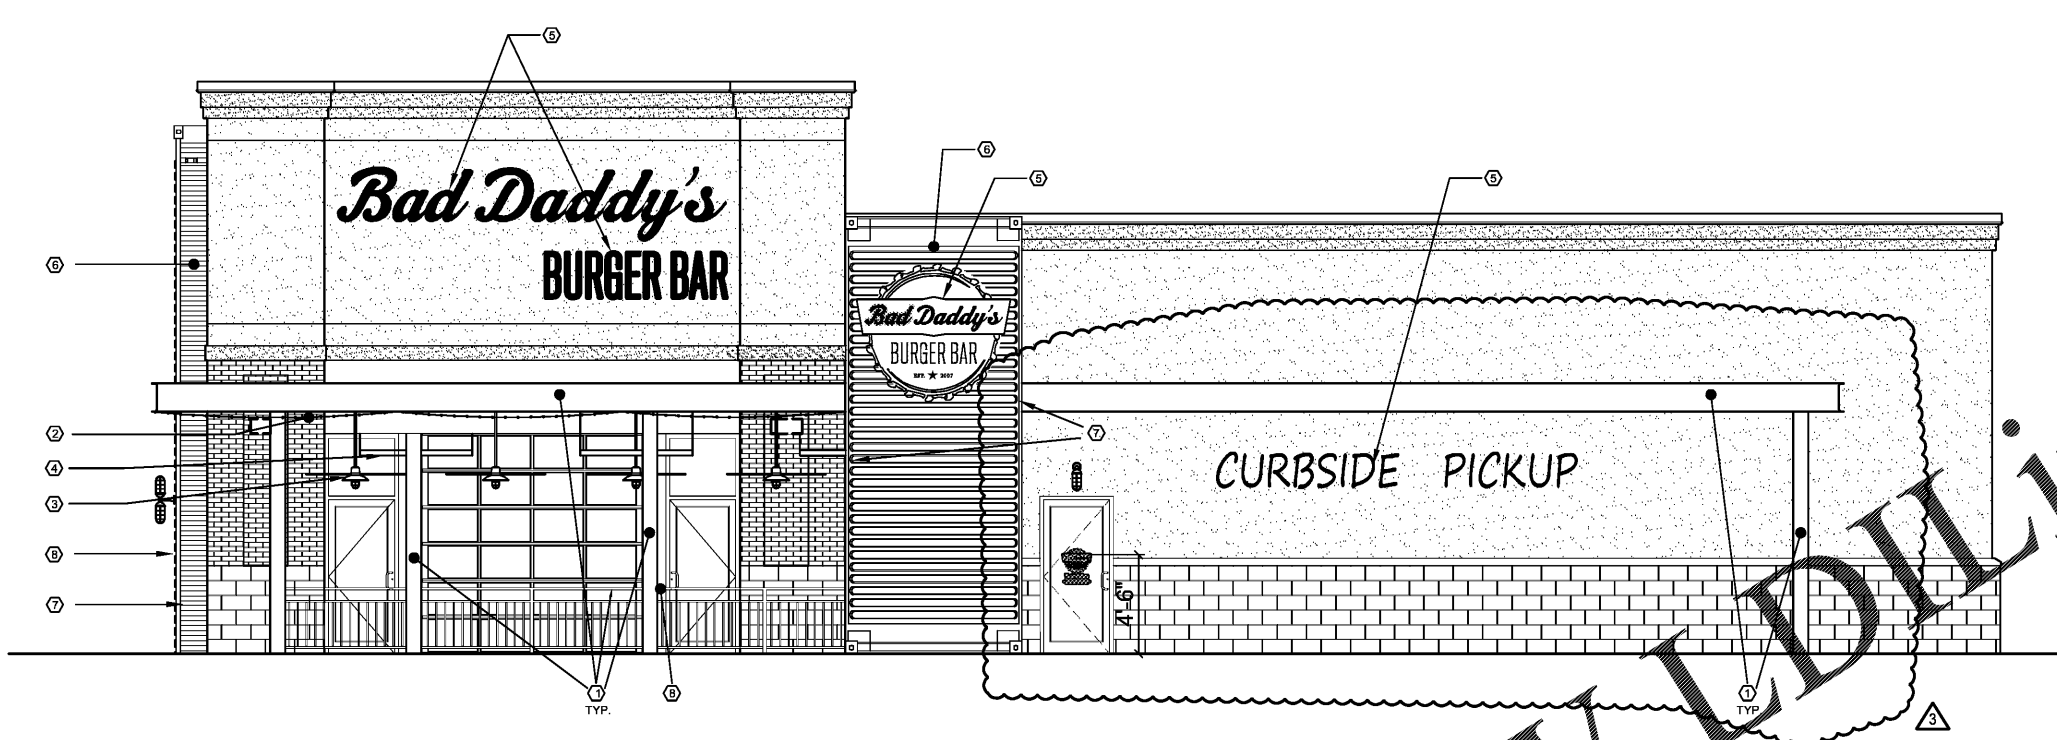

1 EXTERIOR ELEVATION: EAST (OUTSIDE PATIO)
 1/4" = 1'-0" NOTE:

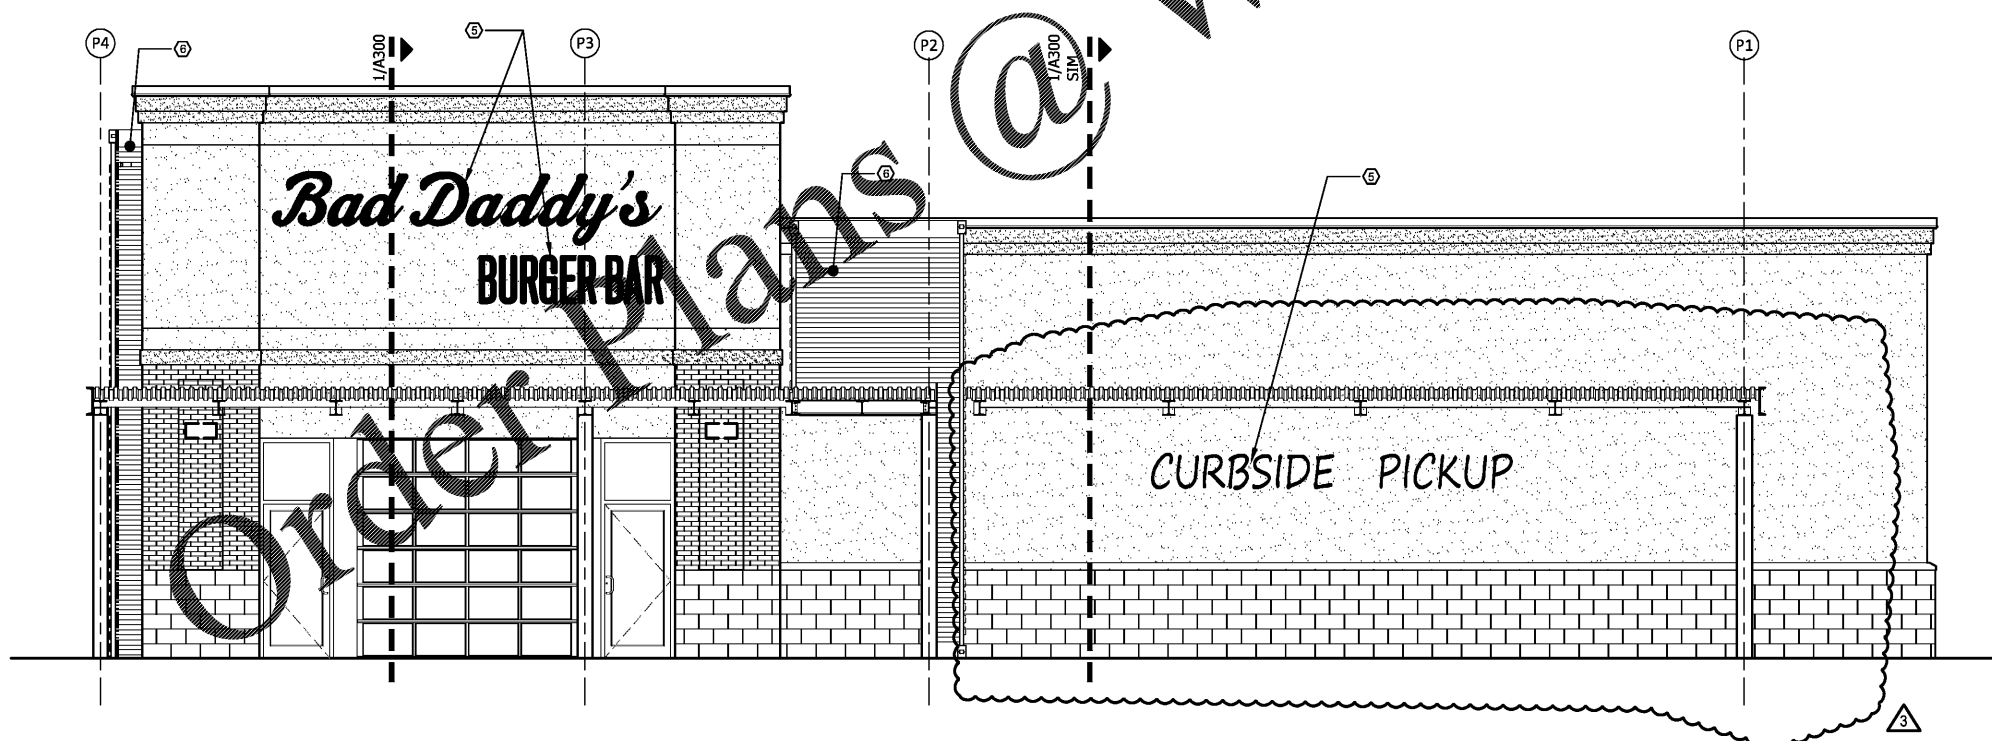

2 EXTERIOR ELEVATION: EAST (INSIDE PATIO)
 1/4" = 1'-0" NOTE: