
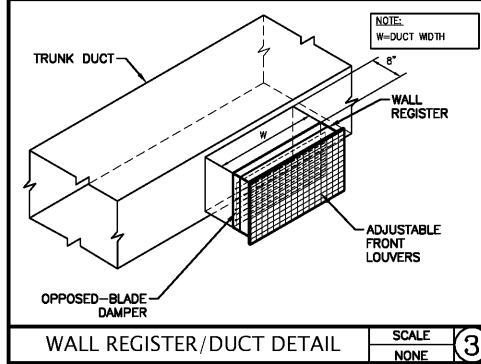
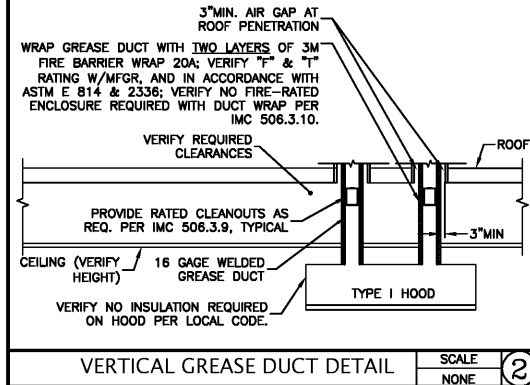


HVAC SPECIFICATIONS - DIV 15

- HVAC SPECIFIC:**
- CURBS, SUPPORTS, and ANCHORS** shall be provided for Mechanical work. No chain, tape, or wire.
 - SHEET METAL** shall be SMACNA and Code standard with 45 degree maximum reducing, 20 degree maximum expanding transitions. Ductboard shall not be used. Provide listed flex connectors at duct connection to each piece of equipment.
 - DUCT INSULATION:** Rectangular SA supply air and RA return air HVAC ducts located outside bldg exterior and in unconditioned spaces shall be insulated with R-8 ductliner (nom 2" thick); weatherproof where exposed outside. SA ducts concealed above ceiling shall be lined or wrapped with R-6 (none required on RA). Liner shall be UL-181 Class-1 anti-microbial Fiberglass attached with Stic-Klips 15" OC each way and 100% coverage of flame proof adhesive. Increase duct to allow for liner. Insulate concealed round ducts with R-6 ASTM C 553 type-1 UL-181 Class-1 covered fiberglass wired and taped in place. Exposed ducts located over open ceiling areas shall be internally lined with R-6. Elbows for rectangular duct shall be provided multi-blade turning vanes or 1.5 cantilever radius. Provide Ruskin ELF-118 or equal storm louvers with 1/4" galv mesh and 0.12" max air friction.
 - SEAL DUCT JOINTS AND SEAMS** with Childers, 3-M, Hard-Cast or equal per Code. SPIRAL DUCT: Use listed joint sealant with neat sealant edges (use and remove mask-tape).
 - GREASE DUCTS:** 16 gage black iron welded (no butt welds allowed). Horizontal sections shall slope min 1/4" per foot (2%) back to hood. Provide grease hood support that does not penetrate duct. Grease Ducts shall be accessible for maintenance. Cleanout doors, if required, shall be constructed of steel not less than duct, gasketed, with substantial latching without use of tool, all listed for use with grease duct. Wrap duct with two layers of 3-M Fire-wrap.
 - GREASE HOOD CLEARANCE** shall be not less than 18" from combustibles. This clearance is not required at gypsum wall board that is covered by smooth, cleanable, nonabsorbent and noncombustible material installed between the hood and gypsum wallboard over an area extending not less than 18" in all directions from the hood. If hood penetrates ceiling, requirements of IMC Section 506.3.10 will apply.
 - TEST AND AIR BALANCE** all systems by independent company certified by NEBB or CTAB. Attain quantities shown on plans. Air CFM flow rates based on 0.075"/CF at attitude. Balance with dampers at main with registers wide open. Motors to draw 95% max nameplate amps. Tabulate all motors, grilles, registers, and diffusers with full typewritten Test and Balance Report submitted to Owner for approval prior to Final Payment by Owner.
- GENERAL:**
- LOCAL AND STATE CODES/ORDINANCES** and **CONDITIONS OF CONTRACT** shall be followed. **SUBMIT** plans to Building Department for Plan Review. Follow correction requirements. Pay all Fees and obtain all Permits.
 - ADOPTED ENERGY CODE** shall be followed. All equipment, insulation, and controls shall conform.
 - VISIT SITE** daily to ascertain existing conditions prior to ordering equipment or fabricating duct and piping.
 - MECHANICAL DRAWINGS** are schematic and not to be scaled. Refer to Architectural/Certified drawings and site measurements for dimensions.
 - AS-BUILT** scale drawings shall be provided by Contractor and submitted to Owner at completion showing all piping, duct, and equipment changes.
 - EQUIPMENT SHOWN ON DRAWINGS** and **SPECIFICATIONS:** Contractor shall order, purchase, receive, uncrate, assemble, and install all items in conformance to Manufacturer's recommendations. Additionally Contractor shall install and final connect Owner furnished items as indicated on drawings. Contractor shall insure all equipment.
 - SHOP DRAWINGS:** Contractor shall check Shop Drawings for 100% compliance with Contract Documents. Submit complete electronic PDF file to Owner for review prior to ordering.
 - BASE BID** on specified equipment as shown on plans and in specifications.
 - SUBSTITUTIONS** will be processed as change-orders after Bidding with all electrical, building alterations, and dollar amounts included and approved in writing by owner prior to ordering equipment or fabrication.
 - EXTRA COSTS** or **CHANGES** allowed only if approved in writing by Engineer with dollar amount prior to ordering.
 - ELECTRICAL COORDINATION:** Confirm voltage, phase, and ampacity with Electrical Contractor prior to ordering equipment. All 24v controls including interlock wiring for Mechanical equipment by Division 15 Contractor. Provide magnetic starters for all 3-phase motors with protection on all three leads. Control and heating/cooling equipment to automatically restart after power failure. All wire in conduit per NEC latest edition.
 - SLEEVES** and **COLLARS** shall be provided for all ductwork and pipes thru walls, floors, and ceilings. Provide chrome plated escutcheons for exposing piping penetrations thru ceilings, floors, or walls in finished areas. All water, soil, waste, vent and trim including fittings to be chrome plated where exposed.
 - CONCEAL** all work in finished areas.
 - CUT and PATCH** to match adjacent areas. structural member shall be cut or notched.
 - OPERATING MANUAL** shall be provided Owner. Engineer for all systems and equipment including manufacturer's maintenance manuals. Include lubrication, filter types and sizes, starting and stopping procedures. List Contractor's telephone numbers.
 - ONLY CONTRACTORS WITH EXPERIENCE** on at least 3 similar projects of this type may bid.
 - RFI** (Request For Information) from Contractor shall include at least one proposed solution which complies with the intent of Contract Documents.
 - GUARANTEE** all labor and new equipment for one year from the date of acceptance by Owner.
 - EQUIPMENT SUBMITTALS:** Provide submittals to Owner on all ductwork, diffusers, registers, etc.

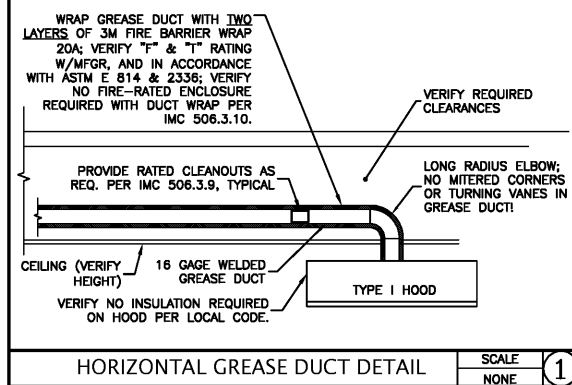


OUTSIDE AIR CALCULATIONS: IMC Code (table 403.3)

HVAC SYSTEM:	RTU-300A	5.0 Ton Cooling	Total SA = 2,000 CFM	Set OSA min set = 25.0%												
Room Type:	Room Name and Room #	Az	Rp	Ra	Default Occ	Pz	If all Return Air is at Floor Level	Effectiveness Factor = 0.8	Total Room Supply Air (SA) CFM	Total OSA CFM Provided	OSA INTAKE RESULT:	# of WC, U, SH, etc	Exhaust CFM per plbg fixture or per sqft	Exhaust CFM Required	Total Exhaust CFM Provided	Exhaust Results:
OFFICE	Office	75	5.0	0.06	5	0	6	8	100	25	OSA Complies	na	na	na	na	na
Kitchen	Kitchen, Prep Area, Dish Area	1,025							1,900	475	na	0	0.70	718	4,950	Exhaust Complies
Total Floor Area =		1,100 sqft			Totals =		6	8	2,000	500				718	4,950	

HVAC SYSTEM:	RTU-300B	5.0 Ton Cooling	Total SA = 2,000 CFM	Set OSA min set = 27.0%												
Room Type:	Room Name and Room #	Az	Rp	Ra	Default Occ	Pz	If all Return Air is at Floor Level	Effectiveness Factor = 0.8	Total Room Supply Air (SA) CFM	Total OSA CFM Provided	OSA INTAKE RESULT:	# of WC, U, SH, etc	Exhaust CFM per plbg fixture or per sqft	Exhaust CFM Required	Total Exhaust CFM Provided	Exhaust Results:
Storage	Server Area	293	0.0	0.12	0.0	0.0	35	44	700	189	OSA Complies	na	na	na	na	na
Toilet Rooms (EXHAUST)	Men's	89							75	20	na	2	75	150	150	Exhaust Complies
Toilet Rooms (EXHAUST)	Women's	118							75	20	na	2	75	150	150	Exhaust Complies
Corridors		92	0.0	0.06	0.0	0.0	6	7	150	41	OSA Complies	na	na	na	na	na
DINING	Dining Room	297	7.5	0.18	70	21	209	262	1,000	270	OSA Complies	na	na	na	na	na
Total Floor Area =		889 sqft			Totals =		250	313	2,000	540				300	300	

HVAC SYSTEM:	RTU-300C	7.5 Ton Cooling	Total SA = 3,000 CFM	Set OSA min set = 27.0%												
Room Type:	Room Name and Room #	Az	Rp	Ra	Default Occ	Pz	If all Return Air is at Floor Level	Effectiveness Factor = 0.8	Total Room Supply Air (SA) CFM	Total OSA CFM Provided	OSA INTAKE RESULT:	# of WC, U, SH, etc	Exhaust CFM per plbg fixture or per sqft	Exhaust CFM Required	Total Exhaust CFM Provided	Exhaust Results:
Main Entry Lobby	Hostess Area	180	5.0	0.06	10	2	20	400	100	100	OSA Complies	na	na	na	na	na
DINING	Dining Room	137	7.5	0.18	70	10	10	121	500	125	OSA Complies	na	na	na	na	na
BAR, Fast Food	Bar	323	7.5	0.18	100	30	30	300	2,100	525	OSA Complies	na	na	na	na	na
Total Floor Area =		640 sqft			Totals =		417	521	3,000	750				0	0	

HVAC SYSTEM:	RTU-300D	7.5 Ton Cooling	Total SA = 3,000 CFM	Set OSA min set = 27.0%												
Room Type:	Room Name and Room #	Az	Rp	Ra	Default Occ	Pz	If all Return Air is at Floor Level	Effectiveness Factor = 0.8	Total Room Supply Air (SA) CFM	Total OSA CFM Provided	OSA INTAKE RESULT:	# of WC, U, SH, etc	Exhaust CFM per plbg fixture or per sqft	Exhaust CFM Required	Total Exhaust CFM Provided	Exhaust Results:
DINING	Dining Room	684	7.5	0.18	70	48	48	603	3,000	810	OSA Complies	na	na	na	na	na
Total Floor Area =		684 sqft			Totals =		482	603	3,000	810				0	0	

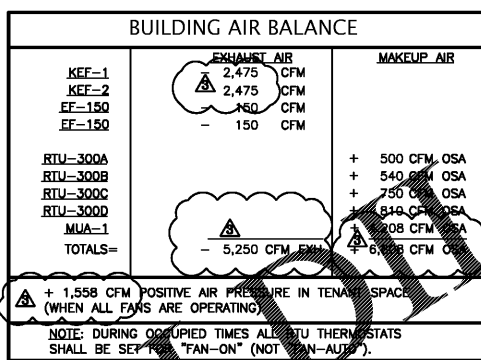

H.V.A.C. LEGEND (Commercial)

SYMBOL	DESCRIPTION	SYMBOL	DESCRIPTION
[Symbol]	SUPPLY DUCT UP	(E)	EXISTING
[Symbol]	SUPPLY DUCT DN	(R)	REMOVE EXISTING
[Symbol]	RETURN OR EXHAUST DUCT UP	(R)	REMOVE & RELOCATE
[Symbol]	RETURN OR EXHAUST DUCT DN	[Symbol]	EXISTG DUCT
[Symbol]	ROUND DUCT SECTION UP	[Symbol]	EXISTG DUCT ALT
[Symbol]	ROUND DUCT SECTION DN	[Symbol]	REMOVE (E) DUCT
[Symbol]	TRUNK DUCT ELBOW (TURNING VANES REQ'D)	[Symbol]	REMOVE (E) DUCT ALT
[Symbol]	SIDE CONNECTION OF ROUND DUCT	[Symbol]	GALV STEEL DUCT
[Symbol]	TOP (OR BOTTOM) CONN OF ROUND DUCT	[Symbol]	GALV STEEL DUCT ALT
[Symbol]	VOLUME DAMPER (TYPE)	[Symbol]	INSULATED ROUND DUCT
[Symbol]	SIDE CONNECTION OF RECTANGULAR DUCT	[Symbol]	EQUIPMENT SYMBOL (SEE EQUIPMENT SCHEDULE)
SA	SUPPLY AIR DUCT	[Symbol]	POINT OF CONNECTION
RA	RETURN AIR DUCT	[Symbol]	THERMOSTAT CONTROLLER
MUA	MAKEUP AIR DUCT	[Symbol]	REMOTE TSTAT SENSOR
OSA	OUTSIDE AIR	[Symbol]	SMOKE DETECTOR
J.C.	UNDERCUT DOOR 1" AFF ABOVE FINISHED FLOOR	[Symbol]	REMOTE HUMIDISTAT

MECHANICAL EQUIPMENT LIST

(EXISTING)EQUIPMENT BY LANDLORD:


- RTU-300A ROOFTOP HVAC UNIT:** Verify CARRIER model 48KCD008 packaged rooftop HVAC unit; 5.0ton 1-stage cooling, 14.1 SEER, 2,000 CFM at 0.75"ESP; 72 MBH gas heat input. ELECTRICAL: Verify 208/230V-3ph, 30 MCA, 45 MOCIP.
- RTU-300B ROOFTOP HVAC UNIT:** Verify same as RTU-300A.
- RTU-300C ROOFTOP HVAC UNIT:** Verify CARRIER model 48TCD008 packaged rooftop HVAC unit; 7.5ton 2-stage cooling, 11.0 EER, 3,000 CFM at 0.75"ESP; 125 MBH gas heat input. ELECTRICAL: Verify 208/230V-3ph, 51 MCA, 60 MOCIP.
- RTU-300D ROOFTOP HVAC UNIT:** Verify same as RTU-300C.

EQUIPMENT BY TENANT:

- MUA-1 ROOFTOP MAKE-UP AIR UNIT - FURNISHED BY OWNER, INSTALLED BY HVAC SUB:** CAPTIVE AIRE model A2-D.500-200; 318 MBH gas input; 4,208 CFM @0.4"ESP; 3.0HP blower, verify 208V-3ph with Electrical Contractor prior to ordering; verify 800lbs operating weight with Mfr. Provide filters, 20"hi roof curb. Interlock "ON" with KEF-1 & KEF-2. Contact CAPTIVE AIRE (720-570-0981) for equipment details & pricing before ordering any equipment or materials.
- KEF-1 GREASE EXHAUST FAN - FURNISHED BY OWNER, INSTALLED BY HVAC SUB:** CAPTIVE AIRE model DU180HA; 2HP motor, 2,475 CFM exhaust @1.75"SP; verify 208V-3ph; verify 220lbs. operating weight with Mfr. Provide 20"high roof curb.
- KEF-2 GREASE EXHAUST FAN - FURNISHED BY OWNER, INSTALLED BY HVAC SUB:** Same as KEF-1.
- KH-1 KITCHEN HOOD (TYPE-I GREASE HOOD) - FURNISHED BY OWNER, INSTALLED BY HVAC SUB:** CAPTIVE AIRE model 5424-ND-2-ACSP-F; 11' long, U.L. listed, w/dual PSP; 2,475 CFM exhaust, 2,178 CFM supply.
- KH-2 KITCHEN HOOD (TYPE-I GREASE HOOD) - FURNISHED BY OWNER, INSTALLED BY HVAC SUB:** Same as KH-1 EXCEPT: 2,030 CFM supply.
- EF-150 CEILING EXHAUST FAN:** GREENHECK model SP-A200; 150 CFM at 0.25 SP, 84 watts, back-draft damper. Duct 6" thru roof to approved SMACNA roof cap. Switch ON with lights.
- WR WALL REGISTER:** TITUS model 300FS; double deflection, mill aluminum, unfinished, DO NOT PAINT; size as shown on plan; provide duct fitting with opposed blade balancing damper. No substitutes allowed.
- CR ROUND CEILING DIFFUSER:** TITUS model TMR-AA; aluminum construction, mill aluminum, unfinished, DO NOT PAINT; Provide balancing damper in neck or at branch connection; duct connection size shown on plan, verify unit size & installation details with manufacturer prior to ordering materials. No substitutes allowed.
- CD CEILING DIFFUSER:** TITUS model OMNI plaque diffuser, 24x24 face size; neck-size shown on plan. No substitutes allowed.
- CD-2 CEILING DIFFUSER:** TITUS model OMNI plaque diffuser, 12x12 face size; neck-size shown on plan. No substitutes allowed.
- PCD PERFORATED FACE CEILING DIFFUSER:** Titus model PAS perforated face with pattern controllers, Border Type 3 (Lay-in), provide neck damper, size as shown on plan.
- RG RETURN GRILLE:** Titus model 50F, eggcrate grille, 90% free area, aluminum border & grid; Size as shown on plan.

Consultant:
ARWIN PRIEST P.E., P.Eng.
MECHANICAL * ENGINEER * ELECTRICAL
242 MOUNTAIN CLOUD CIRCLE
HIGHLANDS RANCH, CO 80126
(303) 898-2664 ps744@gmail.com

5280Engineering
www.DesignMEP.com
720-320-7744 info@5280engineering.com

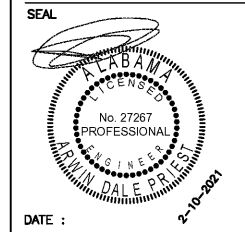

DATE: _____
Bad Daddy's Burger Bar
GOOD TIMES RESTAURANTS, INC.
141 Union Blvd, Suite 400
Lakewood, CO 80228
tel: (303) 384-1430

BAD DADDY'S BURGER BAR
"EASTCHASE"
MONTGOMERY, AL 36117

Issue Record:
04.23.2019 FOR PLAN REVIEW
Revisions:
02.10.2021 TO GO REVS
Drawn:
DRAWN BY: E Long
Checked:
CHECKED BY: R Bank
Project No.
PROJECT#: 2019-029
Consultant:

MECHANICAL:
LEGEND, SPECIFICATIONS, EQUIPMENT LIST, VENTILATION SCHEDULE