NOTES:
1. PROVIDE SEDIMENT TRAP ON DOWN GRADIENT SIDE (OR BOTH SIDES) AS REQUIRED.
2. FLUSH SURFACE STONE TOWARD SEDIMENT TRAP WITH HIGH VOLUME WATER FLOW AS NEEDED TO MAINTAIN CLEAN SURFACE STONE.
3. SEDIMENT TRAP SHALL BE LOCATED OUTSIDE OF THE RIGHT-OF-WAY AND AT A MINIMUM SETBACK DISTANCE AS REQUIRED PER LOCAL JURISDICTION.
4. SEE SWPPP SITE MAPS FOR LOCATION OF SEDIMENT TRAP(S).

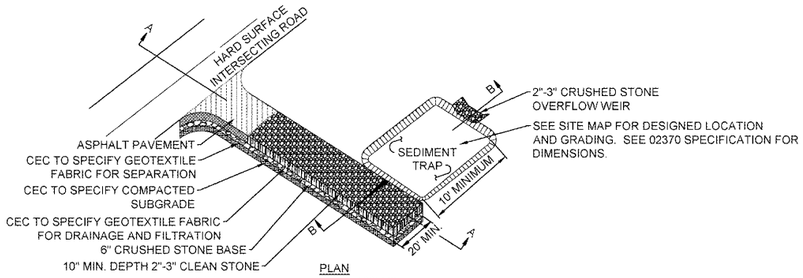

PLAN

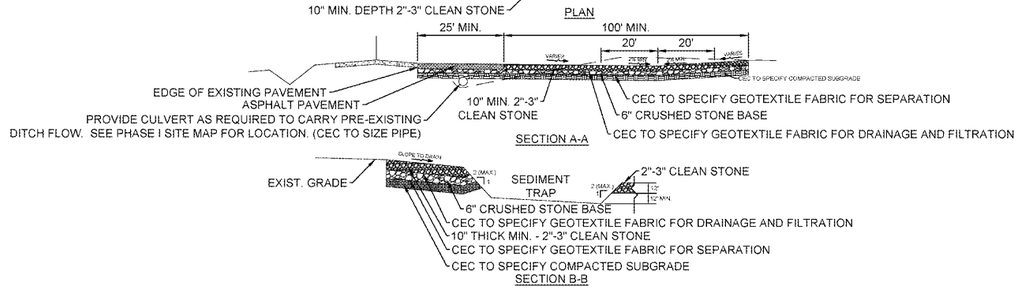

SECTION A-A

SECTION B-B

CONSTRUCTION ENTRANCE

N.T.S.

1

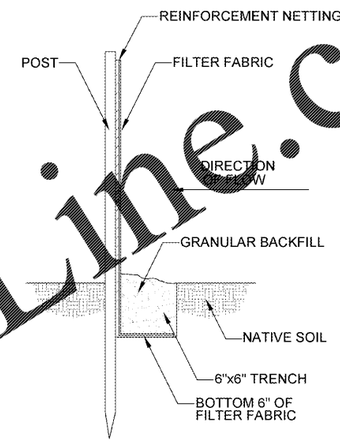

SILT BARRIER DETAIL

NOT TO SCALE

2

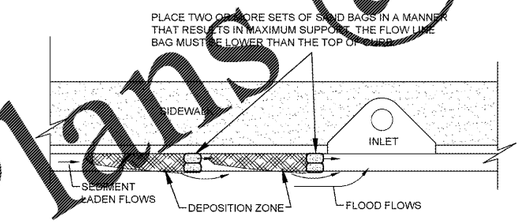

NOTE: FILL SAND BAGS ABOUT ⅔ FULL BEFORE PLACING IN THE GUTTER.

STREET GRADE %	SPACING (FT)
0.5	100
1.0	50
2.0	25
3.0	16
4.0	13
5.0	10

CURB & GUTTER SEDIMENT CONTAINMENT SYSTEM

N.T.S.

3

FOR INFORMATION ONLY

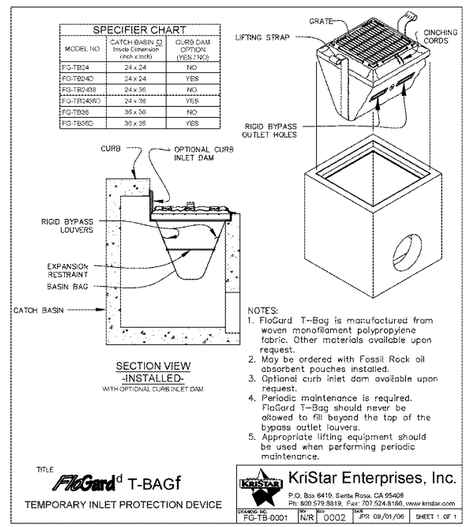

SECTION VIEW
-INSTALLED-
WITH OPTIONAL CURB INLET DAM

NOTES:
1. FloGard T-Bag is manufactured from woven monofilament polypropylene fabric. Other materials available upon request.
2. May be ordered with Fossil Rock oil absorbent pouches installed.
3. Optional curb inlet dam available upon request.
4. Periodic maintenance is required. FloGard T-Bag should never be allowed to fill beyond the top of the bypass outlet louvers.
5. Appropriate lifting equipment should be used when performing periodic maintenance.

TITLE
FloGard T-BAGf
TEMPORARY INLET PROTECTION DEVICE

KriStar Enterprises, Inc.
P.O. Box 6419, Santa Rosa, CA 95406
Ph: 800.579.8819, Fax: 707.524.8186, www.kristar.com

DRAWING NO.	REV.	SIZE	DATE
FG-TB-0001	N/R	0002	JPG 09/01/06

SHEET 1 OF 1

INLET SEDIMENT FILTER

N.T.S.

4

SEMINOLE COUNTY SP PROJ. #16-06000021

ENGINEER
JASON P. MATHEWS
FL LIC. # 73648

DATE: Apr. 11, 2017

JOB #	PRJ. MGR.	DESIGNER	CHECKED
14043.21	J.P.M.	J.M.S.	J.P.M.

NO.	DATE	REVISIONS

RECORD DRAWING
THIS RECORD DRAWING IS BASED ON THE 4/3/2017 SET OF LIMITED PERMIT CONSTRUCTION DRAWINGS AND REFLECTS THE CONTRACTOR'S PURCHASED AND INSTALLED CONSTRUCTION, MATERIALS AND SYSTEMS. IT IS THE OPINION OF THE RECORD ARCHITECT AND ENGINEER THAT THE CONSTRUCTION REFLECTED IN THESE RECORD DRAWINGS IS CORRECT TO THE BEST OF HIS/HER KNOWLEDGE.
ENGINEER
FL LIC. #

Walmart
#6894-0-NEW-FL-Apopka (Balmy Beach)
AT
BALMY BEACH DRIVE, SEMINOLE COUNTY, FLORIDA

TAURUS CD 186 BALMY BEACH FL LP

SWPPP PHASE I PLAN

SHEET
C05

Small Business Enterprise
1979-2016
37 Years
LOCHRANE
Engineering, Inc.
Civil
Surveying
Planning
Environmental
Landscape Architecture
201 SOUTH ORANGE AVENUE, ORLANDO, FL 32801
PH: (407) 896-1291 | FAX: (407) 896-0594 | WWW.LOCHRANE.COM
CERTIFICATE OF AUTHORIZATION NUMBER: EB 0000291

C:\Users\jbatewell\appdata\local\temp\AcPublish_12684\6040 - C05 - SWPPP DETAILS - 6894-0.dwg - Apr 11, 2017 - 11:04am

Order Plans @ WWW.LDILine.com