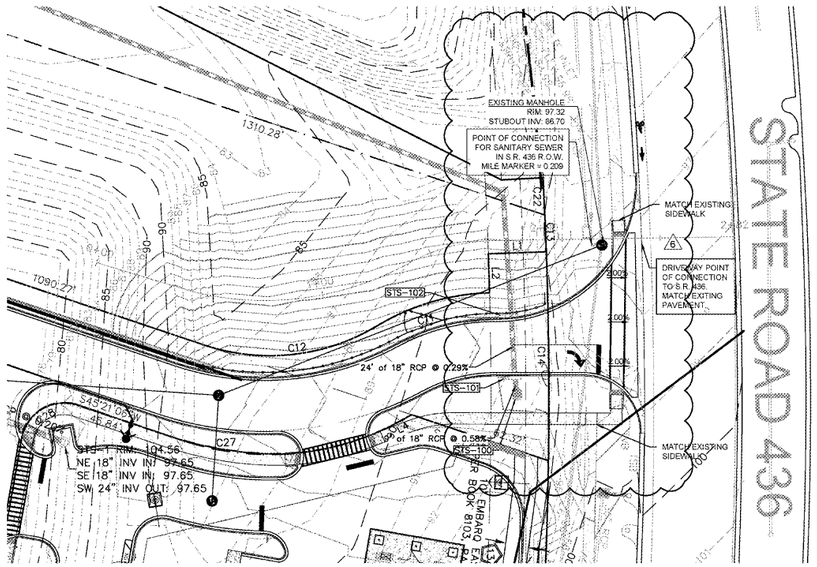

PLAN VIEW

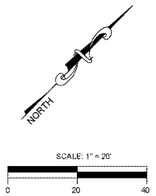

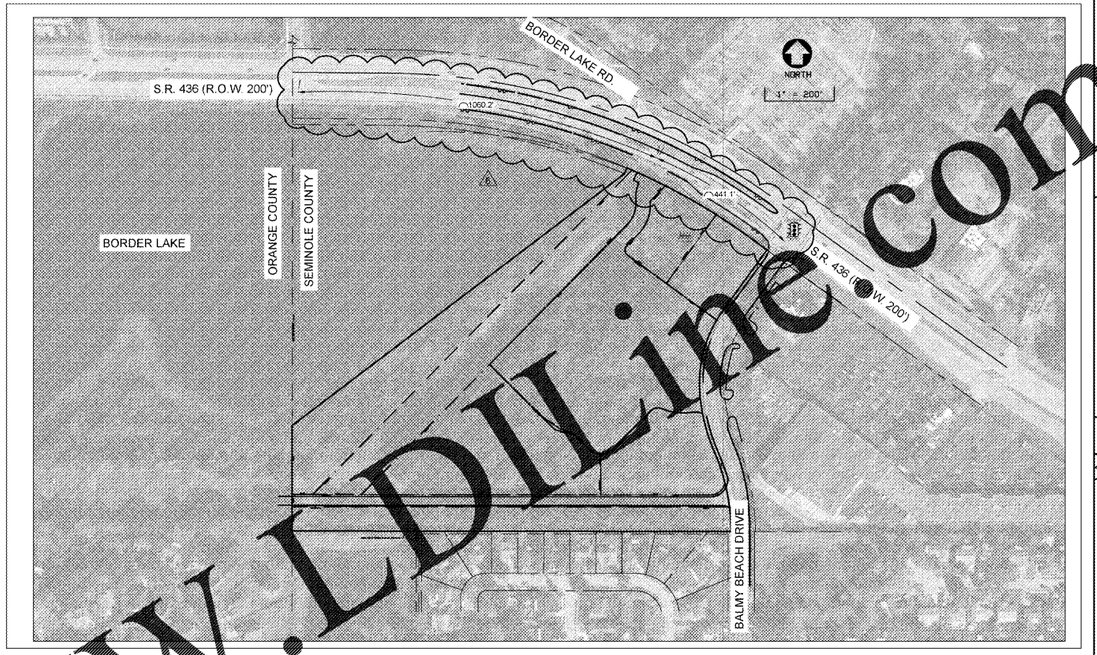

AERIAL MAP

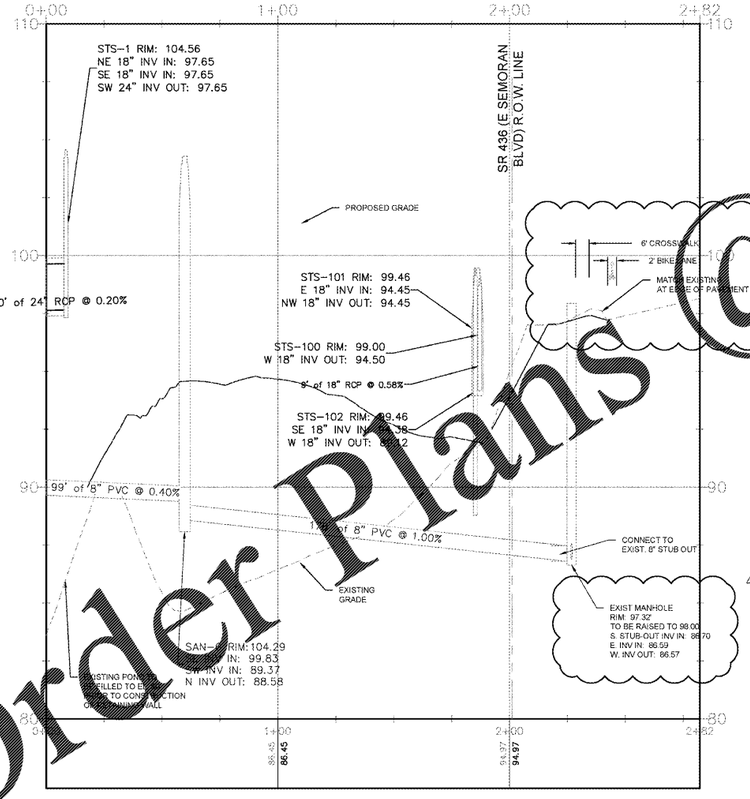

PROFILE VIEW

SCALE
HORIZ: 1" = 20'
VERT: 1" = 2'

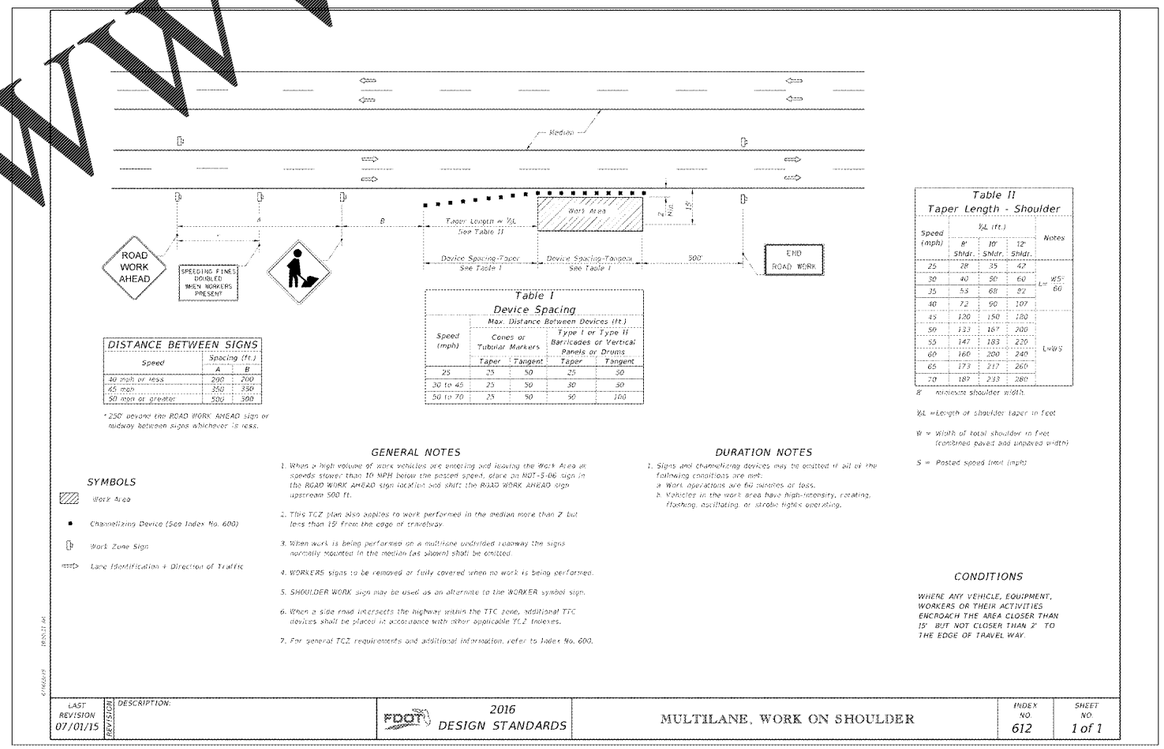

MAINTENANCE OF TRAFFIC DETAIL

FOR INFORMATION ONLY

SEMINOLE COUNTY SP PROJ. #16-06000021

JOB # 14043.21
PRJ. MGR. J.P.M.
DESIGNER: J.M.S.
CHECKED J.P.M.
DATE: Apr. 11, 2017

ENGINEER
JASON P. MAHONEY
FL LIC. #

NO.	DATE	REVISIONS

RECORD DRAWING
THIS RECORD DRAWING IS BASED ON THE FIELD SURVEY AND RECORD CONSTRUCTION DRAWINGS SUBMITTED BY THE CONTRACTOR. THE CONTRACTOR HAS CERTIFIED THAT THE CONSTRUCTION WAS SUBSTANTIALLY IN CONFORMANCE WITH THE CONSTRUCTION DRAWINGS. THE ENGINEER OF RECORD ASSUMES NO RESPONSIBILITY FOR THE ACCURACY OR COMPLETENESS OF THE CONTRACTOR'S RECORD DRAWINGS. THESE DRAWINGS ARE CORRECT TO THE BEST OF THE ENGINEER'S KNOWLEDGE.
ENGINEER
FL LIC. #

Walmart Neighborhood Market
#6894-0-NEW-FL-Apopka (Balmy Beach)
AT
BALMY BEACH DRIVE, SEMINOLE COUNTY, FLORIDA
TAURUS CD 186 BALMY BEACH FL LP

DRIVEWAY CONNECTION PLAN

Small Business Enterprise
1979-2016
LOCHRANE ENGINEERING, INC.
CIVIL • TRAFFIC • LAND DEVELOPMENT
201 SOUTH ROSEY AVENUE, ORLANDO, FL 32803
PH: (407) 894-1271 | FAX: (407) 894-5970 | WWW.LOCHRANE.COM
CERTIFICATE OF AUTHORIZATION #00002503

SHEET C11

C:\Users\rbatewell\appdata\local\temp\AcPublish_1268\6420 - C11 - DRIVEWAY CONNECTION PLAN - 6894-0.dwg - Apr 11, 2017 - 11:29am

Order Plans @ WWW.LDIline.com