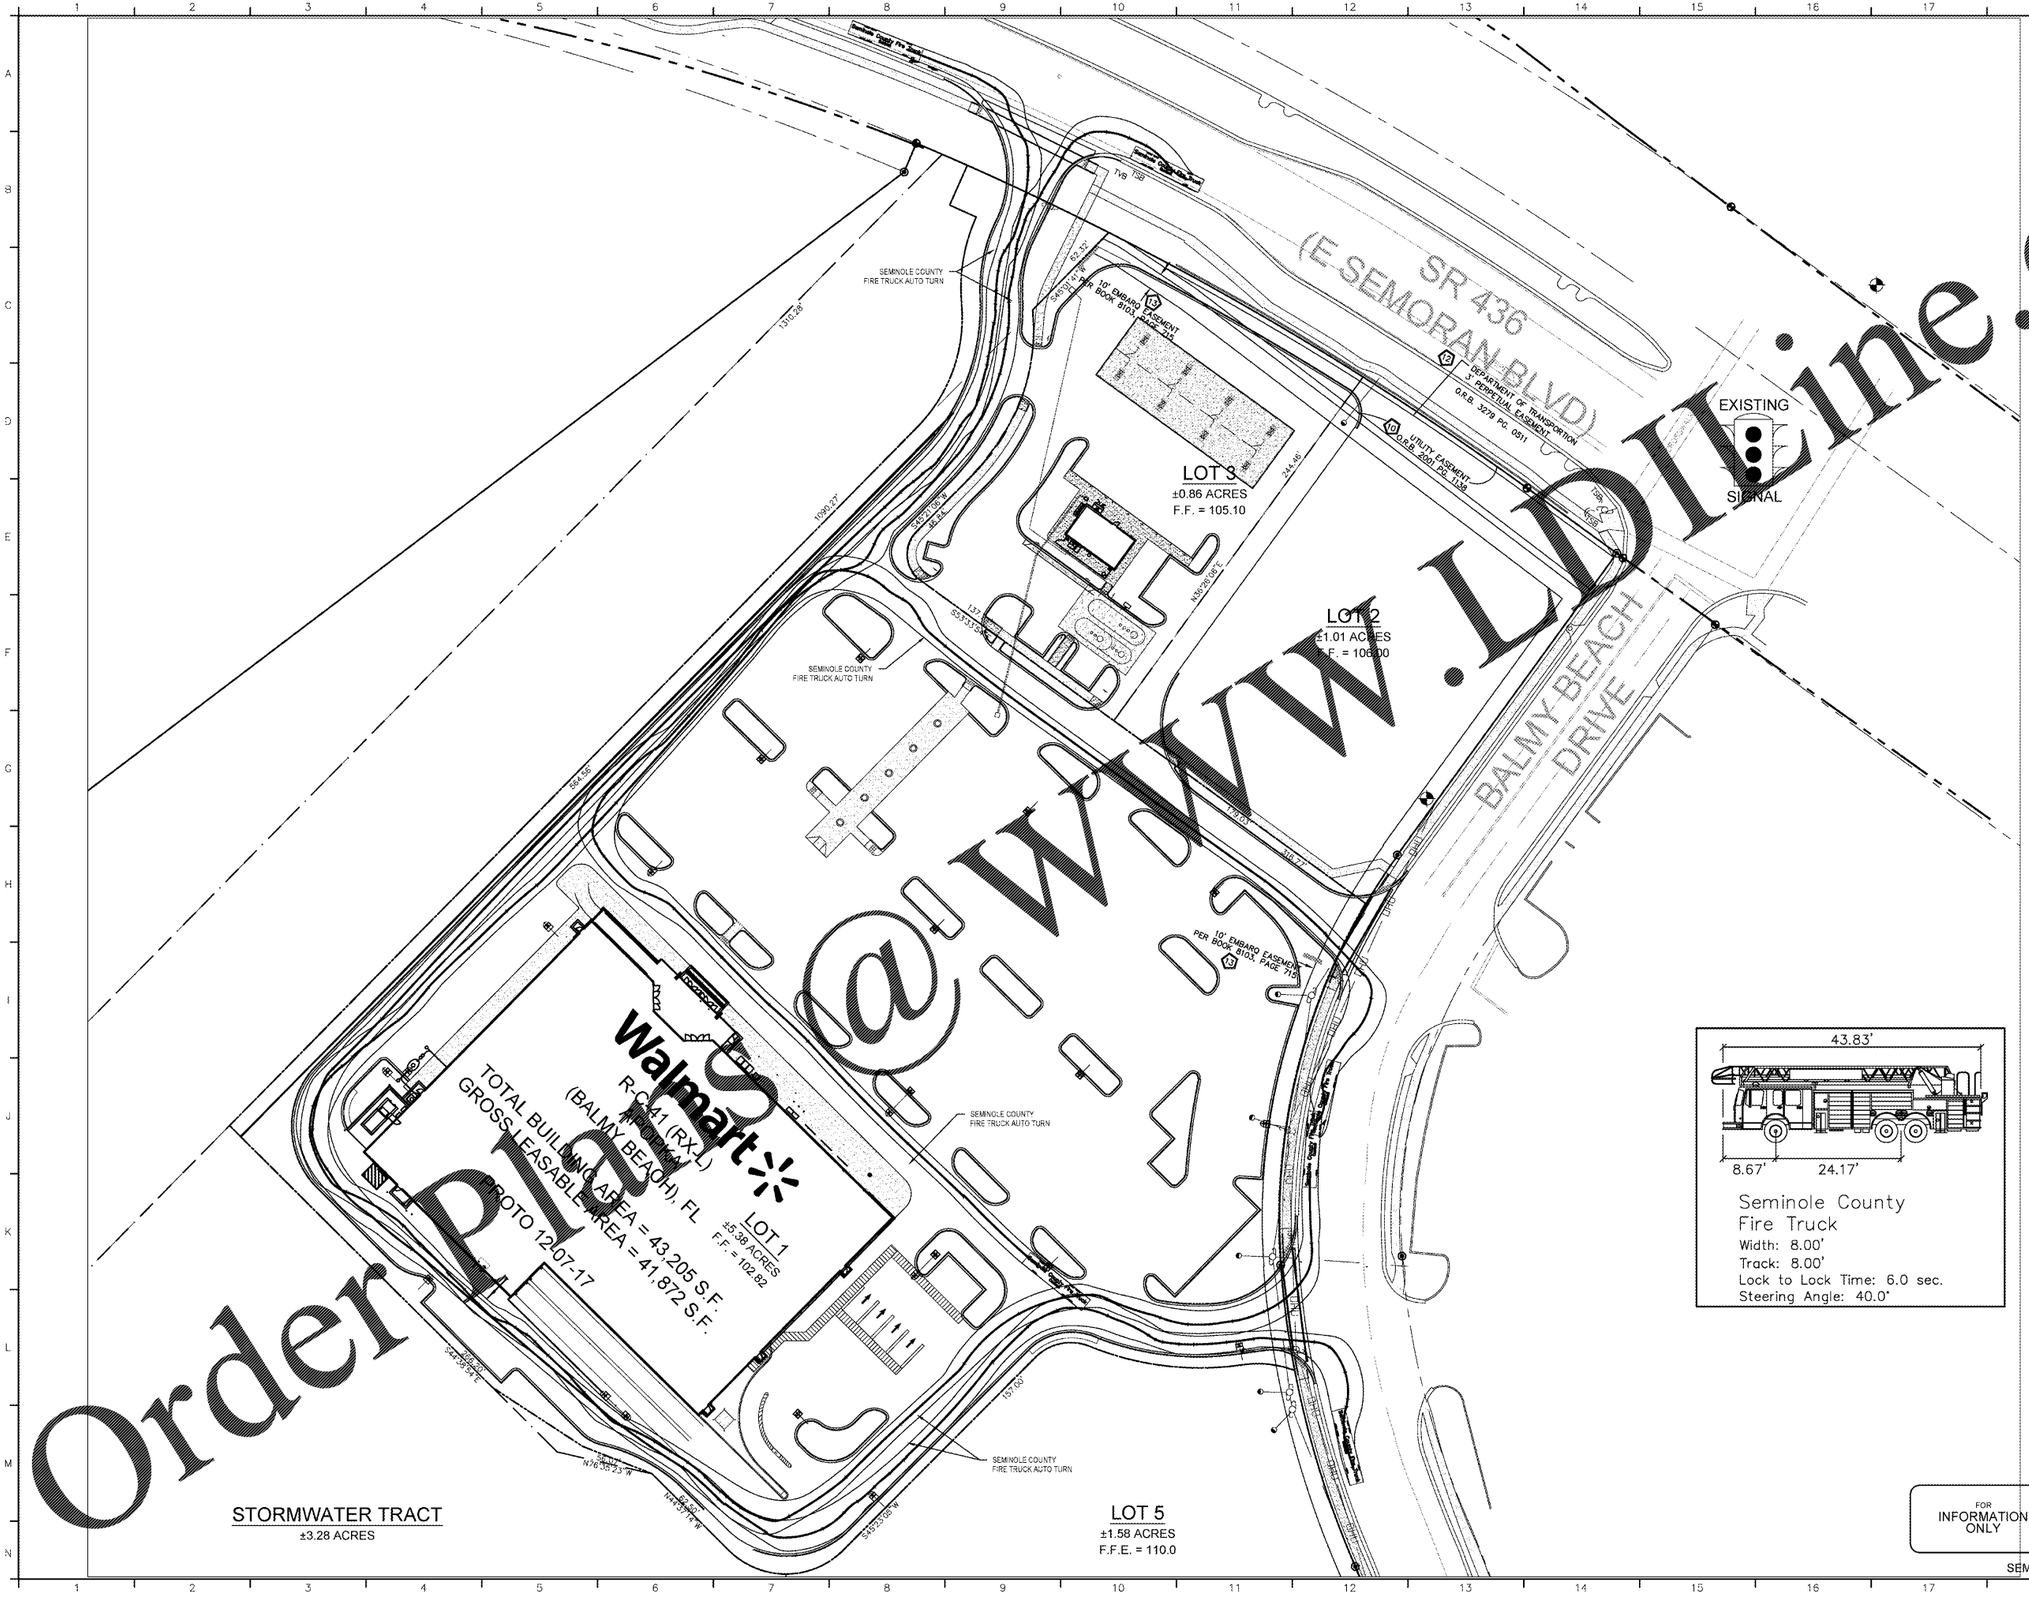


OrderPlans@WWW.LDLine.com

RECORD DRAWING

THIS RECORD DRAWING IS BASED UPON THE RESULTS OF LIMITED FIELD VERIFICATION PERFORMED BY LOCHRANE ENGINEERING, INC. AT THE COMPLETION OF CONSTRUCTION. LOCHRANE ENGINEERING, INC. MAKES NO WARRANTIES, EITHER EXPRESS OR IMPLIED, AS TO THE ACCURACY OR COMPLETENESS OF THE INFORMATION SHOWN HEREON AND ASSUMES NO RESPONSIBILITY FOR ANYONE'S RELIANCE ON IT. ANY USE OF THIS RECORD DRAWING SHALL BE AT THE USER'S SOLE RISK AND WITHOUT LIABILITY TO LOCHRANE ENGINEERING, INC. AND USER BY ACCEPTANCE OF THIS RECORD DRAWING AGREES TO INDEMNIFY AND HOLD LOCHRANE ENGINEERING, INC. HARMLESS FROM ANY AND ALL DAMAGES, LIABILITY AND COSTS, INCLUDING DEFENSE COSTS AND REASONABLE ATTORNEY'S FEES ARISING OUT OF OR IN ANY WAY CONNECTED WITH THE USE OF THIS RECORD DRAWING OR ANY DEVIATION FROM THE TERMS HEREOF. USER'S RIGHTS UNDER THIS PARAGRAPH SHALL BE LIMITED TO THE AMOUNT PAID FOR THIS RECORD DRAWING.

ENGINEER
FL LIC.#

| NO. | DATE | REVISIONS |
|---|---|---|

ENGINEER
JASON P. MAHONEY
FL LIC. # 72668

DATE: Apr. 11, 2017

| JOB #: 14043.21 | |
|---|---|
| PRJ. MGR: J.P.M. | |
| DESIGNER: J.M.S. | |
| CHECKED: J.P.M. | |

Walmart Neighborhood Market

#6894-0-NEW-FL-Apopka (Balmy Beach)

BALMY BEACH DRIVE, SEMINOLE COUNTY, FLORIDA

TAURUS CD 186 BALMY BEACH FL LP

FIRE TRUCK ROUTE PLAN

SHEET
C16

Small Business Enterprise 1979-2016 LOCHRANE Engineering, Inc. 315 SOUTH BUMBY AVENUE, ORLANDO, FL 32803 PH: (407) 896-1179 | FAX: (407) 896-2881 | WWW.LOCHRANE.COM

SEMINOLE COUNTY SP PROJ. #16-06000021

C:\Users\ybottewell\appdata\local\temp\AcPublish_12268\6840 - C16 - FIRE TRUCK ROUTE - 6894.dwg - Apr 11, 2017 - 11:41am