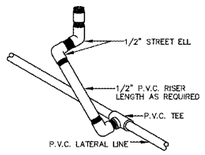

A SPRAY BODY W/ MATCHED PRECIP. ROTATOR NOZZLE N.T.S.

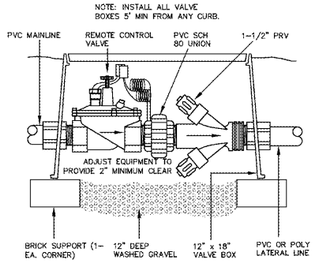

B LOW FLOW ZONE CONTROL VALVE KIT N.T.S.

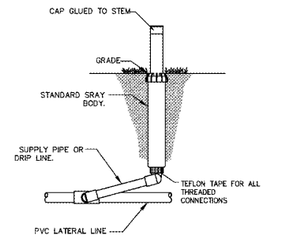

C OPERATION MONITOR N.T.S.

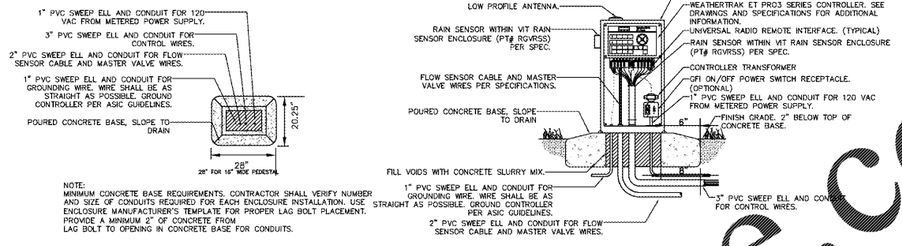

D CONTROLLER DETAIL
WEATHERTRAK ET PRO3 16" FRONT ENTRY ENCLOSURE N.T.S.

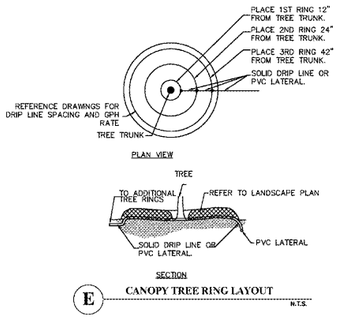

E CANOPY TREE RING LAYOUT N.T.S.

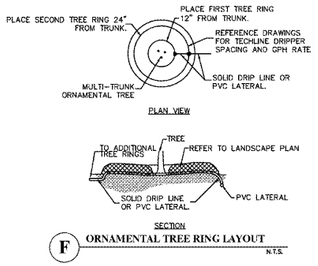

F ORNAMENTAL TREE RING LAYOUT N.T.S.

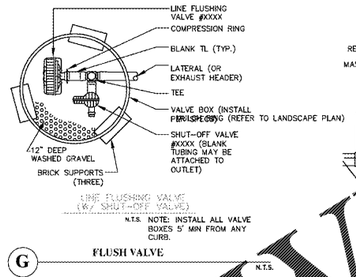

G FLUSH VALVE N.T.S.

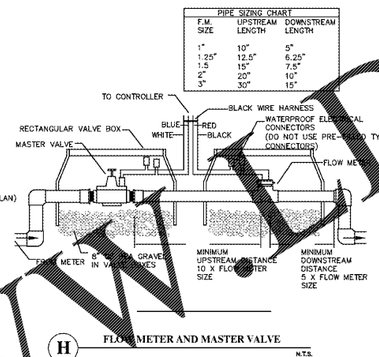

H FLOW METER AND MASTER VALVE N.T.S.

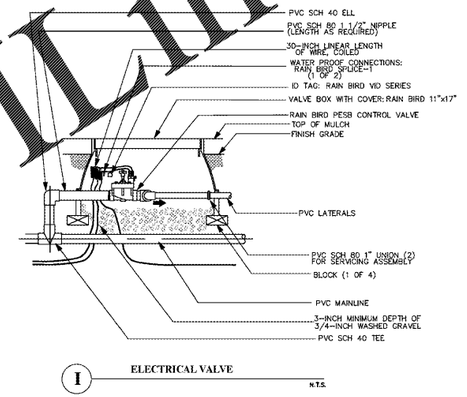

I ELECTRICAL VALVE N.T.S.

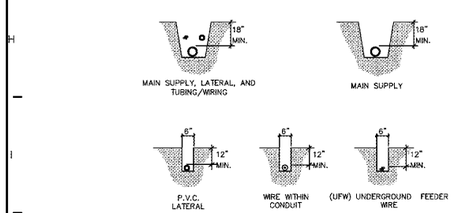

DETAIL NOTES:
1. ALL P.V.C. PIPING SHALL BE SNAKED IN TRENCHES.
2. ALL WIRING TO BE INSTALLED PER LOCAL CODES.
3. ALL WIRING TO BE BUNDLED AND TAPED AT 10' INTERVALS.
4. ALL MAIN SUPPLY LINES TO BE INSTALLED AS PER MANUFACTURER'S SPECIFICATIONS.
5. PROVIDE PIPE AND WIRE SLEEVING UNDER ALL PAVED SURFACES. WIRE SHALL BE WITHIN SEPARATE 2" ELECTRICAL CHASE.

J TRENCHING DETAIL N.T.S.

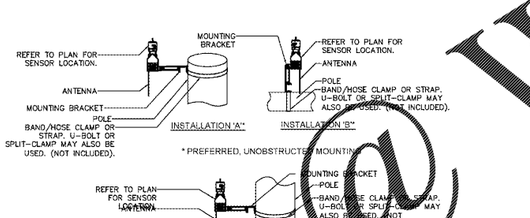

NOTE:
1. MOUNT SENSOR ON ANY ROOF WHERE IT WILL BE EXPOSED TO UNOBSTRUCTED RAINFALL AND NOT IN PATH OF SPRINKLER SPRAY, NO MORE THAN 1000' FROM RECEIVER UNIT. MOUNT RECEIVER UNIT NO FURTHER THAN 6' FROM CONTROLLER.
2. ALL ELECTRICAL WORK MUST CONFORM TO LOCAL CODES. REFER TO PRODUCT LITERATURE FOR ADDITIONAL INSTALLATION REQUIREMENTS.

K RAIN SENSOR DETAIL N.T.S.

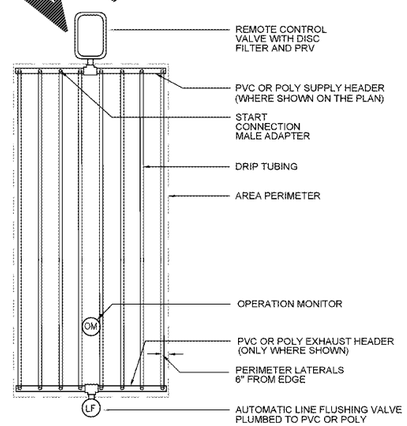

L DRIP LINE HEADER LAYOUT N.T.S.

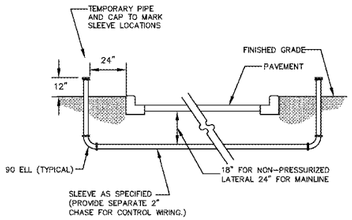

M SLEEVE INSTALLATION N.T.S.

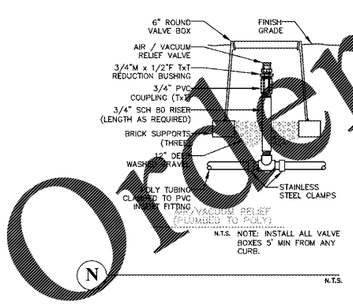

N N.T.S.

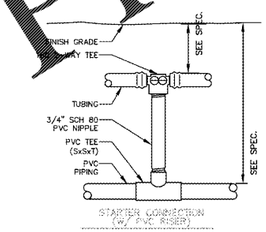

O DRIP CONNECTION
FOR AREAS OF 5 GPM OR LESS N.T.S.

Order Plans @ WWW.DILine.com

FOR INFORMATION ONLY

LARRY W. SPADE, PLA, CID
IA CID CERTIFICATION #82075

SEMINOLE COUNTY

SHEET LI03

JOB #: 14043.21
PRJ. MGR.: JPM
DESIGNER: LWS
CHECKED: JSL
DATE: Apr. 17, 2017

LANDSCAPE ARCHITECTURE
J. SCOTT IBERT, RLA
FL LIC #LA0001478

NO	DATE	REVISIONS
A	4-18-17	FUEL STATION REVISED. SR 436 ENTRANCE DRIVE REVISED
A	12/2/15	FUEL STATION REVISED. FOOT SIGHT LINE ADDED AT SR 436
A	09/18/15	FOR VAIL-MART REVIEW AND PER REVISED SITE PLAN
A	09/03/15	PER COUNTY REVIEW COMMENTS AND REVISED SITE PLAN

RECORD DRAWING
THIS RECORD DRAWING IS BASED ON THE RESULTS OF LIMITED FIELD OBSERVATIONS OF CONSTRUCTION PERFORMED BY OR ON BEHALF OF CONTRACTOR THROUGHOUT CONSTRUCTION. ARCHITECT/ENGINEER/CONSULTANT MAKES NO WARRANTY, EXPRESS OR IMPLIED, AS TO THE ACCURACY OR COMPLETENESS OF THE INFORMATION SHOWN HEREON AND DISCLAIMS ANY RESPONSIBILITY OR LIABILITY FOR ANY DEFICIENCIES, INCLUDING BUT NOT LIMITED TO, THE FAILURE OF THE CONSTRUCTION TO CONFORM WITH THE CONTRACT DOCUMENTS. THIS RECORD DRAWING IS NOT SUFFICIENT OR INTENDED FOR USE AS THE SOLE BASIS FOR CONSTRUCTION OR FOR ANY FUTURE CONSTRUCTION OR RECONSTRUCTION.
ENGINEER:
FL LIC #

Walmart
#70052-1-NEW-FL-Appopka (Balmy Beach)
AT
860 BALMY BEACH DRIVE, SEMINOLE COUNTY, FLORIDA
FOR
TAURUS INVESTMENT HOLDINGS, INC.

IRRIGATION DETAILS

Small Business Enterprise 1979-2015
LOCHRANE Engineering
201 South Rose Avenue, Orlando, FL 32801
PH: (407) 849-2121 | FAX: (407) 849-2161 | WWW.LOCHRANE.COM
CERTIFICATE OF AUTHORIZATION # 00003316