UTILITY LEGEND

810 MISC MARKER

NOTES

1. ASSUMED RESIDENCE TEST HOLE BY THIS ENGINEER:
   1900-1904660 US5000 - 39-4-05 - 0.00280 (0.00670280) (NO VDPS req) REVISED AS PER/BY ENGINEERING FOR MISC MARK NUMBERS, (10/05/21)

SURVEY REFERENCE NOTES

ALL HORIZONTAL AND VERTICAL SURVEY DATA OBTAINED BY UTILITY MAPPING PRIOR TO ANY ON-SITE EXCAVATION AND DESIGN. ALL REFERENCES TO SURVEY CONTROL POINTS HEREIN BY OTHERS. AS-BUILT

POINT	NORTHING	EASTING	ELEVATION	DESCRIPTION
100	7079663.11	1948812.23	387.54	PK NAIL
101	7079663.87	1948749.42	387.64	PK NAIL

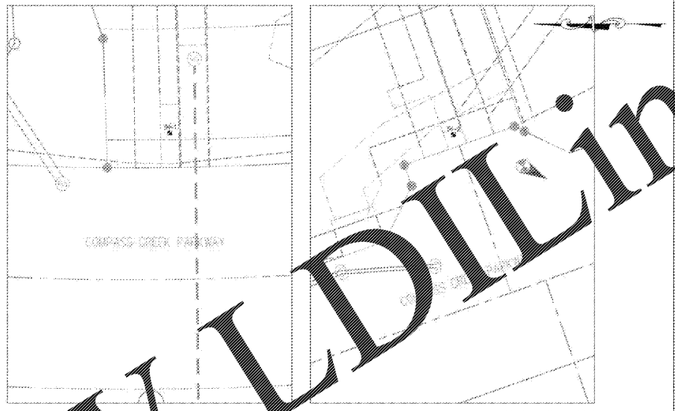

TEST HOLE LOCATION WORKSHEET

WAL-MART - LEESBURG

LOUDOUN COUNTY, VIRGINIA

A/I DATA PROJECT #17138 SHEET 1 OF 1

DRAFTED BY: BRT CHECKED BY: MJB DRAWING DATE: 05/26/2017

SCALE: 1"=30'

TEST HOLES PERFORMED: 12/7 & 05/23/2017 NO. 100, 200

SITE ADDRESS: CONRAILS GREEN PARKWAY LEESBURG, VIRGINIA 20175

DRAWING PREPARED FOR: WAL-MART REAL ESTATE BUSINESS TRUST 2001 SE 10TH STREET, BMSC BENTONVILLE, ARKANSAS 72716-0550

A|I DATA
WHAT'S UNDERGROUND

ACCURATE INFRASTRUCTURE DATA, INC
1123 MANOLIA AVENUE, BALTIMORE, MD 21237
PHONE: 410-686-6093 FAX: 410-686-6093

A|I DATA
WHAT'S UNDERGROUND

Accurate Infrastructure Data, Inc.
1123 Manolia Ave.
Baltimore, MD 21237
Phone: 410-686-6093
Fax: 410-686-6093

TEST HOLE SUMMARY

PROJECT: WAL-MART - LEESBURG

CLIENT: WAL-MART REAL ESTATE BUSINESS TRUST

A/I DATA PROJECT NO.: 17138

DATE: MAY 26, 2017

(ALL MEASUREMENTS IN DECIMAL FEET)

TH#	UTILITY REQUESTED	UTILITY FOUND	COVER	UTILITY ELEVATION	REMARKS
1	12" DUCTILE IRON WATER	12" DUCTILE IRON WATER	3.62	751.29	
2	12" DUCTILE IRON WATER	12" DUCTILE IRON WATER		748.93	

A|I DATA — TEST HOLE DATA SHEET — JOB #: 17138 — TEST HOLE # : 1

PROJECT NAME:	WAL-MART - LEESBURG	EXCAVATION BY:	A/I DATA — DATE (S/M/D): 05/23/2017
PROJECT LOCATION:	LOUDOUN COUNTY, VIRGINIA	FORM BY: CDM — ASSISTED BY: TKS	CHECKED BY: MJB
CLIENT NAME:	WAL-MART REAL ESTATE BUSINESS TRUST	PAVING CONDITIONS:	MISC
UTILITY REQUESTED:	12" DUCTILE IRON WATER	GENERAL SOIL CONDITIONS:	SOFT WET CLAY MUCKY
UTILITY FOUND:	12" DUCTILE IRON WATER	UTILITY CONDITIONS:	GOOD
		MARKER SURVEYED BY:	A/I DATA

SECTION VIEW OF TEST HOLE — NOT TO SCALE

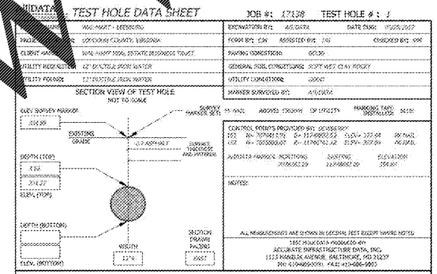

CONTROL POINTS PROVIDED BY: DEVELOPER

100	N= 7079663.170	E= 1948812.52	ELEV= 387.54	PK NAIL
101	N= 7079663.87	E= 1948749.42	ELEV= 387.64	PK NAIL

ALIGNMENT PERPENDICULAR TO: DEVELOPER

	NORTHING	EASTING
BEGINNING	7079663.87	1948749.42
END	7079663.17	1948812.23

NOTES:

ALL MEASUREMENTS ARE SHOWN IN DECIMAL FEET EXCEPT WHERE NOTED

TEST HOLES DATA PREPARED BY:
ACCURATE INFRASTRUCTURE DATA, INC
1123 MANOLIA AVENUE, BALTIMORE, MD 21237
PH: 410-686-6093 FAX: 410-686-6093

PLAN VIEW OF TEST HOLE
DIMENSIONS GENERIC DO NOT SCALE

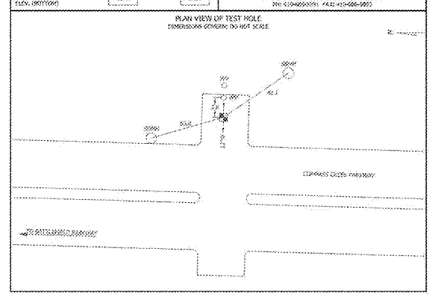

A|I DATA — TEST HOLE DATA SHEET — JOB #: 17138 — TEST HOLE # : 2

PROJECT NAME:	WAL-MART - LEESBURG	EXCAVATION BY:	A/I DATA — DATE (S/M/D): 05/23/2017
PROJECT LOCATION:	LOUDOUN COUNTY, VIRGINIA	FORM BY: JDM — ASSISTED BY: MJB, DW	CHECKED BY: MJB
CLIENT NAME:	WAL-MART REAL ESTATE BUSINESS TRUST	PAVING CONDITIONS:	MISC
UTILITY REQUESTED:	12" DUCTILE IRON WATER	GENERAL SOIL CONDITIONS:	SOFT MUCKY CLAY
UTILITY FOUND:	12" DUCTILE IRON WATER	UTILITY CONDITIONS:	GOOD
		MARKER SURVEYED BY:	A/I DATA

SECTION VIEW OF TEST HOLE — NOT TO SCALE

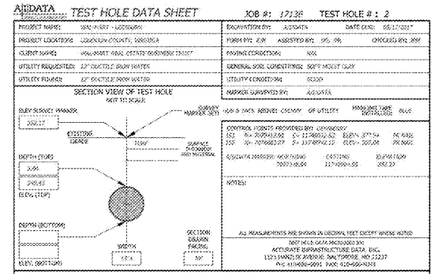

CONTROL POINTS PROVIDED BY: DEVELOPER

100	N= 7079663.170	E= 1948812.52	ELEV= 387.54	PK NAIL
200	N= 7079663.17	E= 1948749.42	ELEV= 387.64	PK NAIL

ALIGNMENT PERPENDICULAR TO: DEVELOPER

	NORTHING	EASTING
BEGINNING	7079663.87	1948749.42
END	7079663.17	1948812.23

NOTES:

ALL MEASUREMENTS ARE SHOWN IN DECIMAL FEET EXCEPT WHERE NOTED

TEST HOLES DATA PREPARED BY:
ACCURATE INFRASTRUCTURE DATA, INC
1123 MANOLIA AVENUE, BALTIMORE, MD 21237
PH: 410-686-6093 FAX: 410-686-6093

PLAN VIEW OF TEST HOLE
DIMENSIONS GENERIC DO NOT SCALE

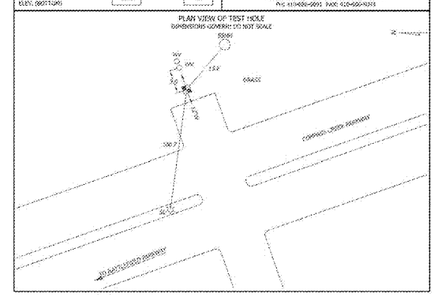

REVISIONS	BY
1 REVISED PER COUNTY AND TOWN COMMENTS	GRP
2 REVISED PER COUNTY AND TOWN COMMENTS	GRP
3 REVISED PER COUNTY AND TOWN COMMENTS	GRP
4	
5	
6	


BOHLER ENGINEERING

22636 DAVIS DRIVE, SUITE 260
STERLING, VIRGINIA 20164
Phone: (703) 709-9500
Fax: (703) 709-9501
VA@BohlerEng.com

TEST PIT INFORMATION
WALMART SUPERCENTER #1904-005 - SPAM #1
CATOCTIN ELECTION DISTRICT
LEESBURG, LOUDOUN COUNTY, VA

WAL-MART STORES, INC.
BENTONVILLE, AR

Walmart

DRAWN	GRP
CHECKED	MJB
DATE	12/22/16
SCALE	AS SHOWN
JOB No.	S148000
SHEET	C-72

SHEET 103 OF 103

Order Plans @ WWW.LDILine.com