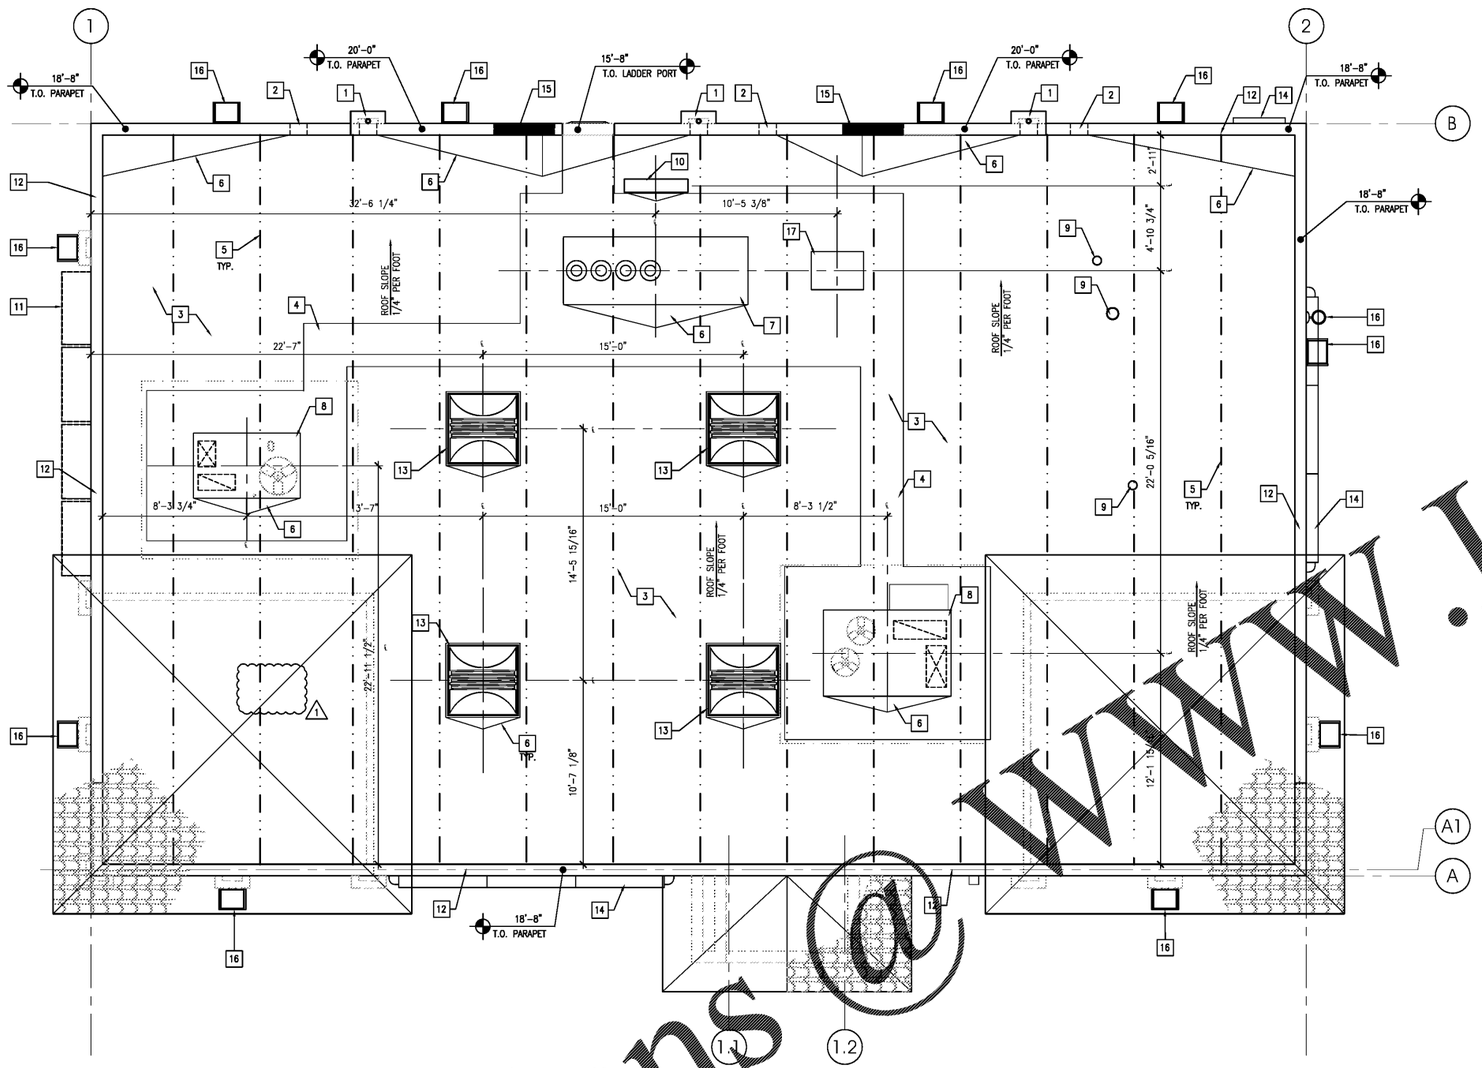

ROOF PLAN 1/4" = 1'-0"

NORTH

GENERAL NOTES

A. CONTRACTOR TO RESERVE SPECIFIED MAPES CANOPY UPON BEING AWARDED THE BID TO ENSURE AVAILABILITY AND TIMELY INSTALLATION. SUBSTITUTIONS ARE NOT PERMITTED.

KEY NOTES

1. SCUPPER INSIDE PILASTER. SEE DETAIL 5/A6.1.
2. OVERFLOW SCUPPER. SEE DETAIL 6/A6.1.
3. SINGLE PLY ROOFING WITH MINIMUM 5" ISO BOARD INSULATION OVER METAL DECKING, MECHANICALLY FASTENED.
4. WALKING PAD, TO BE A MINIMUM 30" AROUND MECHANICAL UNITS.
5. BAR JOIST BELOW. REFER TO STRUCTURAL DRAWINGS FOR EXACT LOCATION.
6. CRICKET WITH TAPERED INSULATION.
7. FLEXPACK. REFER TO MECHANICAL DRAWINGS.
8. RTU. REFER TO MECHANICAL DRAWINGS.
9. VENT/PIPE. REFER TO DETAIL 3 ON THIS SHEET AND MEP DRAWINGS.
10. REFRIGERANT PIPE PORTAL. REFER TO DETAIL 1 ON THIS SHEET.
11. BAHAMA SHUTTERS BELOW.
12. 20 GA PREFINISHED METAL CAP FLASHING – PREFINISHED DARK BRONZE.
13. PRISMATIC SKYLIGHT, REF EF-1.0 SHEET AND DETAIL 4 ON THIS SHEET.
14. BACKLIT FASCIA SIGN BY SIGN CONTRACTOR, UNDER SEPARATE PERMIT.
15. BAROMETRIC DAMPER – REF TO MECHANICAL DRAWINGS.
16. EXTERIOR WALL LIGHTING.
17. CONDENSER UNIT – REF TO MECHANICAL DRAWINGS.

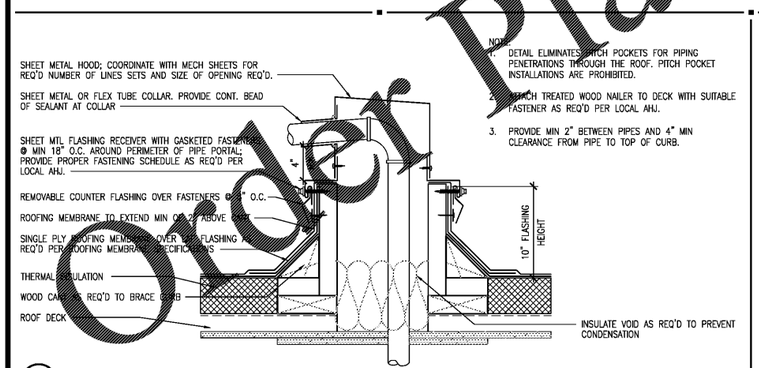

1 PIPE PORTAL DETAIL 1 1/2" = 1'-0"

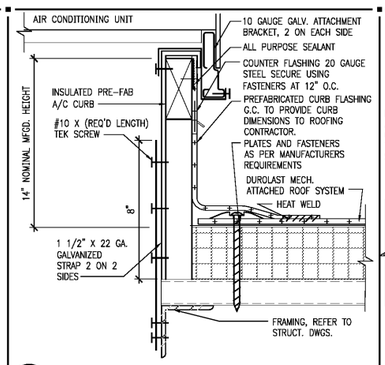

2 HVAC UNIT CURB FLASHING DTL 3" = 1'-0"

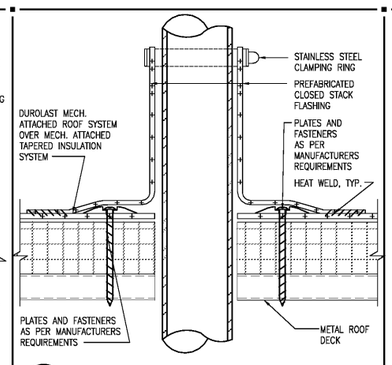

3 PIPE PENETRATION DETAIL 3" = 1'-0"

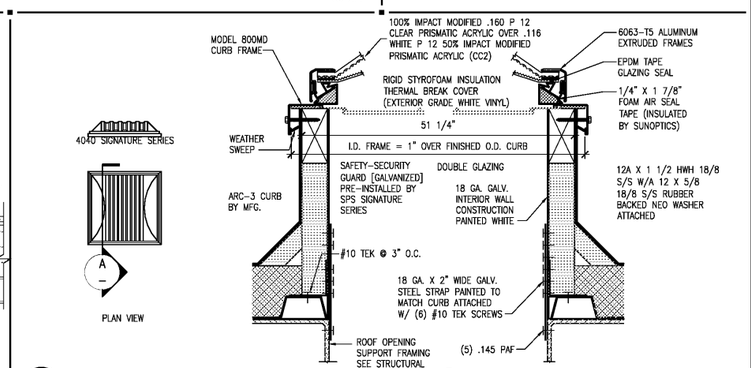

4 SKYLIGHT DETAIL 1/2" = 1'-0"

INTERPLAN LLC
ARCHITECTURE
ENGINEERING
INTERIOR DESIGN
PROJECT MANAGEMENT
AA 003420
CA 8660
604 COURTLAND STREET
SUITE 100
ORLANDO, FLORIDA 32804
PH 407.645.5008
FX 407.629.9124

SEAL:

1 06/21/17 PEER REVIEW COMMENTS
NO DATE REMARKS
REVISIONS

BID SET
JANUARY 8, 2018

7-ELEVEN
STORE #32810
5544 RONALD REAGAN PARKWAY
DAVENPORT, FL
33896

PROJECT NO: 2016.0305
DATE: MAY 31, 2017

A2.3
ROOF PLAN

CHECKED: RW DRAWN: JUM

COPYRIGHT © 2016 INTERPLAN LLC. RESERVES COPYRIGHT & OTHER RIGHTS RESTRICTING THESE DOCUMENTS TO THE ORIGINAL INTENDED PURPOSE FOR WHICH THEY WERE PREPARED. REPRODUCTIONS, CHANGES OR ASSIGNMENTS ARE PROHIBITED.

Order Plans @ WWW.LDILine.com