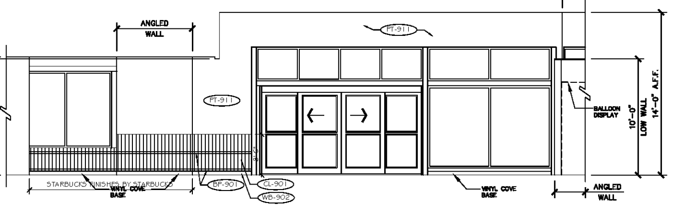

A SEATING/ STARBUCKS/ ENTRY
SCALE: 3/16" = 1'-0"

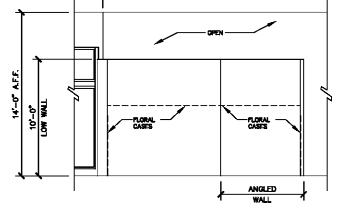

B FLORAL
SCALE: 3/16" = 1'-0"

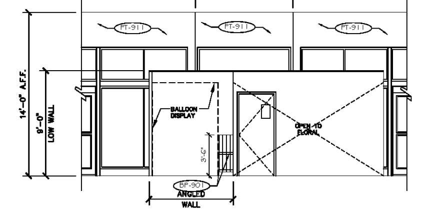

C FLORAL
SCALE: 3/16" = 1'-0"

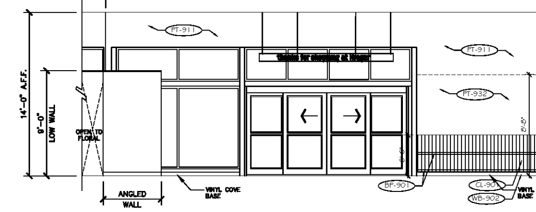

D EXIT
SCALE: 3/16" = 1'-0"

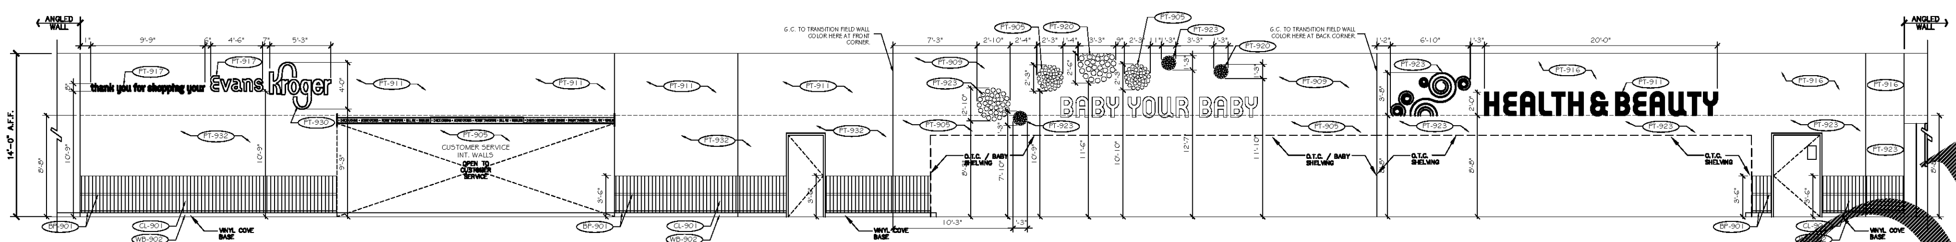

E FRONT OF STORE/ BABY/ OTC
SCALE: 3/16" = 1'-0"

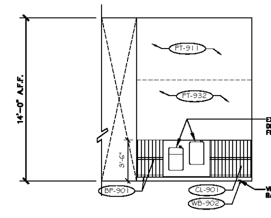

F CUSTOMER SERVICES
SCALE: 3/16" = 1'-0"

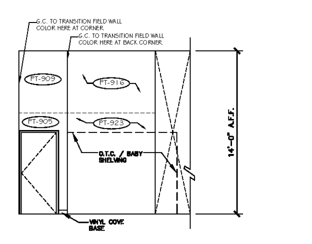

G BABY/ OTC
SCALE: 3/16" = 1'-0"

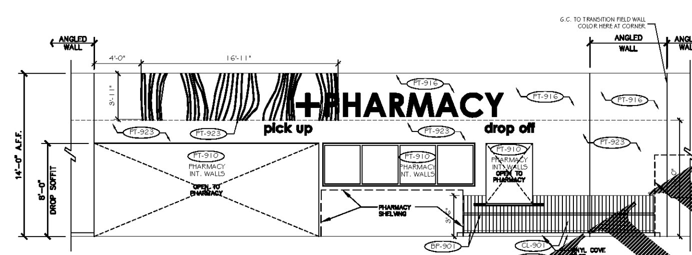

H PHARMACY
SCALE: 3/16" = 1'-0"

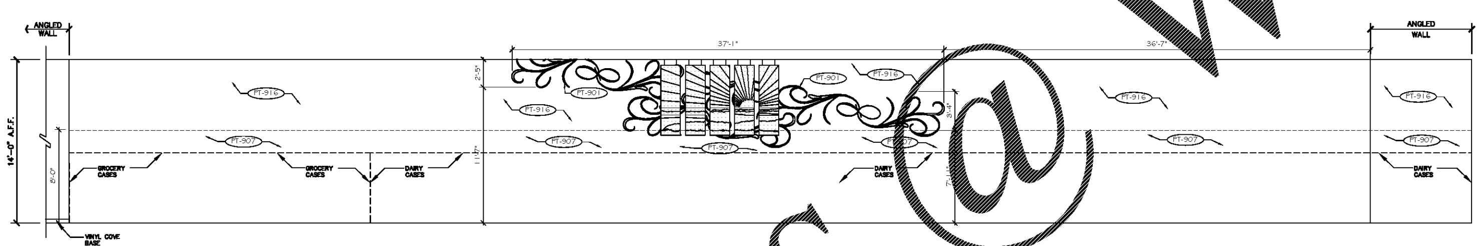

J FROZEN FOODS/ DAIRY
SCALE: 3/16" = 1'-0"

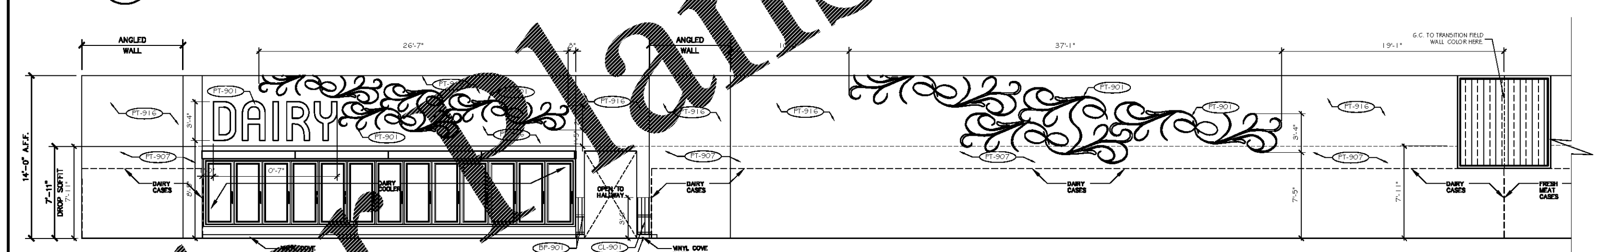

K DAIRY
SCALE: 3/16" = 1'-0"

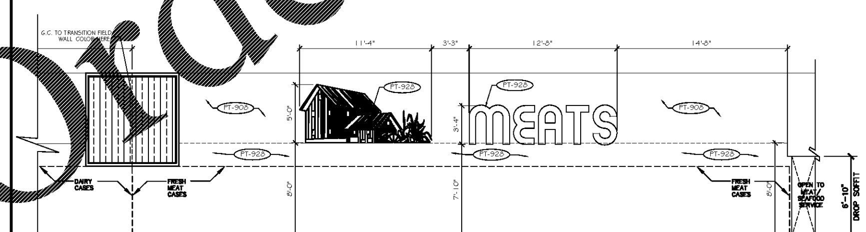

L MEATS
SCALE: 3/16" = 1'-0"

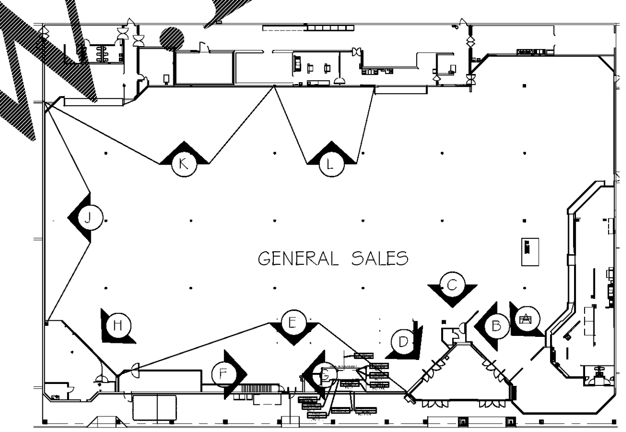

KEY PLAN
NTS

MISCELLANEOUS DECOR/FINISH NOTES:

1. FIELD VERIFY ALL WALL DECOR DIMENSIONS PRIOR TO INSTALLATION. BRING ANY MAJOR DISCREPANCIES TO IMMEDIATE ATTENTION OF CLIENT PROJECT MANAGER.

2. ALL EXPOSED HVAC AND OPEN CEILING STRUCTURE ARE NOT PAINTED. PAINT COLUMNS PT-902 FROM FLOOR TO STEEL DECK. IF STORE IS AN EXPANSION OR REMODEL, PAINT OPEN STRUCTURE TO MATCH EXISTING.

3. CEILING, BRACES, & HVAC DUCTING THAT ARE ABOVE THE LIGHT LINE ARE NOT PAINTED

4. PAINT HVAC PARALLEL TO AND ATTACHED TO WALLS TO MATCH ADJACENT WALL COLOR.

5. REMODELS: PAINT ALL MECHANICAL DUCTS THAT ARE ENTIRELY BELOW THE MAIN SALES AREA LIGHTING AND WITHIN 20' OF A WALL PT-909. IF MECHANICAL DUCT THAT IS WITHIN 20' OF WALL RUNS VERTICAL TO BE BOTH ABOVE AND BELOW THE MAIN SALES LIGHTING, THEN PAINT COLOR WILL TRANSITION 2' ABOVE LIGHTS. ABOVE TRANSITION LINE, PAINT PT-909 PAINT ALL MECHANICAL DUCTS THAT ARE MORE THEN 20' FROM WALL PT-902

6. MARKETPLACE: DO NOT PAINT ANY MECHANICAL DUCTS OR PIPING.

7. ALL HVAC WALL GRILLES TO BE PAINTED TO MATCH SURROUNDING WALL BACKGROUND COLOR (FIELD), UNLESS OTHERWISE NOTED.

8. REFER TO ARCHITECTURAL DRAWINGS FOR LAY IN CEILING COLOR AND COLUMN COLOR.

9. ALL PAINTABLE DOORS VISIBLE TO CUSTOMERS TO BE PAINTED PT-907 UNLESS FACTORY FINISHED, OR NOTED OTHERWISE

10. ALL BACKGROUND COLOR WALL FINISHES TO EXTEND 6" MINIMUM BEHIND LINE OF SIGHT AT PERMANENT FIXTURES OR CASEWORK.

11. ALL WALL PAINT FINISHES FROM FINISH FLOOR TO BE EGGSHELL. STENCIL PAINT FINISHES TO BE FLAT.

12. END OF TILE RUNS AND OUTSIDE CORNERS TO RECEIVE SCHLUTER STRIPS. REFER TO ARCHITECTURAL SPECIFICATIONS.

13. ALL CORRIDORS TRAVERSED BY, OR VISIBLE TO CUSTOMERS (STOCKROOMS OR RESTROOMS) TO RECEIVE WALL BASE AND CLADDING TO 3'-6" A.F.F. AND PAINT FROM 3'-6" A.F.F. TO CEILING, OR ROOF DECK. REFER TO FINISH ELEVATIONS FOR WALL FINISHES.

14. ALL FRONT, BACK AND UNDERSIDE OF SOFFIT TO BE PAINTED. COLOR AS INDICATED ON THE PLAN. IF COLOR IS NOT INDICATED COORDINATE WITH KROGER PM.

15. COLUMN WRAP INFORMATION TO BE FOUND IN ARCHITECTURAL FINISH SPECIFICATIONS.

16. HANG ALL DECOR AT 8'-0" A.F.F. TO BOTTOM OF DECOR UNLESS NOTED OTHERWISE ON PLAN OR ELEVATIONS.

17. REFER TO ARCHITECTURAL CONSTRUCTION DRAWINGS FOR WALL AND FLOOR FINISHES IN BACK ROOMS, STOCK ROOMS, CONFERENCE ROOMS, OFFICES, AND ANY OTHER SPACES NOT VISIBLE TO CUSTOMERS.

18. DECOR INSTALLATION CONTRACTOR TO SUPPLY AND INSTALL PAINT FOR STENCILED WALL DECOR USING STENCIL TRANSPARENCIES PROVIDED BY DECOR MANUFACTURER. DECOR INSTALLATION CONTRACTOR TO FURNISH EQUIPMENT NECESSARY TO PROJECT TRANSPARENCIES ONTO WALL AT THE SIZES INDICATED ON THE FINISH ELEVATIONS.

19. KROGER PROJECT MANAGER TO COORDINATE FINAL LOCATION OF SUSPENDED DECOR WITH VENTS TO AVOID BLOWING DECOR AROUND.

20. THE CONTRACTOR RESPONSIBLE FOR THE DECOR INSTALLATION SHALL PROVIDE ALL SUPPORTS, CABLING, AND MISCELLANEOUS HARDWARE FOR DECOR INSTALLATION. CONTRACTOR RESPONSIBLE FOR THE DECOR INSTALLATION SHALL PAINT EXPOSED SUPPORTS, BRACKETS AND FASTENERS TO MATCH ADJACENT SURFACE. NOTHING TO BE ATTACHED TO BOTTOM OF ROOF DECK OR CEILING GRID. ALL ATTACHMENTS OR CROSS MEMBERS FOR ATTACHMENT MUST BE FROM THE TOP CHORD OF JOIST.

21. PAINT NON-GALVANIZED COOLER FACES VISIBLE TO CUSTOMERS IN SERVICE PREP AREAS TO MATCH ADJACENT TILE OR CLADDING COLOR.

22. PROVIDE & INSTALL 1½" MDF TRIM AROUND FITTING ROOM ENTRY OPENINGS AND TOP OF WALLS. FINISH: PT-907

FINISH SCHEDULE (WALLS)

FOR REFERENCE ONLY. REFER TO ARCH. CD'S FOR SPECIFICATIONS.

SYMBOL	DESCRIPTION	NOTES	KROGER DIRECT BUY	FURNISHED BY G.C.
BUMPER:				
BP-901	McCUE GREENGUARD 2 #609 "DARK PUTTY"- FOR USE ON CL-901	WALL SURFACES		•
BP-902	McCUE GREENGUARD 2 #602 "BROWN"	FITTING RM. ON PERIMETER OF STORE		•
CLADDING:				
AS-901	INTERIOR ALUMINIUM STOREFRONT AND ENTRANCES COLOR - CLEAR ANODIZED	NEW CONSTRUCTION		
AS-902	INTERIOR ALUMINIUM STOREFRONT AND ENTRANCES COLOR - DARK BRONZE ANODIZED	REMODELS TO MATCH EXISTING		
BI-901	SOLAR SHADES INSOLROLL WINDOW SHADING - CHALK	SEATING AREAS		
CG-901	CORNER GUARD 3/4" x 3/4" EXTRUDED PLASTIC KOROGARD G875 - OYSTER	ENDS OF WALLCOVERING		•
CI-901	PRINTED FRP PANELING - MARLITE- VERTICAL GRAIN ARTIZAN FRP - #5408 MONTEREY SAND	WAINSCOT TO 3'-6"		•
CI-903	KEMLITE PEBBLE SURFACE WHITE- FRP PANELS (WHERE NOT VISIBLE TO CUSTOMER)	SERVICE PREP		•
CI-905	POWDER COATED STEEL COLUMN WRAP MADIX - CUSTOM PC-031 SILVER VEIN	GENERAL SALES	•	
~~CI-910~~	~~MARLITE SURFACE SYSTEMS FORMICA 7739-58 COCOA MAPLE w/ ½" NARROW REVEALS- CLEAR~~	~~FITTING ROOMS ENTRY~~	•	
CI-911	SLOTTED FIBERBOARD PANELS- 3" O.C. GROOVES COCOA MAPLE w/ ½" NARROW REVEALS- 7739-58	FLORAL WALLS		•
CI-913	MARLITE FLAT WALL PANELS - CUSTOM PATTERN ARTIZAN FRP- #5408 MONTEREY SAND ALUMINUM TRIM CORNERS ARE INCLUDED	VALUE OPTION FOR PREP WALLS		•
CI-914	CUSTOM PATTERN, PRINTED FRP PANELING - MARLITE ARTIZAN FRP - VERT. GRAIN - #1115 MADAGASCAR	SEATING AREA WAINSCOT TO 3'-6"		•
CI-915	MARLITE INDURO FRP: FPG10 HARD ROCK MAPLE CHEESE SHOP LOW WALL - CUSTOMER FACING SIDE	CHEESE SHOP LOW WALL		•
SS-904	ARISTECH - AVONITE SOLID SURFACING - F1-8106 IVORY. CAP FOR LOW WALLS LESS THAN 6'-0"	SHORT PREP WALLS		
SS-905	E.I. DU PONT DE NEMOURS & CO - CORIAN DEEP NIGHT SKY - CAP LOW WALLS LESS THAN 6'-0"	SHORT SEATING AREA WALLS		
CERAMIC TILE:				
CA-901	SCHLUTER SYSTEMS JOLLY EDGE PROTECTION - A100AT	OUTSIDE CORNER TILE WALL EDGE PROTECTION		
CT-901	LOUISVILLE TILE - MOSA RM TEN THIRTY CERAMIC TILE 4"x12", 5/16" - 13110 WHITE	MURRAY'S CHEESE TALL WALL MEAT/SEAFOOD MAIN TILE		
CT-902	LOUISVILLE TILE - MOSA RM TEN THIRTY CERAMIC TILE 4"x12", 5/16" - 13030 BROWN	MEAT & SEAFOOD PREP WALLS ACCENT DRY AGED BEEF-VERTICAL		
CT-903	LOUISVILLE TILE - URBAN COLLECTION THREADS RECTIFIED PORCELAIN TILE - 12"x24" - SAND	BAKERY PREP MAIN WALL DELI PREP ACCENT WALL		
CT-904	LOUISVILLE TILE - URBAN COLLECTION THREADS RECTIFIED PORCELAIN TILE - 12"x24" - WALNUT	DELI PREP MAIN WALL BAKERY PREP ACCENT WALL		
CT-911	DALTILE - SLATE COLLECTION NATURAL STONE TILE 12"x12" - AUTUMN MIST S772	FIREPLACE HORIZONTAL SURFACE OF RAISED HEARTH		
CT-912	DALTILE - STACKED STONE NATURAL STONE 7"x16" - SHANGHAI RUST S349	FIREPLACE SURROUND		
CT-913	AMERICAN OLEAN - GLASS TILE 3"x6" #URBKRC114 SPECTRAL DELITE #114 BRUN	WINE/GROWLER BACKSPLASH WALL BEHIND COUNTER		
CT-010	LOUISVILLE TILE - URBAN COLLECTION THREADS RECTIFIED PORCELAIN TILE - 12"x24" - OLIVE MATTE	TOILET RM. FLOORS		•
CT-011	LOUISVILLE TILE - URBAN COLLECTION THREADS RECTIFIED PORCELAIN TILE - 12"x24" - OYSTER MATTE	TOILET RM. WALLS		•
GROUT:				
GT-001	TEC ACCUCOLOR EFX EPOXY #932 MOCHA	QUARRY TILE FLOORS		•
GT-002	TEC ACCUCOLOR EFX EPOXY #933 STANDARD GRAY	TOILET RM. FLOORS		•
GT-003	TEC POWERGROUT #909 STERLING	TOILET RM. WALLS		
GT-901	TEC ACCUCOLOR EFX EPOXY #969 COFFEE	FLOORS		•
GT-902	TEC POWERGROUT #940 ANTIQUE WHITE	WALLS		•
GT-903	TEC POWERGROUT #941 RAVEN	WINE/GROWLER BAR BACKSPLASH		•
PAINT:				
PT-901	#SW 7004 - SNOWBOUND	GENERAL SALES/ DAIRY		•
PT-902	#SW 7723 - COLONY BUFF	EXPOSED COLUMNS, STEEL, CEILINGS		•
PT-903	#SW 7026 - GRIFFIN			•
PT-904	#SW 6712 - LUAU GREEN	FLORAL/ SPORTS GARDEN TRANSITIONS		•
PT-905	#SW 6710 - MELANGE GREEN	FLORAL/ GARDEN FOOD ENTRY		•
PT-906	SW 6675 - AFTERNOON	FROZEN FOOD DRYWALL		•
PT-907	#SW 6083 - SABLE	INTIMATE/ APPAREL/ SHOES/ ACCENT WALL HOLLOW METAL DOORS		•
PT-908	#SW 6655 - ADVENTURE ORANGE	DELI & BAKERY MEAT PRODUCE/ CAFE SEATING		•
PT-909	#SW 6073 - PERFECT GREIGE	SHOES/ INTIMATE/ APPAREL/ HALLWAYS/ HVAC/ SPORTS		•
PT-910	#SW 7011 - NATURAL CHOICE	PHARMACY & SEATING INTERIOR		•
PT-911	#SW 6700 - DAYBREAK	FRONT OF STORE DELI PRODUCE/ HARDWARE		•
PT-912	#SW 6494 - LAKESHORE			•
PT-913	#SW 6495 - GREAT FALLS	SERVICE MEAT SEAFOOD		•
PT-914	#SW 6654 - SURPRISE AMBER	FLORAL/ SERVICE MEAT		•
PT-915	#SW 6657 - AMBER WAVE	ALE ENTRY/ MEAT/ FLORAL		•
PT-916	#SW 6528 - COSMOS	DAIRY/ PHARMACY		•
PT-917	#SW 7025 - BACKDROP	SHOES/ APPAREL/ ENTERTAINMENT/ FRONT OF STORE		•
PT-918	#SW 6687 - LANTERN LIGHT	TOYS		•
PT-919	#SW 6334 - FLOWER POT			
PT-920	#SW 6682 - JUNE DAY	VIDEO GAMES, FRONT WALL, CUST. SERVICE/ ENERGY PLAYLAND		•
PT-921	#SW 6702 - LIVELY YELLOW	KITCHEN/ STORAGE/ LUGGAGE/ BATH/ PATIO/ FURNITURE/ PET		•
PT-922	#SW 6711 - PARAKEET	KITCHEN/ STORAGE/ LUGGAGE/ BATH/ PATIO/ FURNITURE/ PET		•
PT-923	#SW 6492 - JETSTREAM	POOL & PATIO		•
PT-924	#SW 6485 - RAIN DROP	POOL & PATIO		•
PT-925	#SW 6713 - VERDANT	HOME STENCIL		•
PT-926	#SW 6907 - FORSYTHIA	TOYS		•
PT-927	#SW 6905 - GOLDFINCH	HARDWARE/ AUTO/ PAINT		•
PT-928	#SW 6643 - YAM	MEAT/ SEAFOOD/ SEATING		•
PT-929	#SW 6621 - EMOTIONAL	MEAT/ BOOKS/ MAGAZINES/ CARDS/ PARTY		•
PT-930	#SW 6965 - HYPER BLUE	KROGER LOGO		•
PT-931	#SW 6990 - CAVIAR			•
PT-932	#SW 6674 - JONQUIL			•
PT-933	#SW 6790 - ADRIATIC SEA			•
PT-934	#SW 6676 - BUTTERFIELD			•
PT-935	#SW 6656 - SERAPE			•
PT-936	#SW 6536 - SEARCHING BLUE			•
PT-937	#SW 6716 - DANCING GREEN			•
PT-938	#SW 6718 - OVERT GREEN			•
PT-939	#SW 6607 - RED TOMATO			•
PT-940	#SW 6615 - PEPPERY			•
PT-941	#SW 6703 - FROLIC			•
PT-942	#SW 7037 - BALANCED BEIGE	EXISTING COOLER PANELS IN PREP AREA WHEN USING FRP INSTEAD OF CERAMIC TILE		•
PT-950	#SW 4091 - SILVER BRITE	METAL FRP FITTINGS AT OPEN MEZZANINE. REMODELS		•
PT-951	WOOD STAIN #SW 3134 - WEATHERED TEAK	WOOD DOORS VISIBLE TO CUSTOMER - FIELD VERIFY ONLY		
RESILIENT WALL BASE				
RT-902	FLEXCO CORP.- TRANSITION #056 MILK CHOCOLATE			•
WB-902	ROPPE- RUBBER COVE BASE #193 BLACK BROWN			•
WALL COVERING				
~~WC-903~~	~~MDC WALLCOVERING "LENTEX TRANQUILITY CREAM" - 5906TR/4755~~	~~FITTING ROOMS INTERIOR~~		•
~~WC-902~~	~~MDC WALLCOVERING "LENTEX TRANQUILITY DRIFTWOOD" - 5903TR/4755~~	~~FITTING ROOMS EXTERIOR~~		•
~~WC-901~~	~~MDC WALLCOVERING STRAIGHT UP W2-SU-14 SANDSTONE 4755 (OPTIONAL)~~	~~PHARMACY INT. WALLS & WAITING AREA~~		•
CG-901	KOROGARD CORNER GUARD - G875 OYSTER			•

dfab DESIGN FABRICATIONS
EAST MANDOLINE AVE.
SUITE 100
MADISON HEIGHTS, MI 48071
T 248.___.9440
F 248.597.0989
designers@dfabdesign.com

COPYRIGHT © 2017

ALL DRAWINGS AND DESIGNS ARE THE SOLE PROPERTY OF DESIGN FABRICATIONS, INC. THESE DRAWINGS ARE NOT TO BE COPIED WITHOUT WRITTEN CONSENT FROM DESIGN FABRICATIONS, INC. THESE DRAWINGS WERE PREPARED EXCLUSIVELY FOR THIS PROJECT. IT IS ILLEGAL FOR UNAUTHORIZED PERSONS TO USE THESE DRAWINGS OR DESIGNS FOR ANY OTHER PROJECT.

DO NOT SCALE DRAWINGS- USE FIGURED DIMENSIONS ONLY.

SHEET TITLE
FINISH ELEVATIONS

PROJECT NAME
KROGER GA-414

PROJECT LOCATION
4355 WASHINGTON RD.
EVANS, GA

ISSUED FOR	DATE
80% REVIEW	01/26/18

NO.	REVISED BY:	DATE
△	XXX	XXX

DRAWN: AM
CHECKED: SW
SCALE: 3/16"=1'-0"
JOB NO.: 1711-03
SHEET #: I2.1

Order Plans @ WWW.LDILine.com