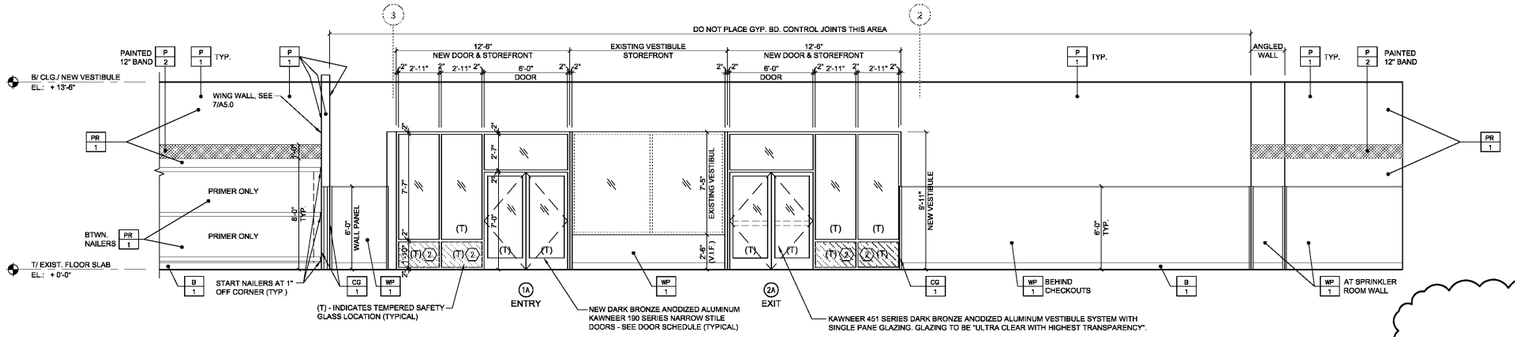

3 A1.2 INTERIOR ELEVATION DETAIL AT STOREFRONT

SCALE: 1/4"=1'-0"

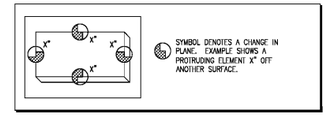

SYMBOL DENOTES A CHANGE IN PLANE. EXAMPLE SHOWS A PROTRUDING ELEMENT X" OFF ANOTHER SURFACE.

WINDOW FILM LEGEND

1. SOLARGARD 7 MIL CLEAR ANTI-GRAFFITI WINDOW FILM (BY SAINT-GOBAIN) ON EXTERIOR FACE OF ALL DOOR GLAZING AND STOREFRONT WINDOW GLAZING FULL HEIGHT (OMIT FILM AT ENTRY DOOR TRANSOM). NOTE: CC TO COORDINATE ANTI-GRAFFITI FILM TO INSTALL AFTER DD'S DEPARTMENT BANDS.
2. 3M #324 "FROSTED WHITE CRYSTAL" AT INSIDE FACE OF ALL INTERIOR VESTIBULE GLAZING BELOW +24" AFF.
4. SOLARGARD 7 MIL CLEAR ANTI-GRAFFITI WINDOW FILM (BY SAINT-GOBAIN) ON EXTERIOR WINDOW GRAPHICS AND SECURITY FILM ON WINDOWS ON INTERIOR.

DEPARTMENT BAND @ STOREFRONT WINDOWS

GLAZING [illegible] 4" MINIMUM

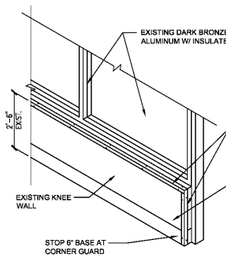

4 A1.2 VESTIBULE KNEE WALL DETAIL (AT INTERIOR)

SCALE: NONE

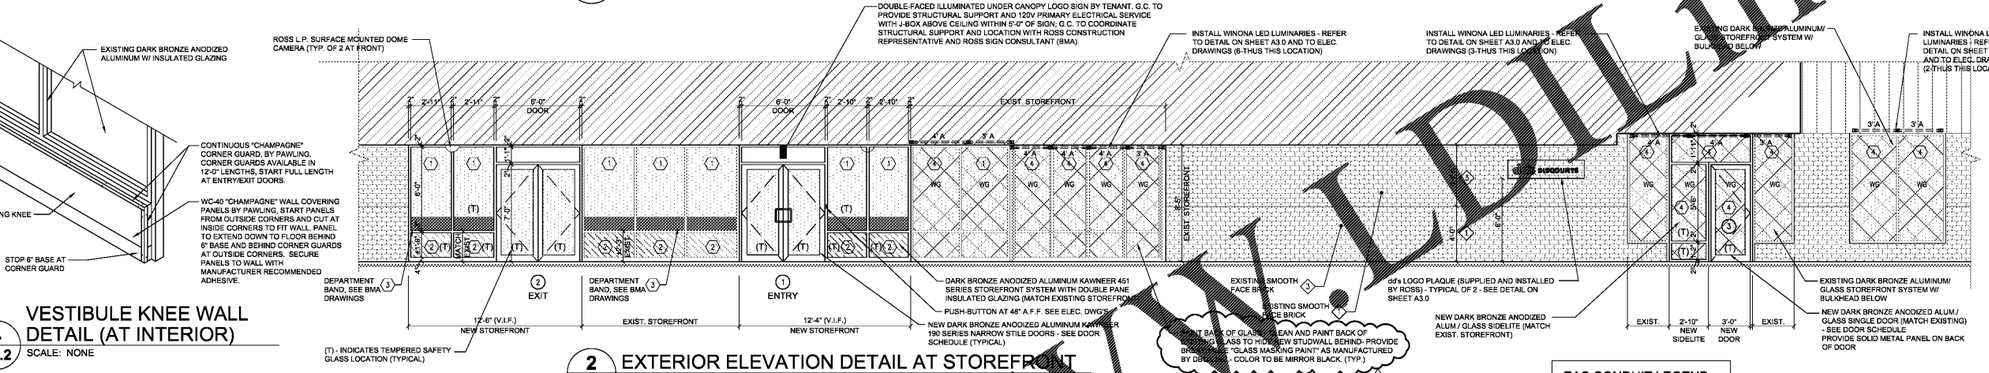

2 A1.2 EXTERIOR ELEVATION DETAIL AT STOREFRONT

SCALE: 1/4"=1'-0"

EAS CONDUIT LEGEND

- 3/4" UNDER-SLAB CONDUIT WITH DEDICATED LP EAS, PHASE MATCHED , 20 AMP, 120V, 24 HR CIRCUIT WIRING FROM J-BOX TO PEDESTAL STUBS ALL PROVIDED AND INSTALLED BY G.C. PRIOR TO PROJECT TURN-OVER.
- 3/4" UNDERSLAB CONDUITS WITH PULL-STRINGS AND 1" STUBS INSTALLED BY G.C. PRIOR TO PROJECT TURN-OVER AND READY FOR INSTALLATION OF LOW VOLTAGE EAS WIRING BY TENANT'S LOSS PREVENTION VENDOR.

SEE MODULAR SYSTEM LEGEND SHEET E3.0

INTERIOR SECURITY CAMERAS WILL BE INSTALLED IN ACCORDANCE WITH A LOCATION PLAN PREPARED BY ROSS LOSS PREVENTION. CONFIRM CAMERA LOCATIONS WITH THE ROSS CONSTRUCTION REPRESENTATIVE PRIOR TO INSTALLATION OF BOXES

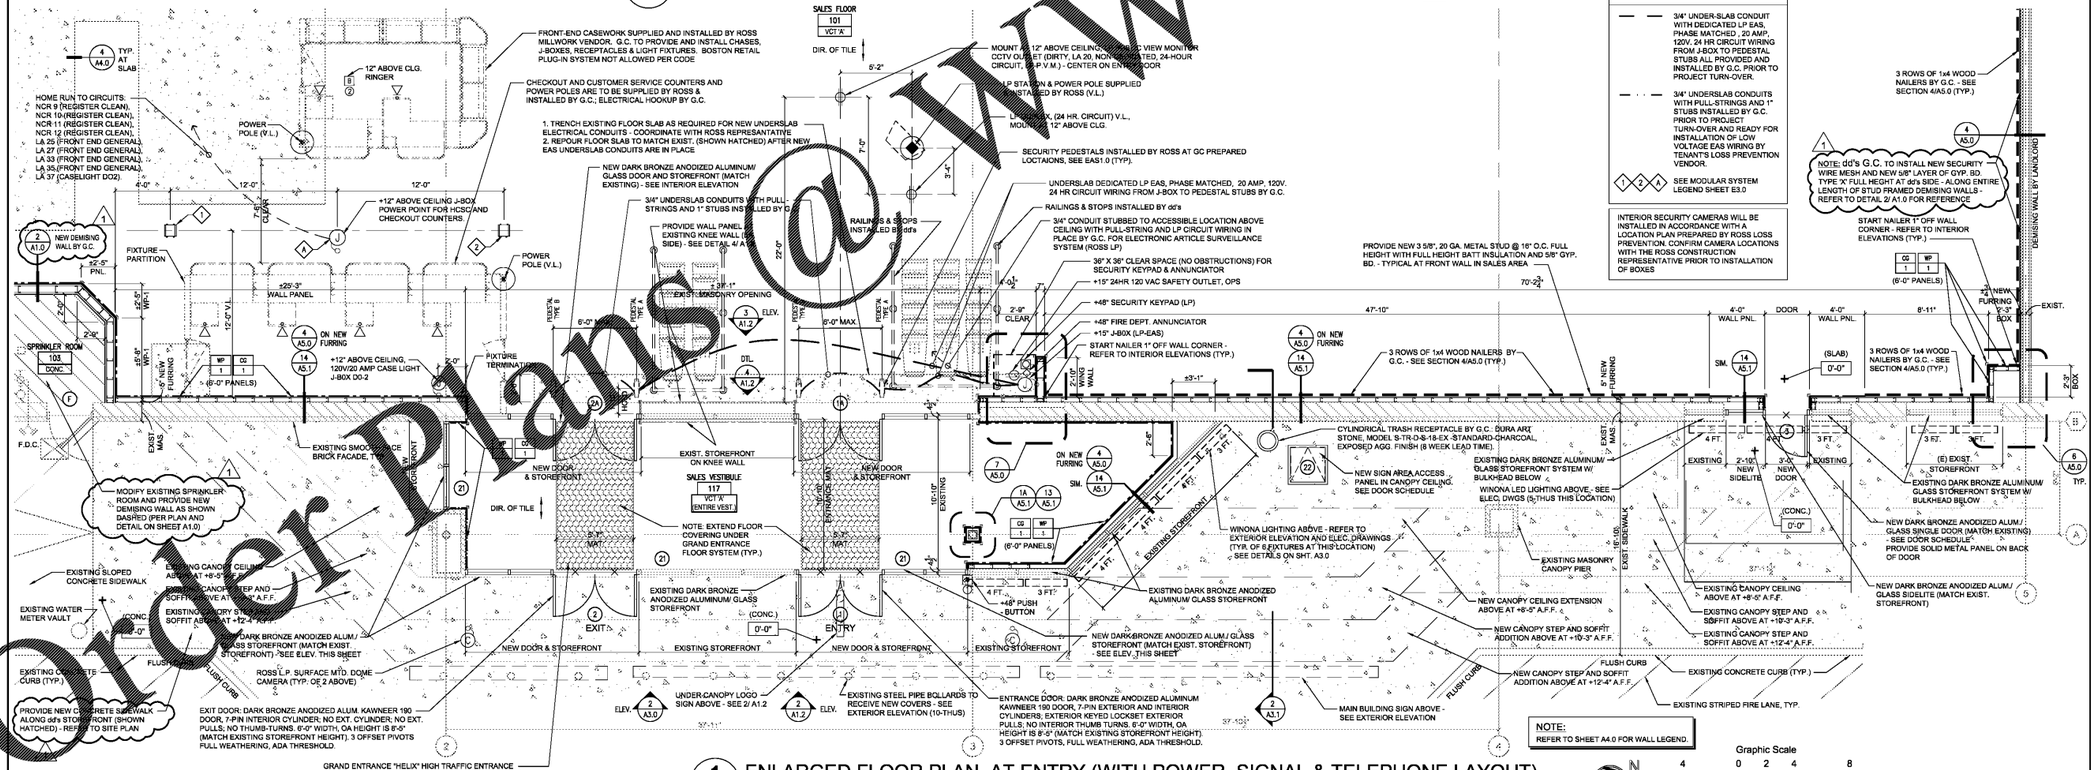

NOTE: REFER TO SHEET A4.0 FOR WALL LEGEND.

1 A1.2 ENLARGED FLOOR PLAN AT ENTRY (WITH POWER, SIGNAL & TELEPHONE LAYOUT)

SCALE: 1/4" = 1'-0"

Graphic Scale: 4 0 2 4 8 (In Feet) 1 Inch = 4 Feet

Order Plans @ WWW.DDLine.com

ANTHONY CASSATA ARCHITECT
2803 [illegible] SUITE 340
OAK BROOK, IL 60523
TEL: (312) 795-1245
FAX: (312) 795-1423

dd's DISCOUNTS

OWNER:

ROSS STORES
5130 HACIENDA DRIVE
DUBLIN, CA 94568

PROJECT:

dd's DISCOUNTS
STORE #5352
(GREENVILLE, SC)

WHITE HORSE PLAZA
6119 WHITE HORSE ROAD
GREENVILLE, SC 29611

BASED ON DD'S 22K TURNKEY - EXISTING PROTOTYPE DATED MARCH, 2018

DRAWING TITLE: ENLARGED FLOOR PLAN AT ENTRY AND ELEVATIONS

REV. NO.:	DATE:	DESCRIPTION:
1	06/07/18	FOR ROSS REVIEW
2	07/12/18	ROSS MARK-UPS

STATE OF SOUTH CAROLINA — ANTHONY CASSATA — Oak Brook, IL — 3414 — REGISTERED ARCHITECT

EXPIRES: 6/30/2018

COPYRIGHT: ALL DRAWN AND WRITTEN INFO. APPEARING HEREIN SHALL NOT BE DUPLICATED, DISCLOSED OR OTHERWISE WITHOUT WRITTEN CONSENT.

PFDA JOB: #16027

SCALE: AS NOTED

DRAWN BY: CHECKED BY:

SHEET NUMBER

A1.2