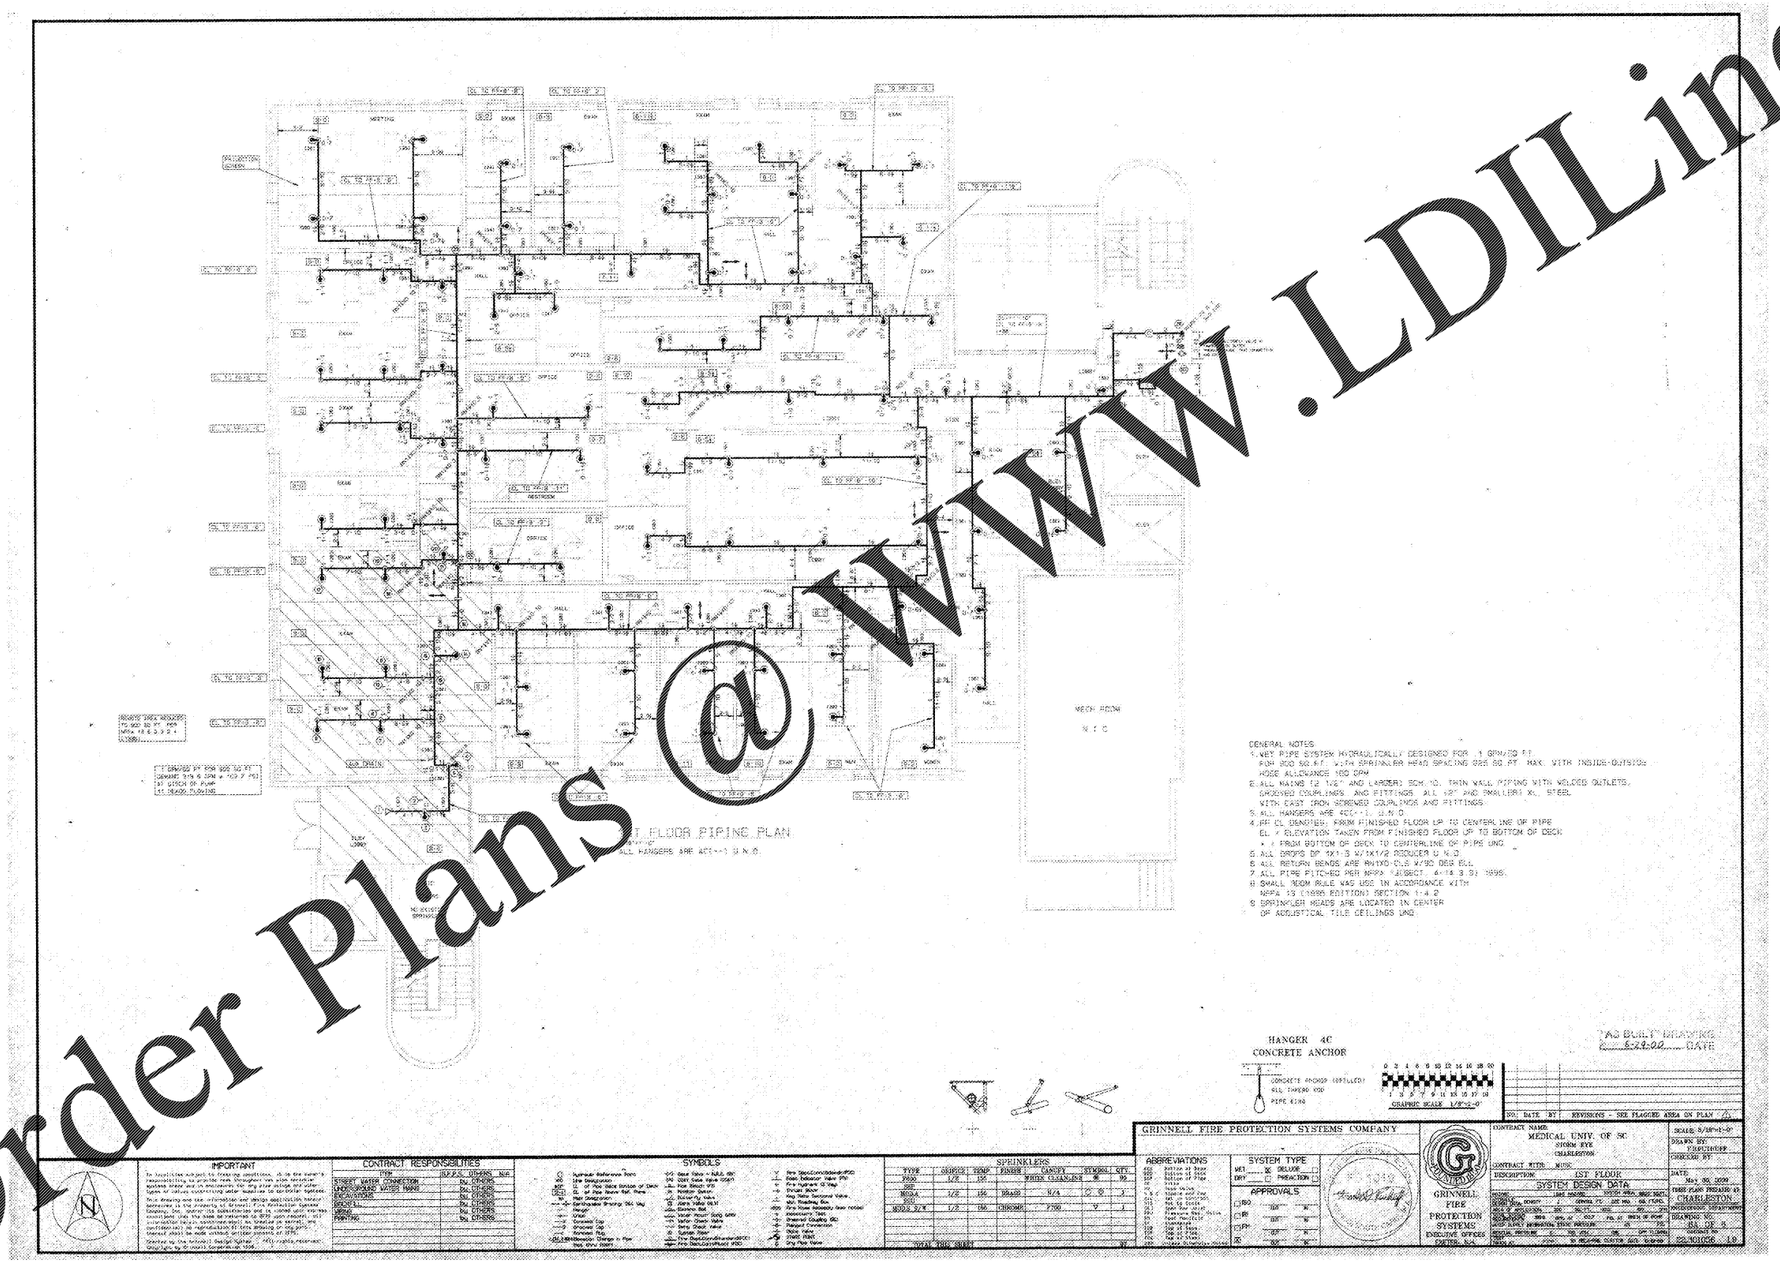

Order Plans @ WWW.LDILine.com

SEALS
© COPYRIGHT 2017 ROSENBLUM COE ARCHITECTS, INC.
THIS DRAWING HAS BEEN PREPARED BY ROSENBLUM COE ARCHITECTS, INC. FOR USE ON THE PROJECT AND IS AN INSTRUMENT OF THE ARCHITECT'S SERVICE. ANY UNAUTHORIZED USE OF WITH RESPECT TO THIS DRAWING BY ANY OTHER ARCHITECT SHALL BE DEEMED TO BE THE AUTHOR OF THIS DOCUMENT INFRINGEMENT OF COPYRIGHT AND OTHER STATUTORY AND OTHER RESERVED RIGHTS, INCLUDING THIS COPYRIGHT.

NOTES

GENERAL NOTES

1. AS-BUILT FIRE PROTECTION SYSTEM DRAWINGS ARE PROVIDED FOR CONTRACTOR'S REFERENCE ONLY TO ASSIST WITH DESIGN FLOW RATE CALCULATIONS AS REQUIRED BY NFPA-13 (2013) 8.15.20.5.2.

MUSC
MEDICAL UNIVERSITY of SOUTH CAROLINA

PROJECT NUMBER: H51-50068

DHEC PROJECT NUMBER: 580145

CONSTRUCTION DOCUMENTS

STORM EYE INSTITUTE
OPTICAL SHOP
H51-50068

167 ASHLEY AVE
CHARLESTON, SC 29425

ROSENBLUM COE ARCHITECTS, INC.
1643 MEANS STREET
CHARLESTON, SC 29412
843.577.6073

FIRE PROTECTION CRAWL SPACE AS-BUILTS

SHEET NAME

PROJECT NUMBER 17016

DRAWN BY TSN

CHECKED BY MER

DATE 05/09/2018

SCALE

FP302