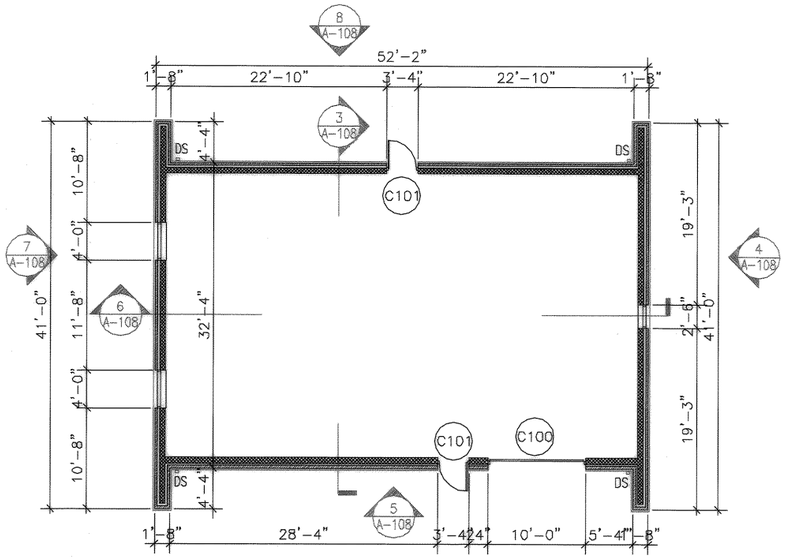

FLOOR PLAN

1 A-108 — 1/8"=1'-0"

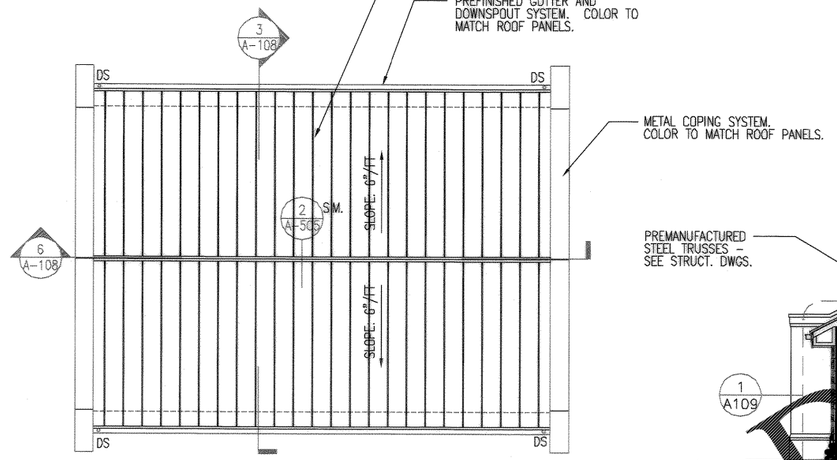

ROOF PLAN

2 A-108 — 1/8"=1'-0"

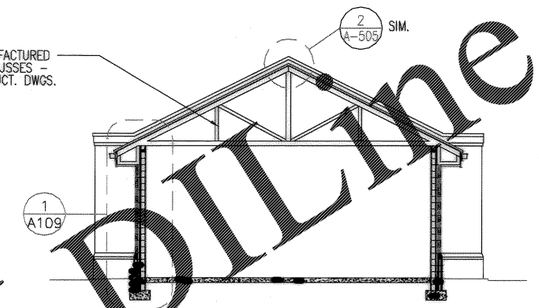

BUILDING SECTION

3 A-108 — 1/8"=1'-0"

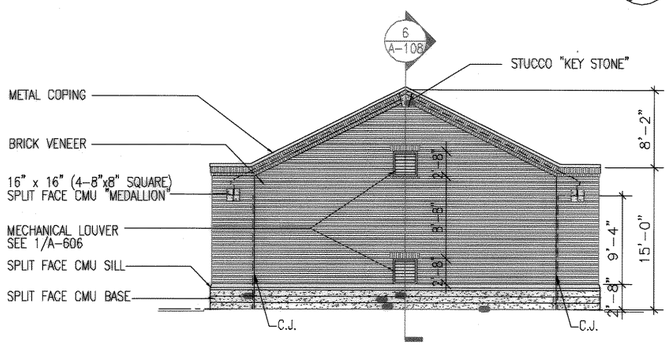

SOUTH ELEVATION

4 A-108 — 1/8"=1'-0"

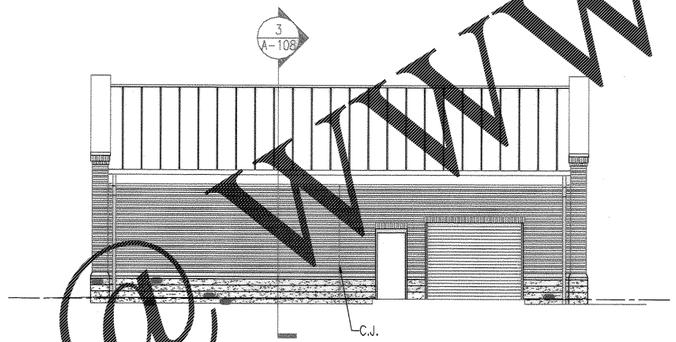

WEST ELEVATION

1 A-108 — 1/8"=1'-0"

BUILDING SECTION

6 A-108 — 1/8"=1'-0"

NORTH ELEVATION

2 A-108 — 1/8"=1'-0"

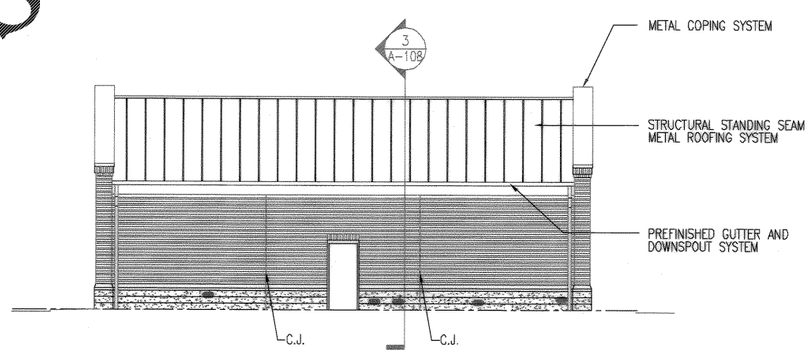

EAST ELEVATION

8 A-108 — 1/8"=1'-0"

NOTE: CHILLER PLANT REPLACEMENT OPTION ACROSS DAVIS DRIVE

0 4' 8' 16'

SCALE: 1/8"=1'

LEGEND:

- BRICK VENEER WITH 8" CMU BACK UP
- C101 — DOOR DESIGNATION – SEE SHEET A-601
- DS — DOWNSPOUT WITH PREFORMED CONCRETE SPLASH BLOCK
- C.J. — CONTROL JOINT. SEE 3/B-A501.

Glick/Boehm & Associates, Inc.
247 Meeting Street, Suite 100
Charleston, S.C. 29401 (803) 577-6377

DESIGN BOEHM DR BY DIRK CHK BOEHM
CH ENGR
SUBMITTED BY (FIRM MEMBER-TITLE): MGE PRES. DATE 9-22-98
TECHNICAL BRANCH
FILE

DRAWING REVISIONS

Rev.	Description	Prep. By	Date	Apprvd.
1	DRWG. CORRECTED TO AS-BUILT	MJJ	5/11/04	RDM

CHARLESTON AIR FORCE BASE CHARLESTON, SOUTH CAROLINA

DINING FACILITY

CHILLER PLANT REPLACEMENT OPTION

APPROVED RDMac DATE 5/11/04 EFD FOR COMMANDER, NAVFAC

Naval Facilities Engineering Command
Southern Division
Charleston, South Carolina

STATE OF SOUTH CAROLINA
GLICK/BOEHM & ASSOCIATES, INC.
CHARLESTON NO. B-80006
REGISTERED ARCHITECT

RECORD DRAWING DATE 9/27/04
CODE I.D. NO. 80091
DRAWING SIZE: D
SPEC. NO. 06-98-0939
CONSTRN. CONTR. NO. N62467-98-C-0939
NAVFAC DRAWING NO. 5357886
SHEET 61 OF 194

A-108

Order Plans @ www.LDILine.com

468-134