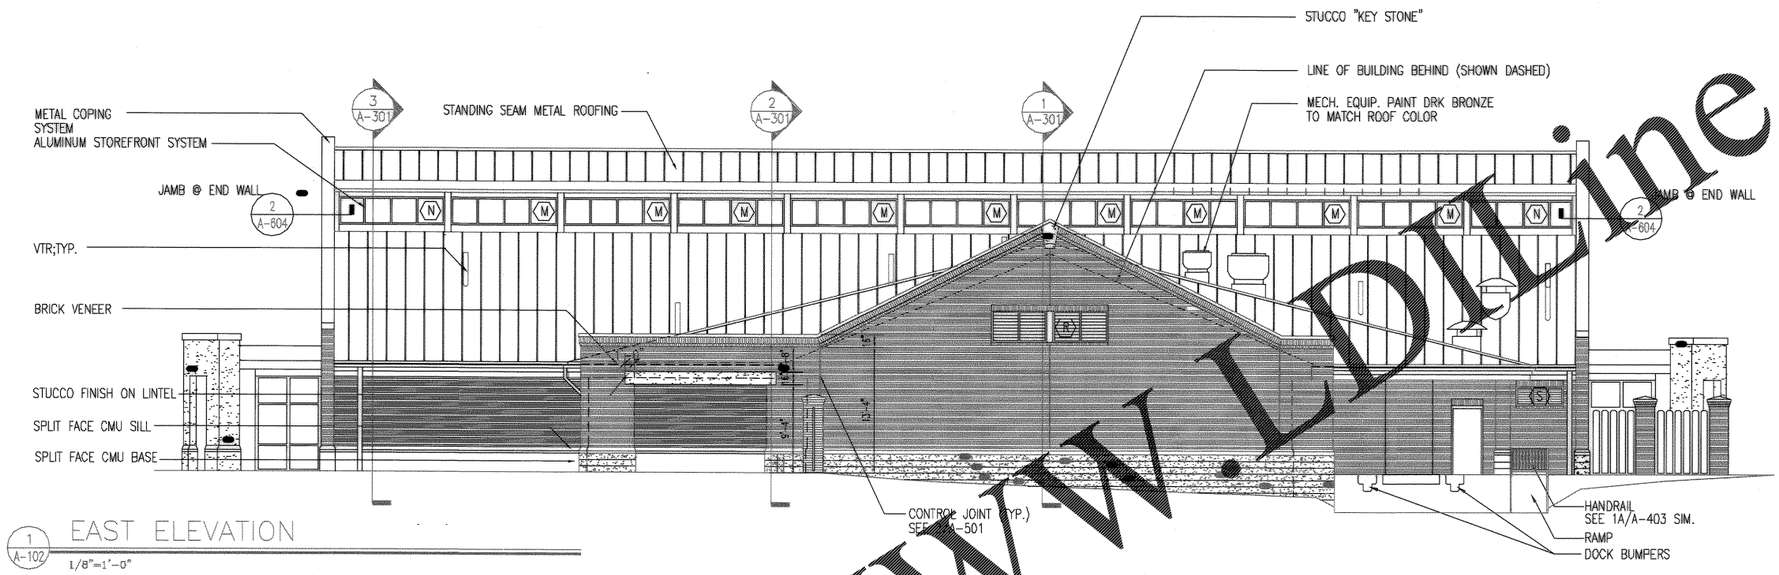

1 A-102 EAST ELEVATION

1/8"=1'-0"

LEGEND

(X) WINDOW MARK, SEE SCHEDULE ON SHEET A-601

C.J. CONTROL JOINT SEE 2/A-501

0 4' 8' 16'

SCALE: 1/8" = 1'

Order Plans @ WWW.LDline.com

Glick/Boehm & Associates, Inc.
247 Meeting Street, Suite 100
Charleston, S.C. 29401 (803) 577-6377

DRAWN: BOEHM
DES: SULLIVAN
CH: BOEHM
QA: GH ENGR
SUBMITTED BY (FIRM MEMBER-TITLE): MCE PRES. 8-22-98
TECHNICAL BRANCH
PM: PWE

DRAWING REVISIONS

Rev.	Description	Prep By	Date	Approvd.
1	AS-BUILT DRWG. INC CORRECTIONS	KLW	9/16/04	

CHARLESTON AIR FORCE BASE CHARLESTON, SOUTH CAROLINA

DINING FACILITY

EXTERIOR ELEVATIONS

APPROVED: RM Mac Pe DATE: 6/11/98 ED FOR COMMANDER, NAVFAC

Naval Facilities Engineering Command
Southern Division
Charleston, South Carolina

STATE OF SOUTH CAROLINA
GLICK/BOEHM & ASSOCIATES, INC.
CHARLESTON
NO. B-80008
REGISTERED ARCHITECT

RECORD DRAWING DATE: 9/27/04
CODE I.D. NO. 80091
DRAWING SIZE: D
SPEC. NO. 05-98-0939
CONSTRN. CONTR. NO. N62467-98-C-0939
NAVFAC DRAWING NO. 5357890
SHEET 65 OF 194

A-203

468-130