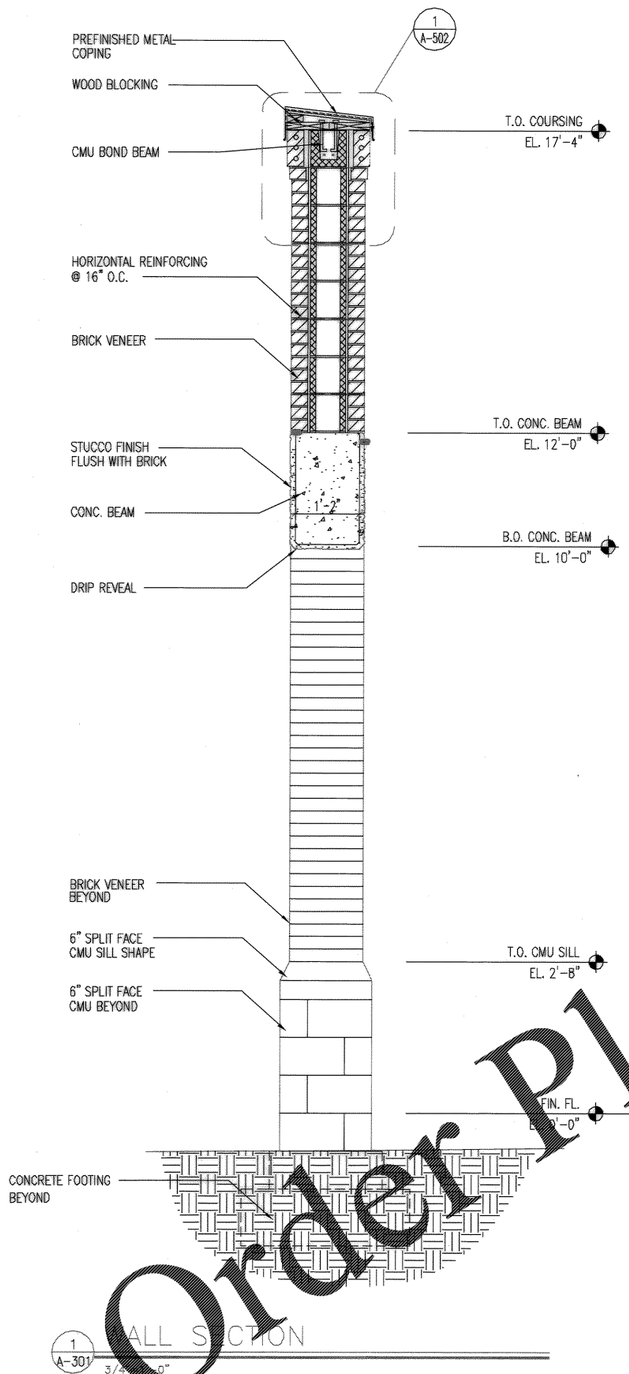

1 A-301 WALL SECTION 3/4"=1'-0"

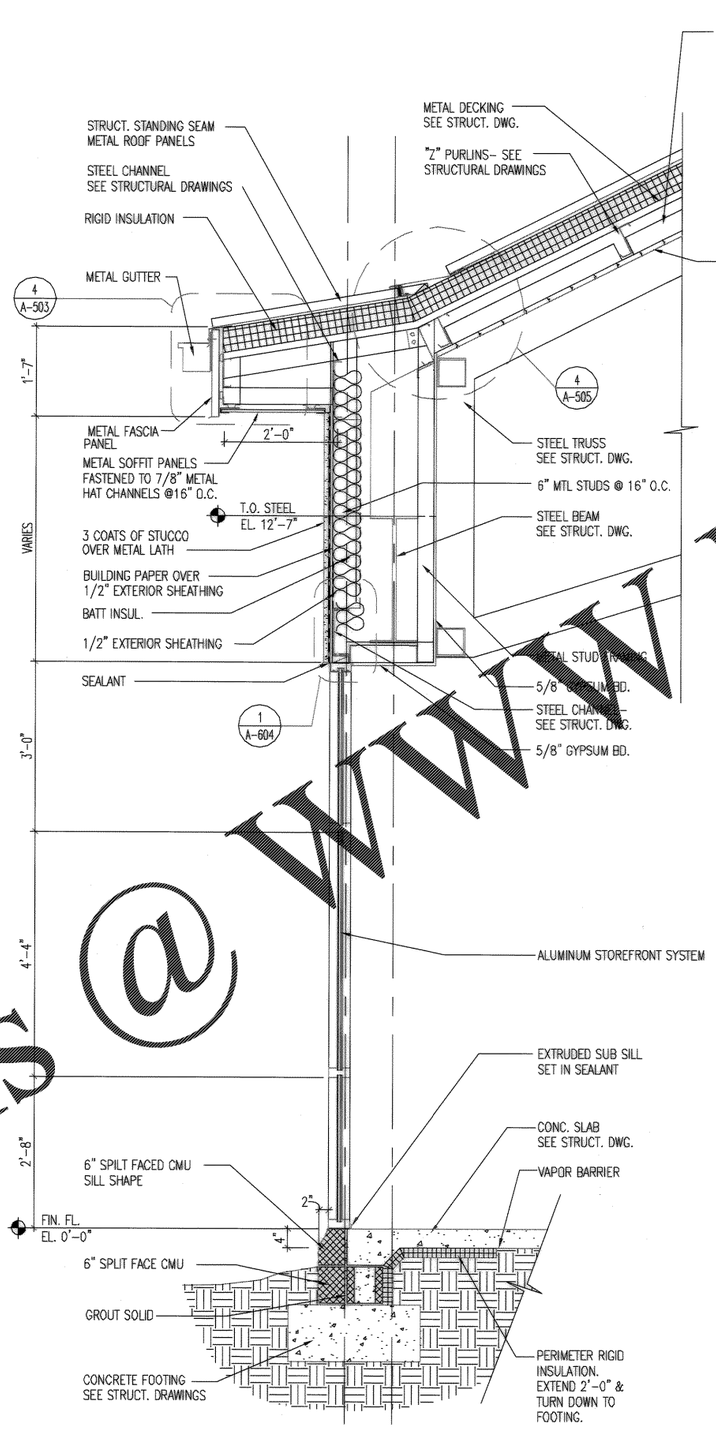

2 A-301 WALL SECTION 3/4"=1'-0"

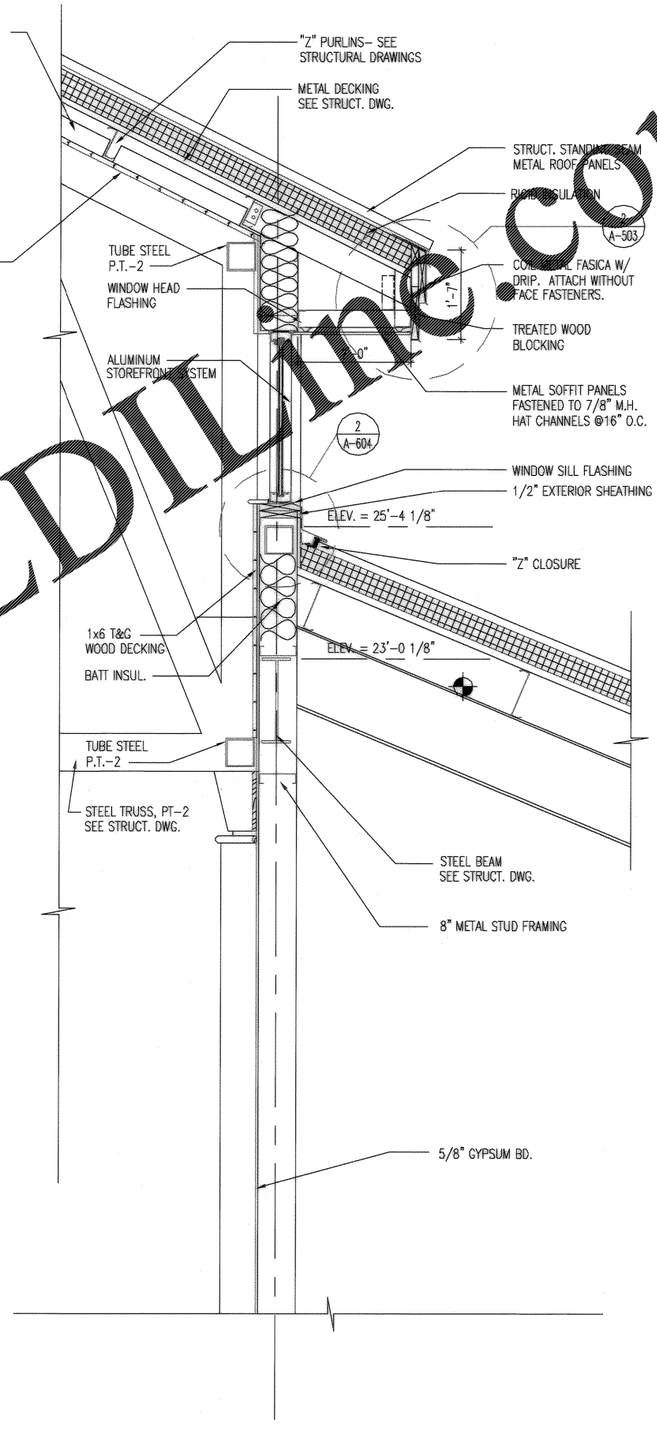

3 A-301 WALL SECTION 3/4"=1'-0"

0 1' 2' 4'
SCALE: 3/4" = 1'

Order Plans @ WWW.LDIInc.com

Glick/Boehm & Associates, Inc.
247 Meeting Street, Suite 100
Charleston, S.C. 29401 (803) 577-6377

DRAWING REVISIONS

Rev.	Description	Prep By	Date	Apprvd.
1	AS-BUILT DRWG. NO CORRECTIONS	HW	9/27/09	

DSN BOEHM DRN SULLIVAN CH BOEHM GR ENGR

SUBMITTED BY (FIRM NAME-TITLE): MGE PRES. 9-25-98
TECHNICAL BRANCH
FILE

CHARLESTON AIR FORCE BASE CHARLESTON, SOUTH CAROLINA

DINING FACILITY

WALL SECTIONS

APPROVED [signature] DATE 9/25/98 EFD FOR COMMANDER, NAVFAC

Naval Facilities Engineering Command
Southern Division
Charleston, South Carolina

STATE OF SOUTH CAROLINA
GLICK/BOEHM & ASSOCIATES, INC.
CHARLESTON NO. B-80006
REGISTERED ARCHITECT

RECORD DRAWING DATE 9/27/09
CODE I.D. NO. 80091
DRAWING SIZE: D
SPEC. NO.06-98-0939
CONSTRN. CONTR. NO. N62467-98-C-0939
NAVFAC DRAWING NO. 5357893
SHEET 68 OF 194

A-303

468-127