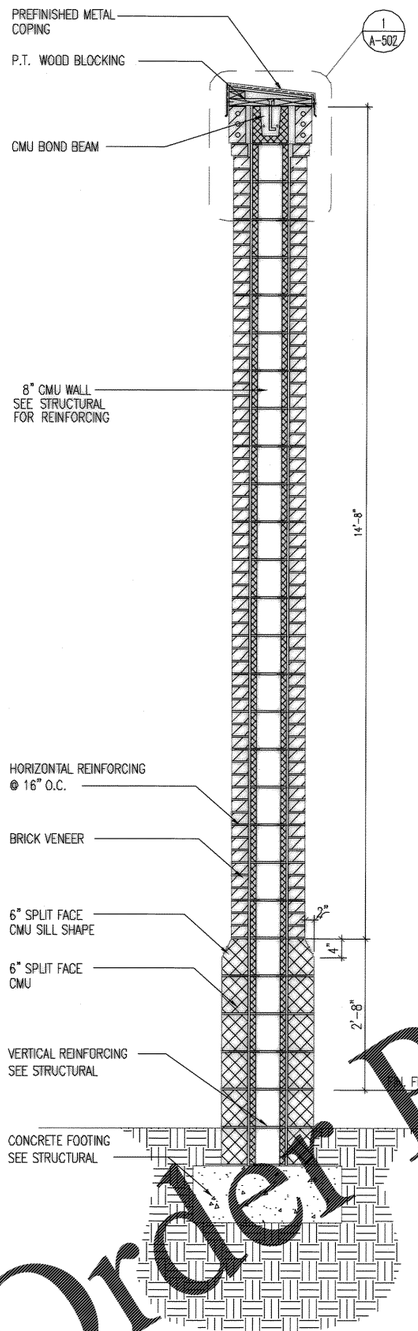

1 A-301 WALL SECTION
3/4"=1'-0"

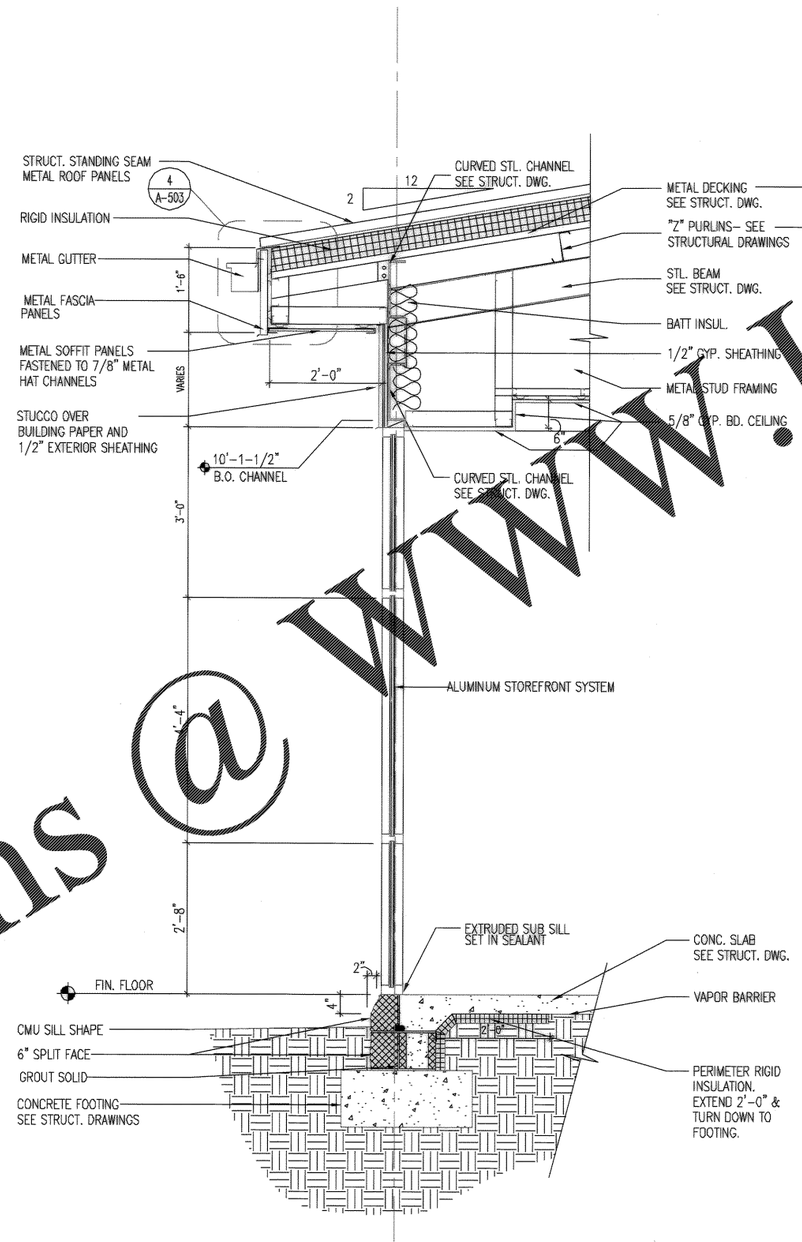

2 A-301 WALL SECTION
3/4"=1'-0"

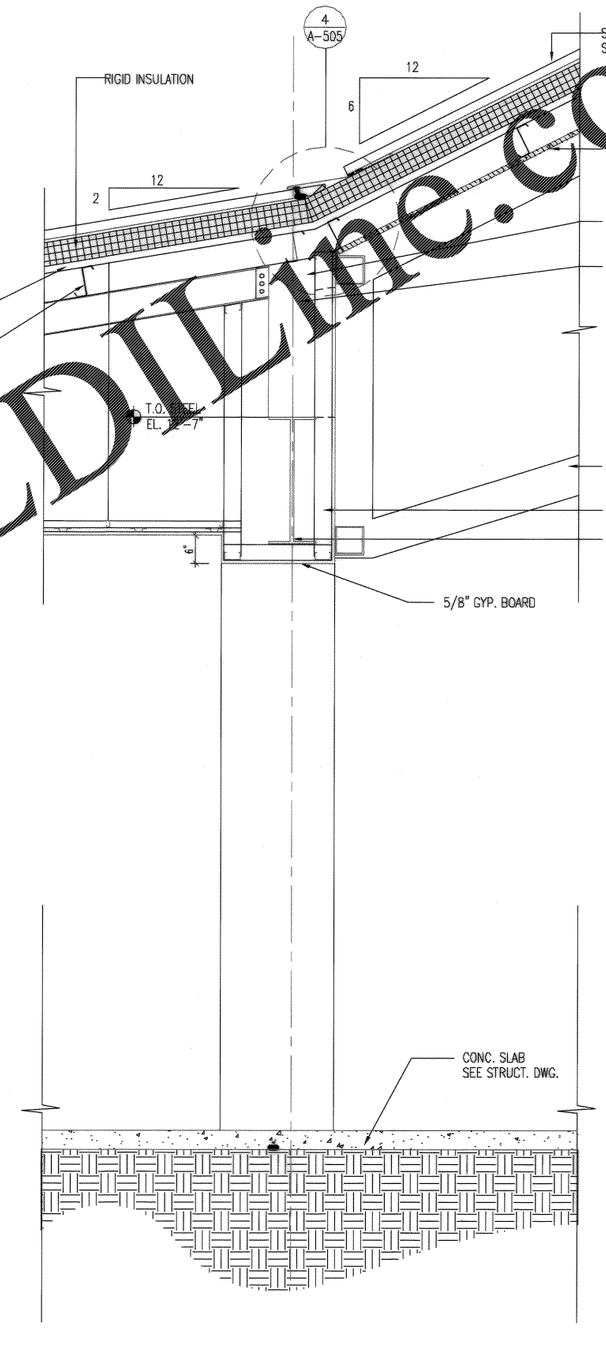

3 A-301 WALL SECTION
3/4"=1'-0"

0 1' 2' 4'
SCALE: 3/4" = 1'

DRAWING REVISIONS

Rev.	Description	Prep. By	Date	Apprvd.
1	AS-BUILT DRWG. NO CORRECTIONS	RH	9/16/04	BWB

Glick/Boehm & Associates, Inc.
247 Meeting Street Suite 100
Charleston, S.C. 29401 (803) 577-6377

DSN BOEHM DR SULLIVAN CHK BOEHM APV CIV ENGR

SUBMITTED BY (FIRM MEMBER-TITLE): WGE PRES. 9-22-05 DATE
TECHNICAL BRANCH
FPE

CHARLESTON AIR FORCE BASE CHARLESTON, SOUTH CAROLINA

DINING FACILITY

WALL SECTIONS

APPROVED [signature] DATE 9/16/04

Naval Facilities Engineering Command
Southern Division
Charleston, South Carolina

STATE OF SOUTH CAROLINA
GLICK/BOEHM & ASSOCIATES, INC.
CHARLESTON
NO. B-80006
REGISTERED ARCHITECT

RECORD DRAWING DATE 9/27/04
CODE I.D. NO. 80091
DRAWING SIZE: D
SPEC. NO. 06-98-0939
CONSTRN. CONTR. NO. N62467-98-C-0939
NAVFAC DRAWING NO. 5357894
SHEET 69 OF 194

A-304

ETD FOR COMMANDER, WAFAC

WWW.LDILine.com
Order Plans @ WWW

468-126