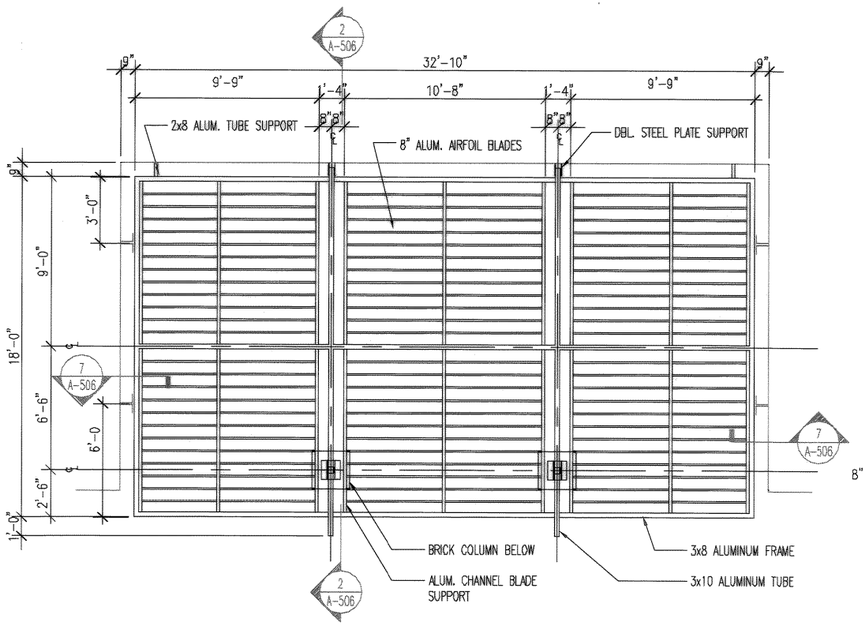

1 A-103 ENLARGED TRELLIS PLAN
SCALE: 1/4"= 1'-0"

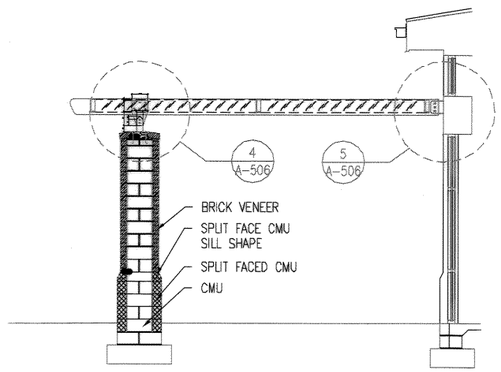

2 A-506 ENLARGED TRELLIS PLAN
SCALE: 1/4"= 1'-0"

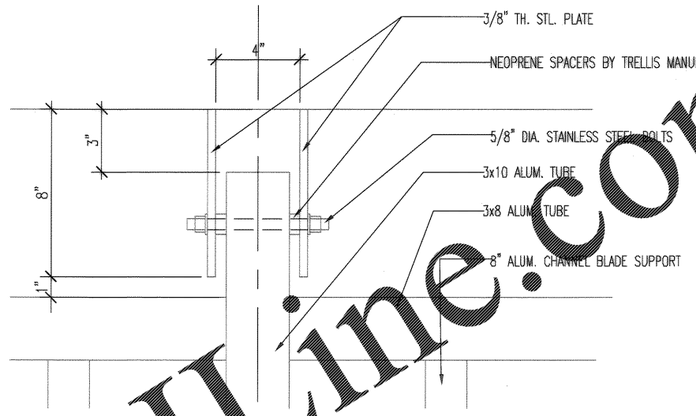

A-506 TRELLIS SUPPORT PLAN DETAIL
SCALE: = 1'-0"

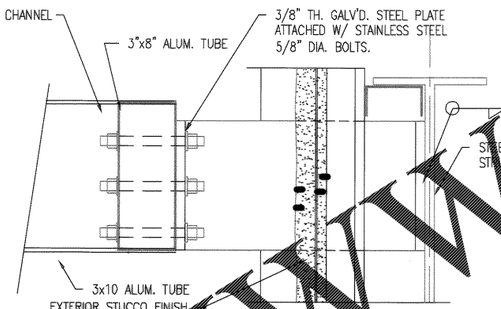

7 A-506 TRELLIS SUPPORT DETAIL
SCALE: 3"= 1'-0"

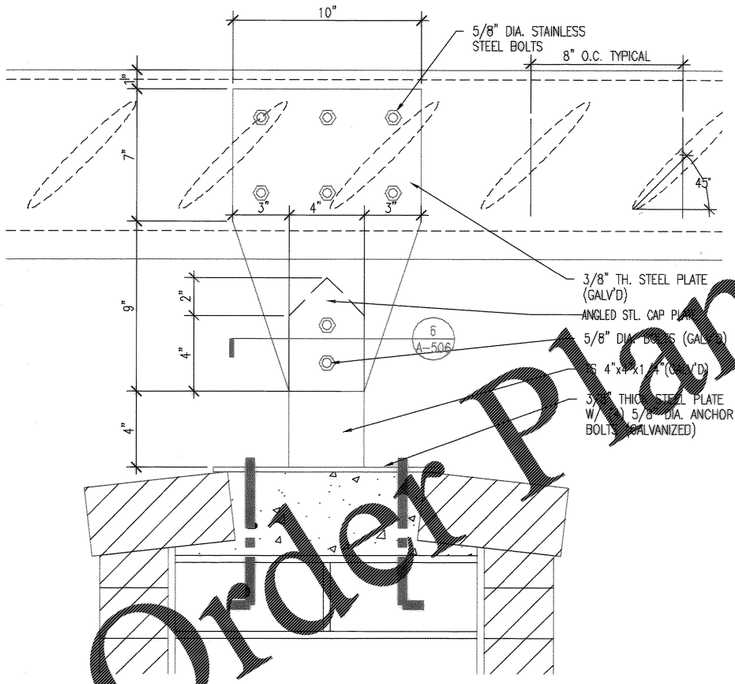

4 A-506 TRELLIS SUPPORT DETAIL
SCALE: 3"= 1'-0"

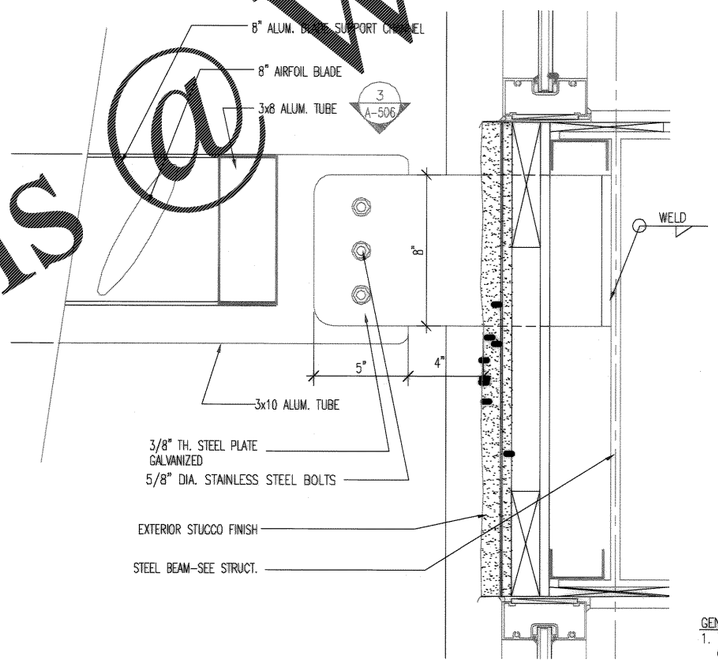

5 A-506 TRELLIS SUPPORT DETAIL
SCALE: 3"= 1'-0"

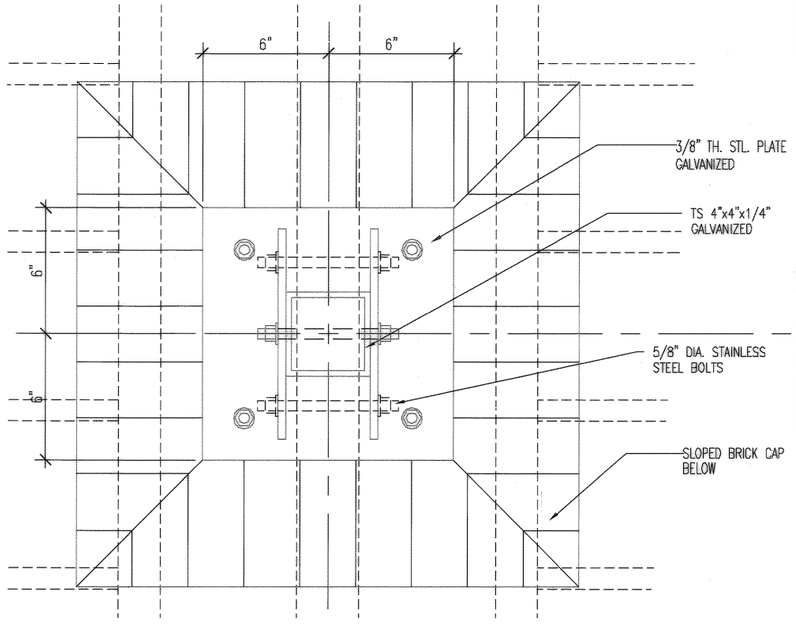

6 A-506 TRELLIS SUPPORTPLAN DETAIL
SCALE: 3"= 1'-0"

GENERAL NOTES
1. TRELLIS MANUFACTURER SHALL PROVIDE SPACERS, WASHERS, COATINGS, ETC. AS REQUIRED TO PREVENT CONTACT BETWEEN DISSIMILAR METALS.
2. ALL ALUMINUM SHALL HAVE A WHITE KYNAR FINISH. ALL OTHER METALS SHALL BE PAINTED WHITE TO MATCH ALUMINUM.

0 2' 4' 8'
SCALE: 1/4" = 1'

0 3" 6" 1'
SCALE: 3" = 1'-0"

Click/Boehm & Associates, Inc.
247 Meeting Street
Charleston, S.C. 29401 (803) 577-6377

DRAWING REVISIONS

Rev.	Description	Prep By	Date	Apprvd.
1	AS-BUILT DRWG. NO CORRECTIONS	MJH	5/11/04	BWW

CHARLESTON, SOUTH CAROLINA

CHARLESTON AIR FORCE BASE

DINING FACILITY

TRELLIS DETAILS

APPROVED RD Morris, PE DATE 5/11/04

CHK	BOEHM		
DR	JCS		
CH ENGR	BOEHM		
	SUBMITTED BY (FIRM MEMBER-TITLE):		DATE
	MAC PRES.		8-22-98
	TECHNICAL BRANCH		
	FPE		

Naval Facilities Engineering Command
Southern Division
Charleston, South Carolina

STATE OF SOUTH CAROLINA
CLICK/BOEHM & ASSOCIATES, INC.
CHARLESTON NO. B-80006
REGISTERED ARCHITECT

RECORD DRAWING DATE 9/27/04
CODE I.D. NO. 80091
DRAWING SIZE: D
SPEC. NO. 06-98-0939
CONSTRN. CONTR. NO. N62467-98-C-0939
NAVFAC DRAWING NO. 5357911
SHEET 86 OF 194

A-506

EFD FOR COMMANDER, NAVFAC

Order Plans @ WWW.LDILine.com

468-109