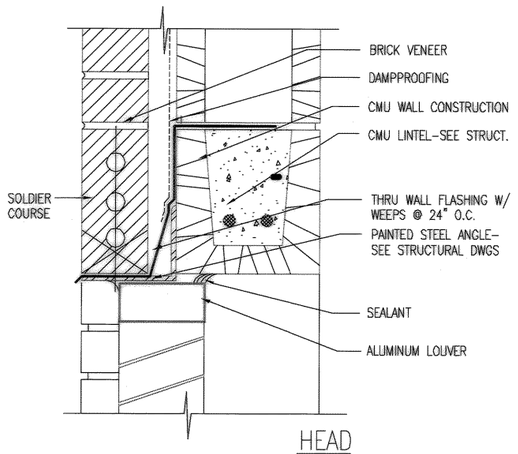

HEAD

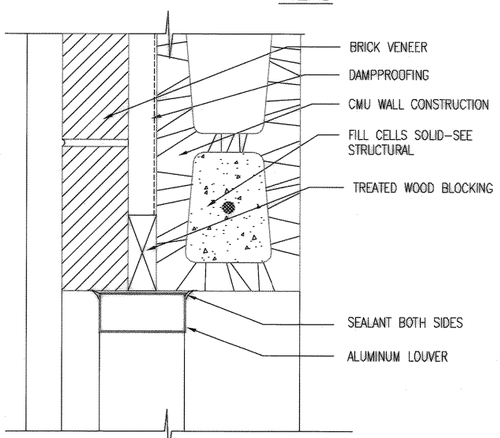

JAMB

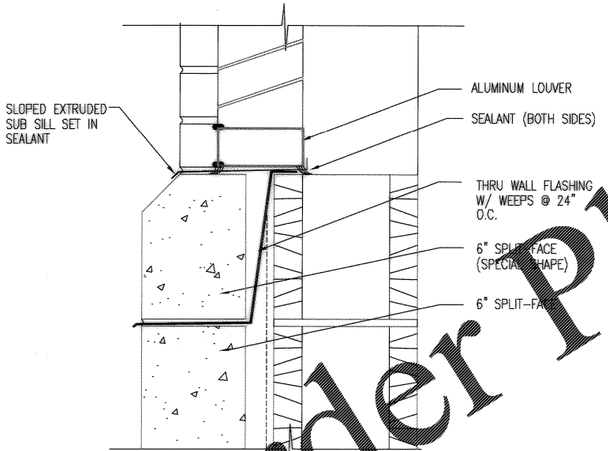

SILL

1 A–606 LOUVER DETAIL

SCALE: 3"= 1'–0"

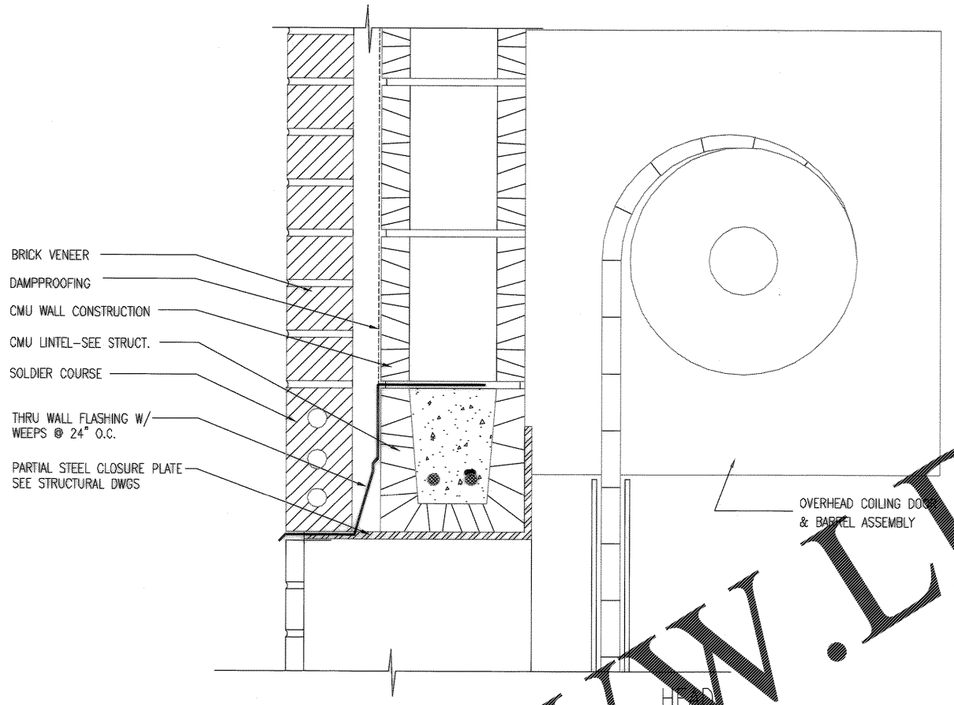

HEAD

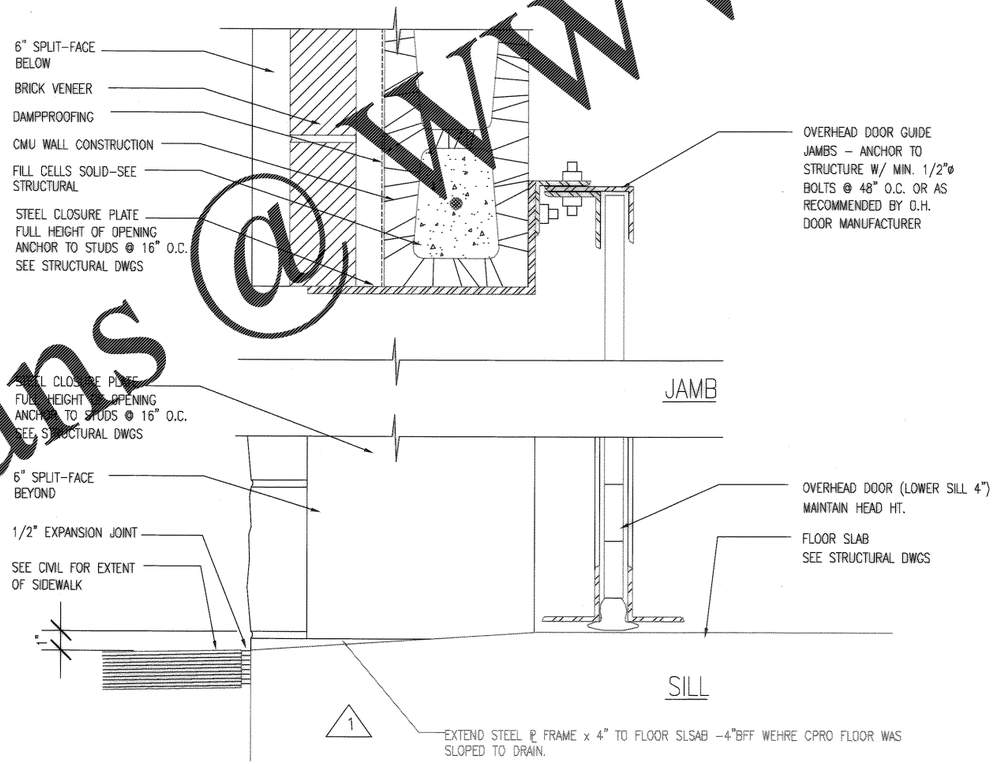

JAMB

SILL

1 EXTEND STEEL ℄ FRAME x 4" TO FLOOR SLSAB –4"BFF WEHRE CPRO FLOOR WAS SLOPED TO DRAIN.

2 A–606 OVERHEAD DOOR DETAIL

SCALE: 3"= 1'–0"

Order Plans @ WWW.LDILine.com

Glick/Boehm & Associates, Inc.
247 Meeting Street, Suite 100
Charleston, S.C. 29401 (803) 577–6377

DSN BOEHM DWN BOEHM CHK DJST CHT ENGR APPV

Rev.	Description	Prep By	Date	Approvd.
1	DRWG. CORRECTED TO AS–BUILT			

DRAWING REVISIONS

SUBMITTED BY (FIRM MEMBER–TITLE): MGE PRES. 8-22-98

TECHNICAL BRANCH

FPE

CHARLESTON AIR FORCE BASE CHARLESTON, SOUTH CAROLINA

DINING FACILITY

MISC. DETAILS

APPROVED [signature] PE DATE 8/11/98 EFD FOR COMMANDER, NAVFAC

Naval Facilities Engineering Command
Southern Division
Charleston, South Carolina

STATE OF SOUTH CAROLINA
GLICK/BOEHM & ASSOCIATES, INC.
CHARLESTON
NO. B–80006
REGISTERED ARCHITECT

RECORD DRAWING DATE 9/27/04
CODE I.D. NO. 80091
DRAWING SIZE: D
SPEC. NO. 05–98–0939
CONSTRN. CONTR. NO. N62467–98–C–0939
NAVFAC DRAWING NO. 5357917
SHEET 92 OF 194

A–606

468-103