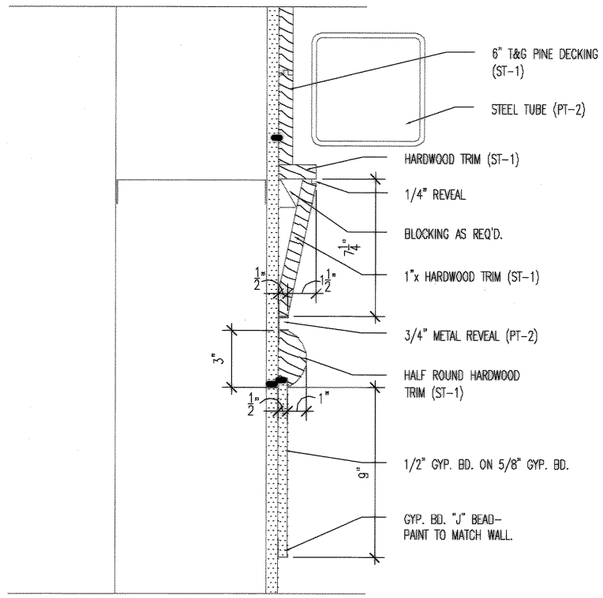

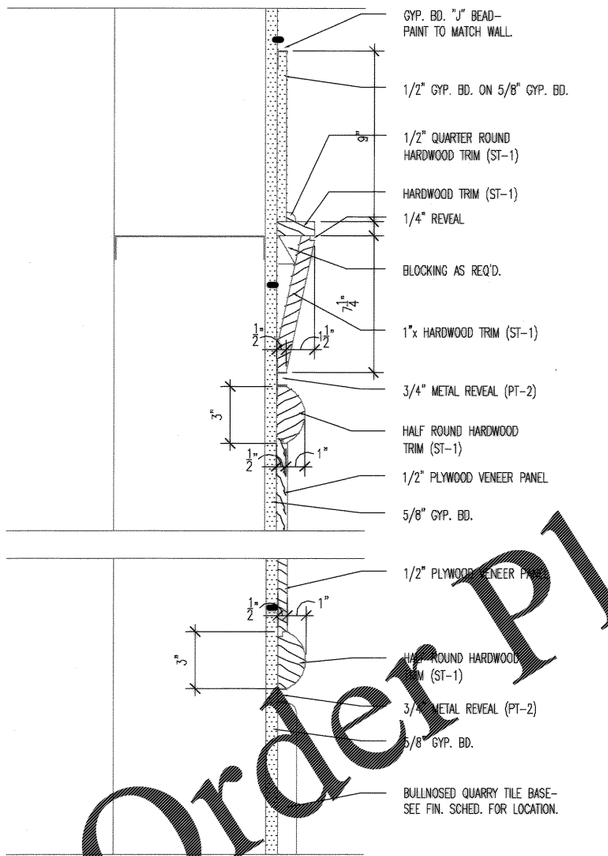

1 A-704 INTERIOR PILASTER DETAIL
SCALE: 3"= 1'-0"

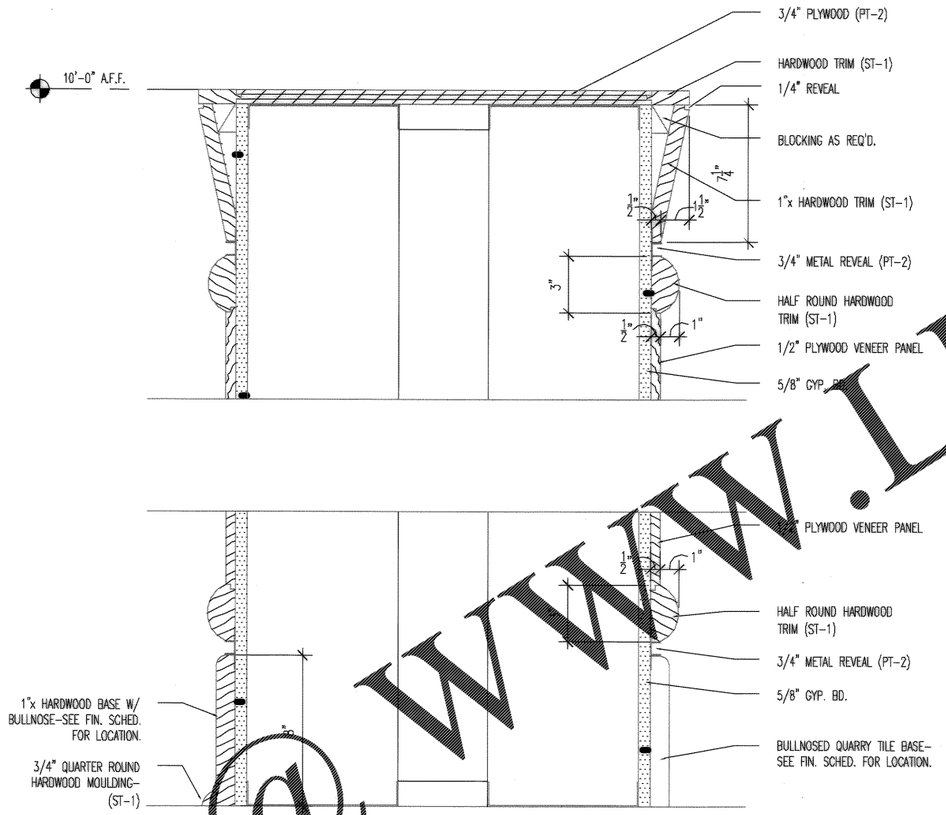

2 A-704 INTERIOR COLUMN DETAIL
SCALE: 3"= 1'-0"

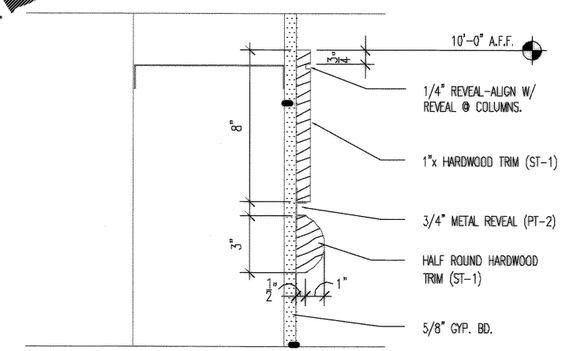

4 A-704 INTERIOR MOULDING DETAIL
SCALE: 3"= 1'-0"

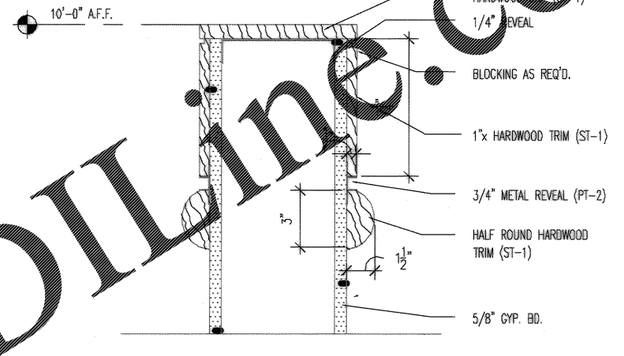

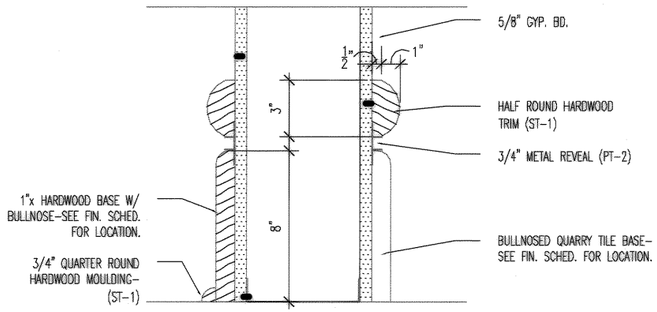

3 A-704 INTERIOR HALF WALL DETAIL
SCALE: 3"= 1'-0"

0 3" 6" 1'
SCALE: 3" = 1'-0"

Glick/Boehm & Associates, Inc.
247 Meeting Street, Suite 100
Charleston, S.C. 29401 (803) 577-6377

DSGN	CHK
BOEHM	BOEHM
DRN	CH ENGR
JCS	

SUBMITTED BY (FIRM MEMBER-TITLE): WGE PRES. 8-23-98
TECHNICAL BRANCH
PRE

DRAWING REVISIONS

Rev.	Description	Prep By	Date	Apprvd.
1	AS-BUILT DRWG. NO CORRECTIONS	[illegible]	[illegible]	[illegible]

CHARLESTON AIR FORCE BASE CHARLESTON, SOUTH CAROLINA

DINING FACILITY

INTERIOR DETAILS

APPROVED [illegible] PE DATE [illegible] EFD FOR COMMANDER, NAVFAC

Naval Facilities Engineering Command
Southern Division
Charleston, South Carolina

STATE OF SOUTH CAROLINA
GLICK/BOEHM & ASSOCIATES, INC.
CHARLESTON NO. 8-80006
REGISTERED ARCHITECT

RECORD DRAWING DATE 9/23/04
CODE I.D. NO. 80091
DRAWING SIZE: D
SPEC. NO. 06-98-0939
CONSTRN. CONTR. NO. N62467-98-C-0939
NAVFAC DRAWING NO. 5357922
SHEET 97 OF 194

A-704

Order Plans @ WWW.LDILine.com

468-98