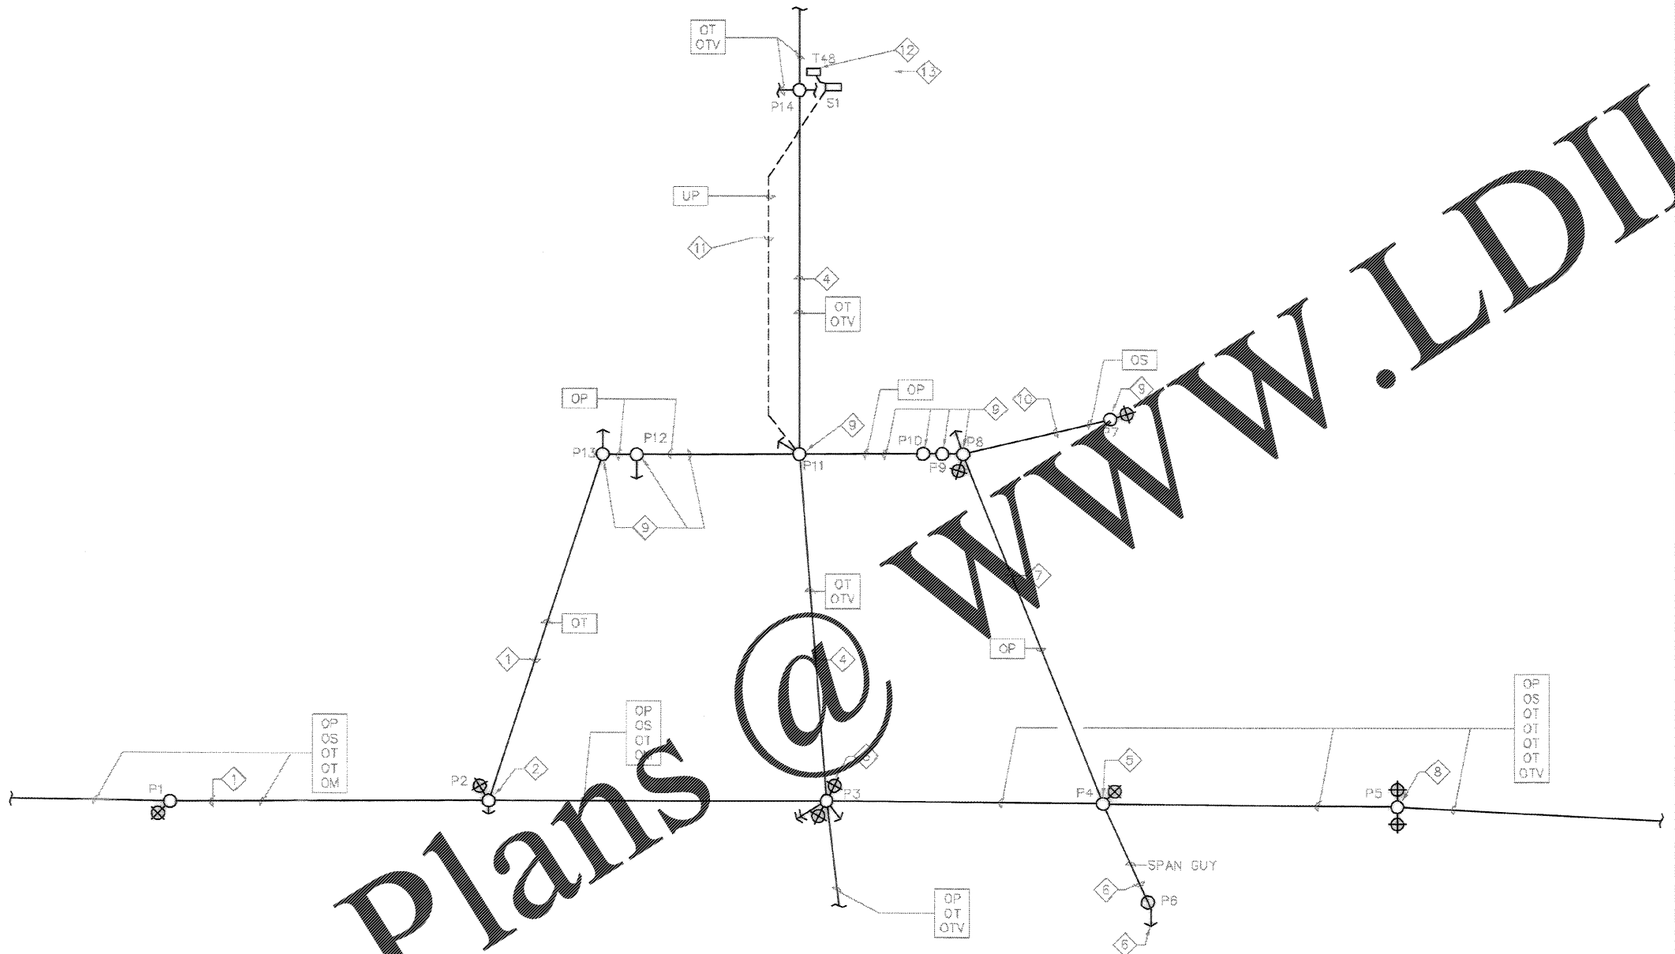

SITE DEMOLITION PLAN
SCALE: 1" = 40'

KEYED DEMOLITION NOTES (THIS SHEET ONLY)

1. ABANDONED OVERHEAD TELEPHONE CIRCUIT FROM P1 TO P2 AND FROM P2 TO P13 TO BE REMOVED BY GOVERNMENT PRIOR TO THE START OF CONSTRUCTION.
2. REMOVE FLOODLIGHT AND REMOVE DOWNGUY AND ANCHOR ON P2.
3. REMOVE FLOODLIGHT AND REMOVE 3 DOWNGUYS AND 3 ANCHORS ON P3. STREETLIGHT IS TO REMAIN.
4. OVERHEAD TELEPHONE AND OVERHEAD TELEVISION CIRCUITS FROM P4 TO P11 AND FROM P11 TO P14 TO BE REMOVED BY THE GOVERNMENT PRIOR TO THE START OF CONSTRUCTION.
5. REMOVE FLOODLIGHT ON P4. REMOVE POLE IN ITS ENTIRETY AFTER NEW POLE P4 IS IN PLACE.
6. REMOVE SPAN GUY FROM P4 TO P6. REMOVE CLASS 3, 30' STUB POLE P6. REMOVE DOWNGUY AND ANCHOR.
7. REMOVE OVERHEAD PRIMARY FROM P4 TO P8.
8. REMOVE FLOODLIGHT ON P5. STREETLIGHT IS TO REMAIN.
9. REMOVE POLES P7, P8, P9, P10, P11, P12 AND P13 IN THEIR ENTIRETY, INCLUDING DOWN GUYS AND ANCHORS. REMOVE OVERHEAD PRIMARY FROM P8 TO P9, FROM P9 TO P10, FROM P10 TO P11, FROM P11 TO P12 AND FROM P12 TO P13.
10. REMOVE OVERHEAD SECONDARY FROM P7 TO P8.
11. REMOVE UNDERGROUND PRIMARY CABLES FROM P11 TO SWITCH S1 AND FROM SWITCH S1 TO TRANSFORMER T48. CONCRETE ENCASED DUCT MAY BE ABANDONED IN PLACE.
12. REMOVE 500KVA PAD MOUNTED TRANSFORMER T48. TURN OVER TO GOVT. (ADDITIVE BID ITEM)
13. REMOVE BLDG. 467 IN ITS ENTIRETY. (ADDITIVE BID ITEM)

GENERAL NOTES

1. SCHEDULE ALL DEMOLITION TO OCCUR AFTER NEW CIRCUIT TO SWITCH S1 IS IN PLACE AND OPERATING.

SITE LEGEND

- EXISTING UNDERGROUND CIRCUIT/WIRES (SEE LETTER DESIGNATION FOR TYPES).
- EXISTING OVERHEAD CIRCUIT/WIRES (SEE LETTER DESIGNATION FOR TYPES).
- NEW UNDERGROUND DUCT AND CIRCUIT.
- OP OVERHEAD PRIMARY.
- OS OVERHEAD SECONDARY.
- OT OVERHEAD TELEPHONE.
- OTV OVERHEAD TELEVISION.
- UP UNDERGROUND PRIMARY
- OM OVERHEAD MESSENGER WIRE
- OG / OS / OT — INDICATES COMBINATION OF CIRCUITS/WIRES.
- EXISTING DOWN GUY.
- EXISTING POLE.
- NEW POLE.

EPIC ENGINEERING INC. No. C00259 — STATE OF NORTH CAROLINA — REGISTERED PROFESSIONAL ENGINEER

DRAWING REVISIONS

Rev.	Description	Prep By	Date	Approved
1	AS-BUILT DRWG. NO CORRECTIONS	[illegible]	9/27/09	

Glick/Boehm & Associates, Inc. — 247 Meeting Street, Charleston, S.C. 29401 — (803) 100-6377
DR. MASON ALLEN — DATE
SUP. CURTIS ALLEN
SUBMITTED BY (CPM MEMBER-TITLE)
TECHNICAL BRANCH
PPE

CHARLESTON AIR FORCE BASE — CHARLESTON, SOUTH CAROLINA

DINING FACILITY

ELECTRICAL SITE DEMOLITION PLAN

APPROVED — DATE 9/27/09 — CO Phone PE — CO FOR COMMANDER, NAVFAC

Naval Facilities Engineering Command — Southern Division — Charleston, South Carolina

RECORD DRAWING DATE 9/27/09
CODE I.D. NO. 80091
DRAWING SIZE D
SPEC. NO. 06-98-0938
CONSTRN. CONTR. NO. N62467-98-C-0938
NAVFAC DRAWING NO. 5357994
SHEET 165 OF 194

E-101

468-26

Order Plans @ WWW.LDILine.com