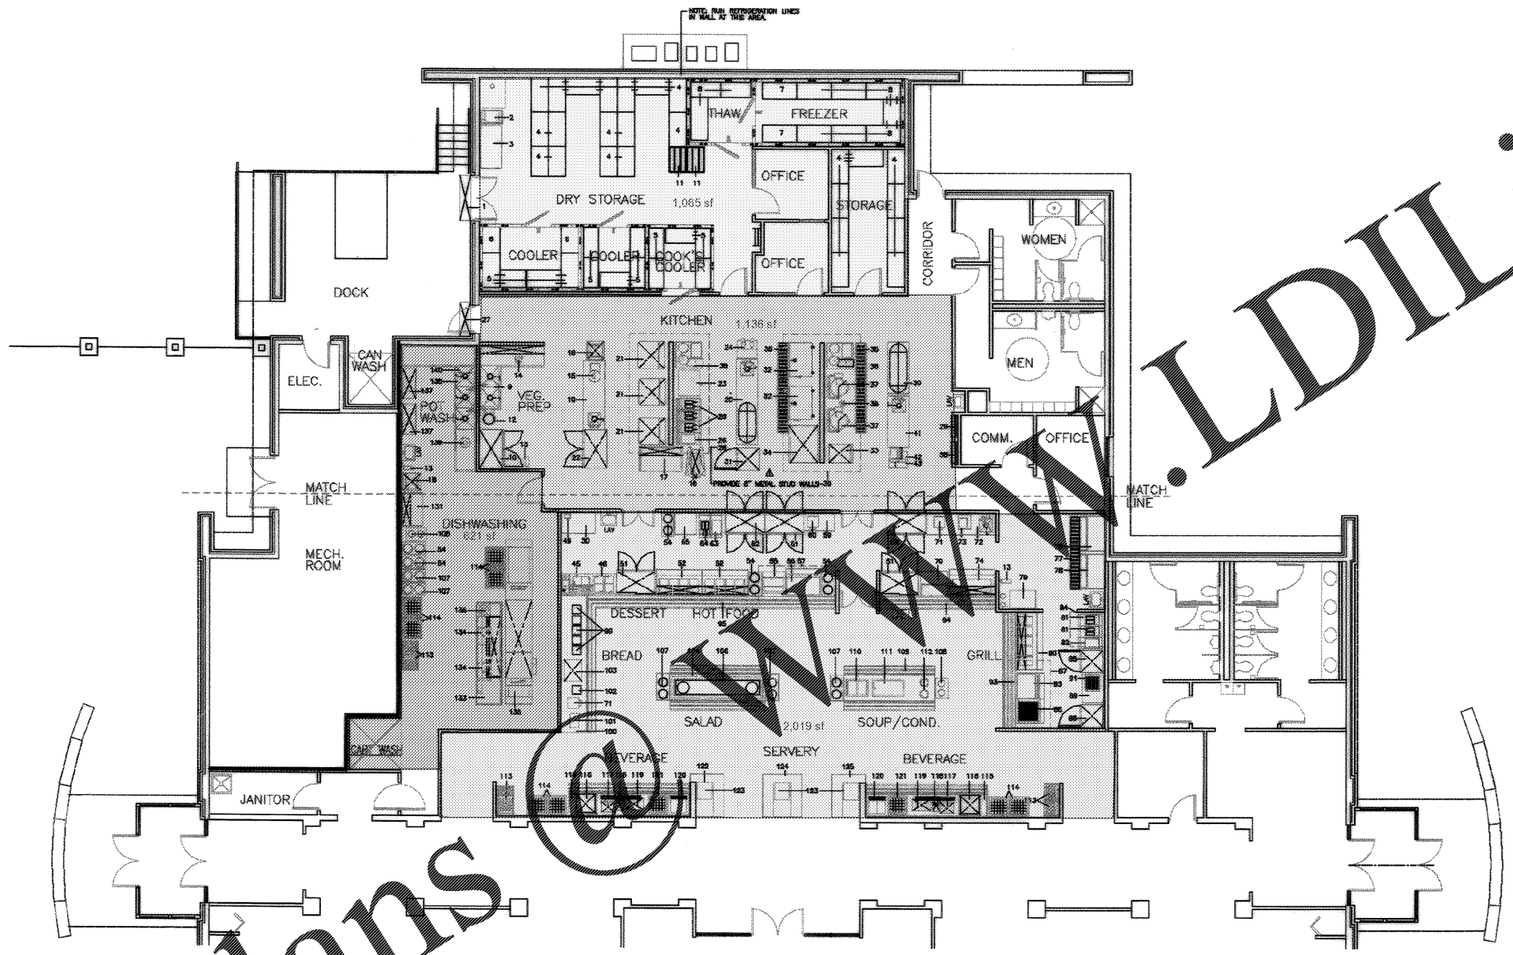

1 K101 KITCHEN AND SERVERY FLOOR PLAN

1/8"=1'-0"

Order Plans @ www.LDILine.com

Glick/Boehm & Associates, Inc.
247 Meeting Street
Charleston, S.C. 29401 (803) 577-6377

DRAWING REVISIONS

Rev.	Description	Prep By	Date	Approvd.
1	DWNG. CORRECTED TO AS-BUILT	HHH	8/16/99	

DESIGN
SURV
SUBMITTED BY (FIRM NUMBER-NAME)
OF ENGINEERS
TECHNICAL BRANCH
PPE

CHARLESTON AIR FORCE BASE CHARLESTON, SOUTH CAROLINA

DINING FACILITY
KITCHEN AND SERVERY FLOOR PLAN

APPROVED BY: DATE: 8/16/96 ESD FOR COMMANDER, NAVFAC

Naval Facilities Engineering Command
Southern Division
Charleston, South Carolina

RECORD DRAWING DATE 9/27/99
CODE I.D. NO. 80091
DRAWING SIZE: D
SPEC. NO.06-98-0939
CONSTRN. CONTR. NO. N62467-98-C-0939
NAVFAC DRAWING NO. 5357924
SHEET 99 OF 194
K-101

468-96