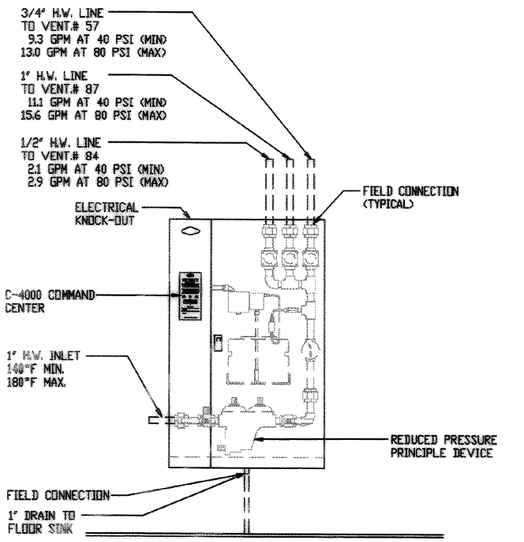

1 K102 K502 TYPICAL CONTROL CABINET ELEVATION

OVERALL SIZE: 30"x 48"x 7" D.

ITEM # 58

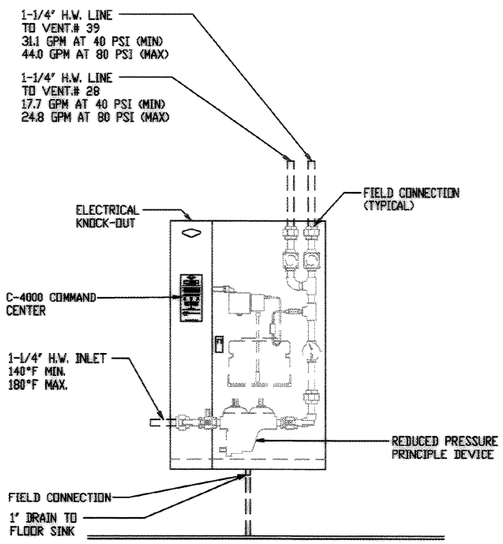

2 K102 K502 TYPICAL CONTROL CABINET ELEVATION

OVERALL SIZE: 30"x 48"x 7" D.

ITEM # 29

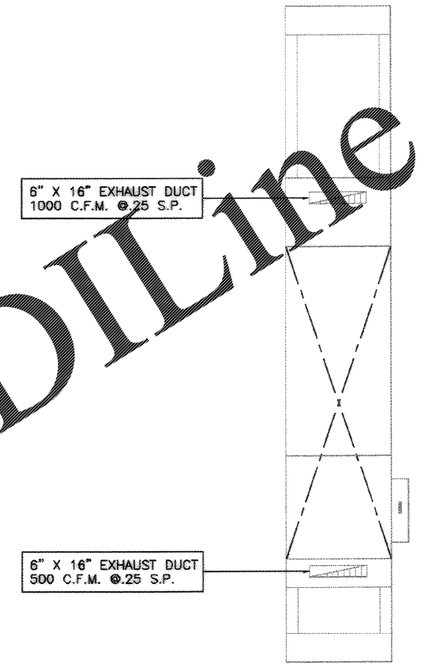

4 K103 K502 DISHWASHER VENTILATION DETAIL - ITEM # 136

NO SCALE

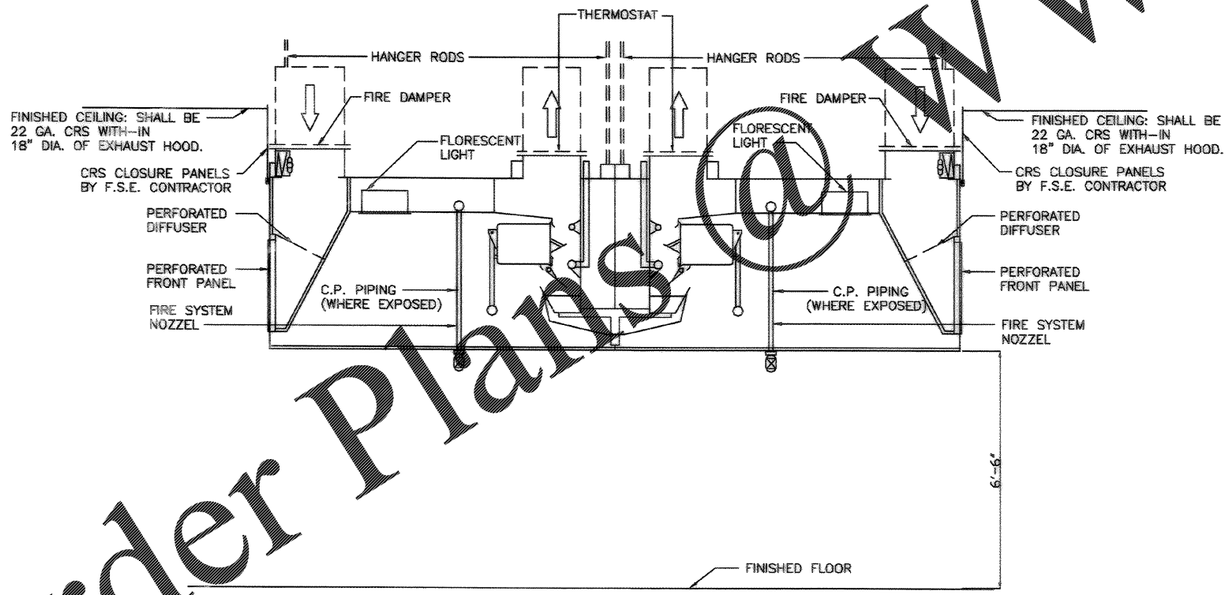

3 K102 K502 HOOD SECTION ITEM # 39

NO SCALE

Glick/Boehm & Associates, Inc.
247 Meeting Street, Suite 200
Charleston, S.C. 29401-4377
(803) 577-6377

DRAWING REVISIONS

Rev.	Description	Prep By	Date	Approvd.
1	07-0962 MISC. AS BUILTS/CHGS	MJH	9/14/07	

DESIGN: DSH
DRAWN: SLPY
CH'D: [illegible]
SUBMITTED BY (FIRM NAME): TECHFORCE BRANCH
DATE:
TITLE: PIPE

CHARLESTON AIR FORCE BASE CHARLESTON, SOUTH CAROLINA

DINING FACILITY
VENTILATION DETAILS

APPROVED [illegible] P.E. DATE: 6/15/08
EFD FOR COMMANDER, NAVFAC

Naval Facilities Engineering Command
Southern Division
Charleston, South Carolina

RECORD DRAWING DATE
7/27/24
CODE I.D. NO. 80091
DRAWING SIZE: D
SPEC. NO.06-98-0939
CONSTRN. CONTR. NO.
N62467-98-C-0939
NAVFAC DRAWING NO.
5357936
SHEET 111 OF 194

K502

Order Plans @ WWW.LDILine.com

468-84