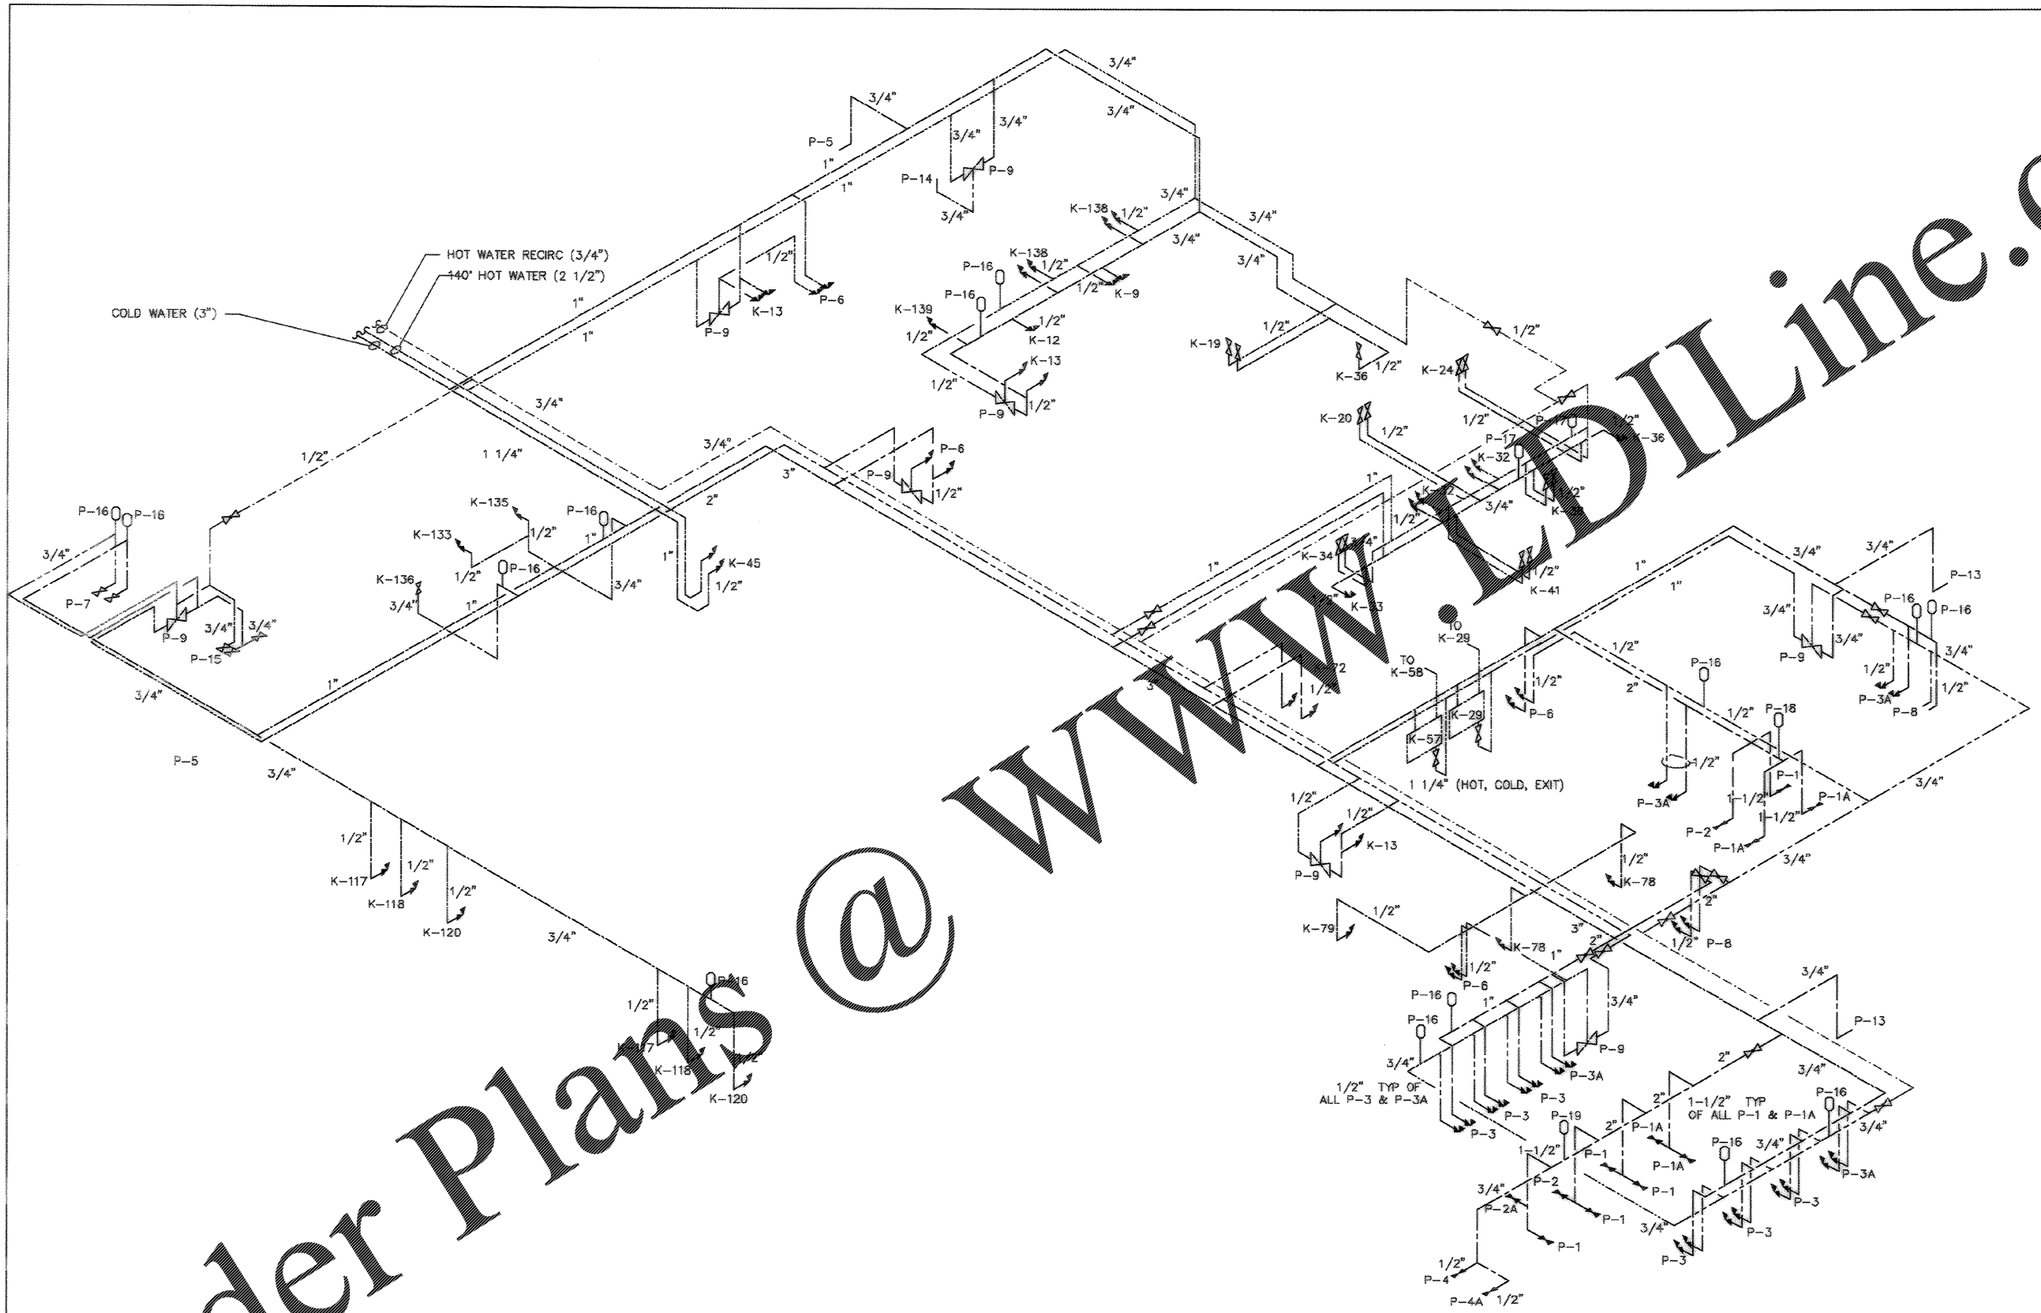

WATER RISER
SCALE: NONE

NOTES:
1. WATER HAMMER ARRESTORS SHALL BE INSTALLED IN CEILING AREAS.

EPIC ENGINEERING INC. No. C0C0258 CERTIFICATE OF AUTHORIZATION

SOUTH CAROLINA PROFESSIONAL ENGINEER No. 7182

Epic/Rhodes Associates, Inc.
247 Meeting Street, Suite 200
Charleston, S.C. 29401-2377 (803)

DSGN: DONALDSON DR: DONALDSON CH: EN
SUBMITTED BY (FIRM NUMBER): CHECK: DATE:
TECHNICAL BRANCH
PIPE

DRAWING REVISIONS

Rev.	Description	Prep By	Date	Approvd.
1	AS-BUILT DRWG. NO CORRECTIONS	MJH	9/27/04	RM Rhodes PE

CHARLESTON AIR FORCE BASE CHARLESTON, SOUTH CAROLINA

DINING FACILITY

WATER RISER

APPROVED RM Rhodes PE DATE 9/27/04 EFD FOR COMMANDER, NAVFAC

Naval Facilities Engineering Command
Southern Division
Charleston, South Carolina

RECORD DRAWING DATE 9/27/04
CODE I.D. NO. 80091
DRAWING SIZE D
SPEC. NO. DS-98-0939
CONSTRN. CONTR. NO. N62467-98-C-0939
NAVFAC DRAWING NO. 5357956
SHEET 131 OF 194
P-902

468-69

Order Plans @ WWW.IDLine.com