


1 / M108 MECHANICAL ATTIC PLAN – BUILDING 475
SCALE: NONE

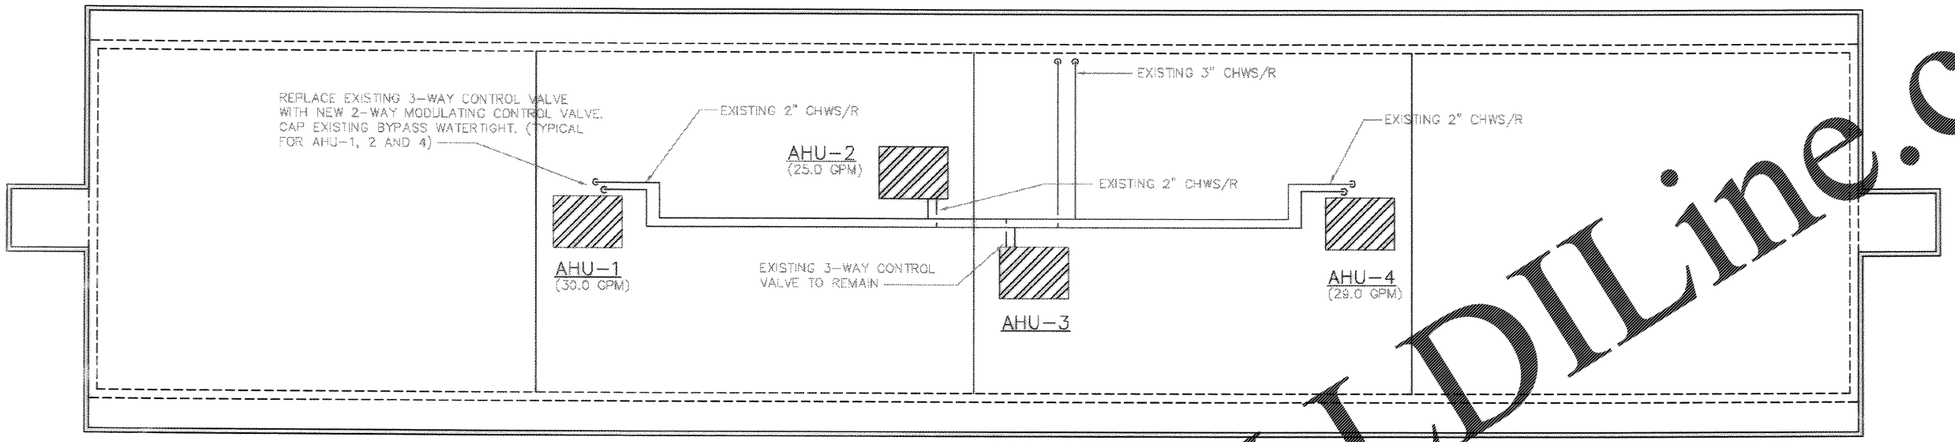


1 / M108 MECHANICAL FIRST FLOOR PLAN – BUILDING 475
SCALE: NONE

Blyth/Booth & Associates, P.A.
247 Meeting Street, Charleston, S.C. 29401 (803) 577-6377

DRAWING REVISIONS

| Rev. | Description | Prep. By | Date | Approvd. |
|---|---|---|---|---|
| 1 | AS-BUILT DWNG. NO CORRECTIONS | MJP | 9/9/04 | 9/9/04 |

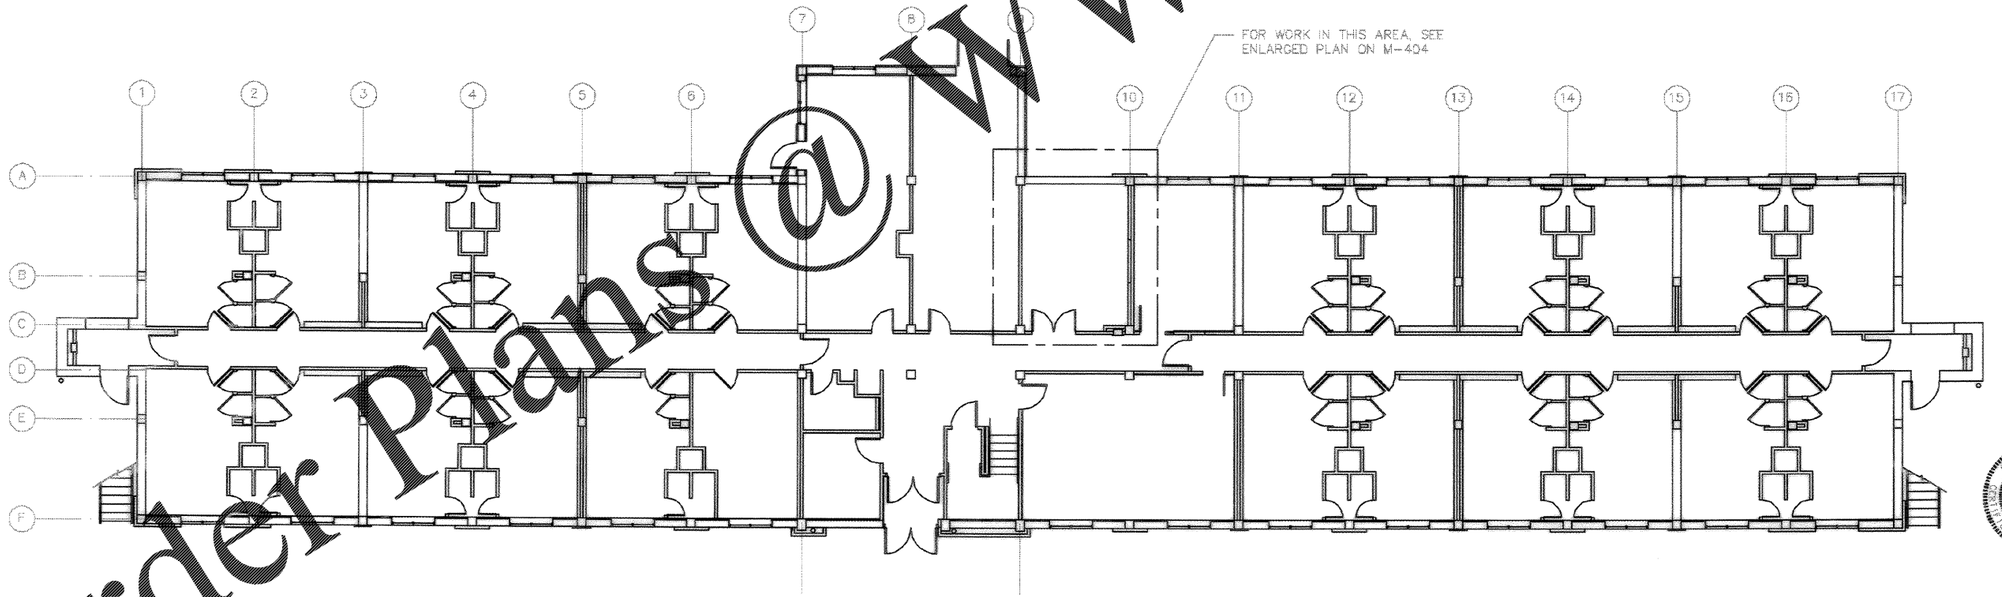DSGN: DJ/MJT DR: MJT CH: DJ SUPV: DJ/MJT QUAL: SUBMITTED BY (FIRM NAME): TECHNICAL BRANCH PM: PE: DATE

CHARLESTON, SOUTH CAROLINA
CHARLESTON AIR FORCE BASE
DINING FACILITY
DORM 475 MECHANICAL PLANS - CPRO
APPROVED DATE 5/6/04
EFD, ESR COMMANDER, NAVFAC

Naval Facilities Engineering Command
Southern Division
Charleston, South Carolina

EPIC ENGINEERING INC. No. C00259 STATE OF AUTHORIZATION
SOUTH CAROLINA PROFESSIONAL ENGINEER No. 7188 REGISTERED ROGGERS

RECORD DRAWING DATE 9/27/04
CODE I.D. NO. 80091
DRAWING SIZE: D
SPEC. NO. 04-88-0938
CONSTRN. CONTR. NO. N62467-98-C-0939
NAVFAC DRAWING NO. 5357966
SHEET 141 OF 194
M-108

Order Plans @ WWW.LDILine.com

468-54