AS-BUILT SURVEY

NOT INTENDED TO REPRESENT A BOUNDARY SURVEY

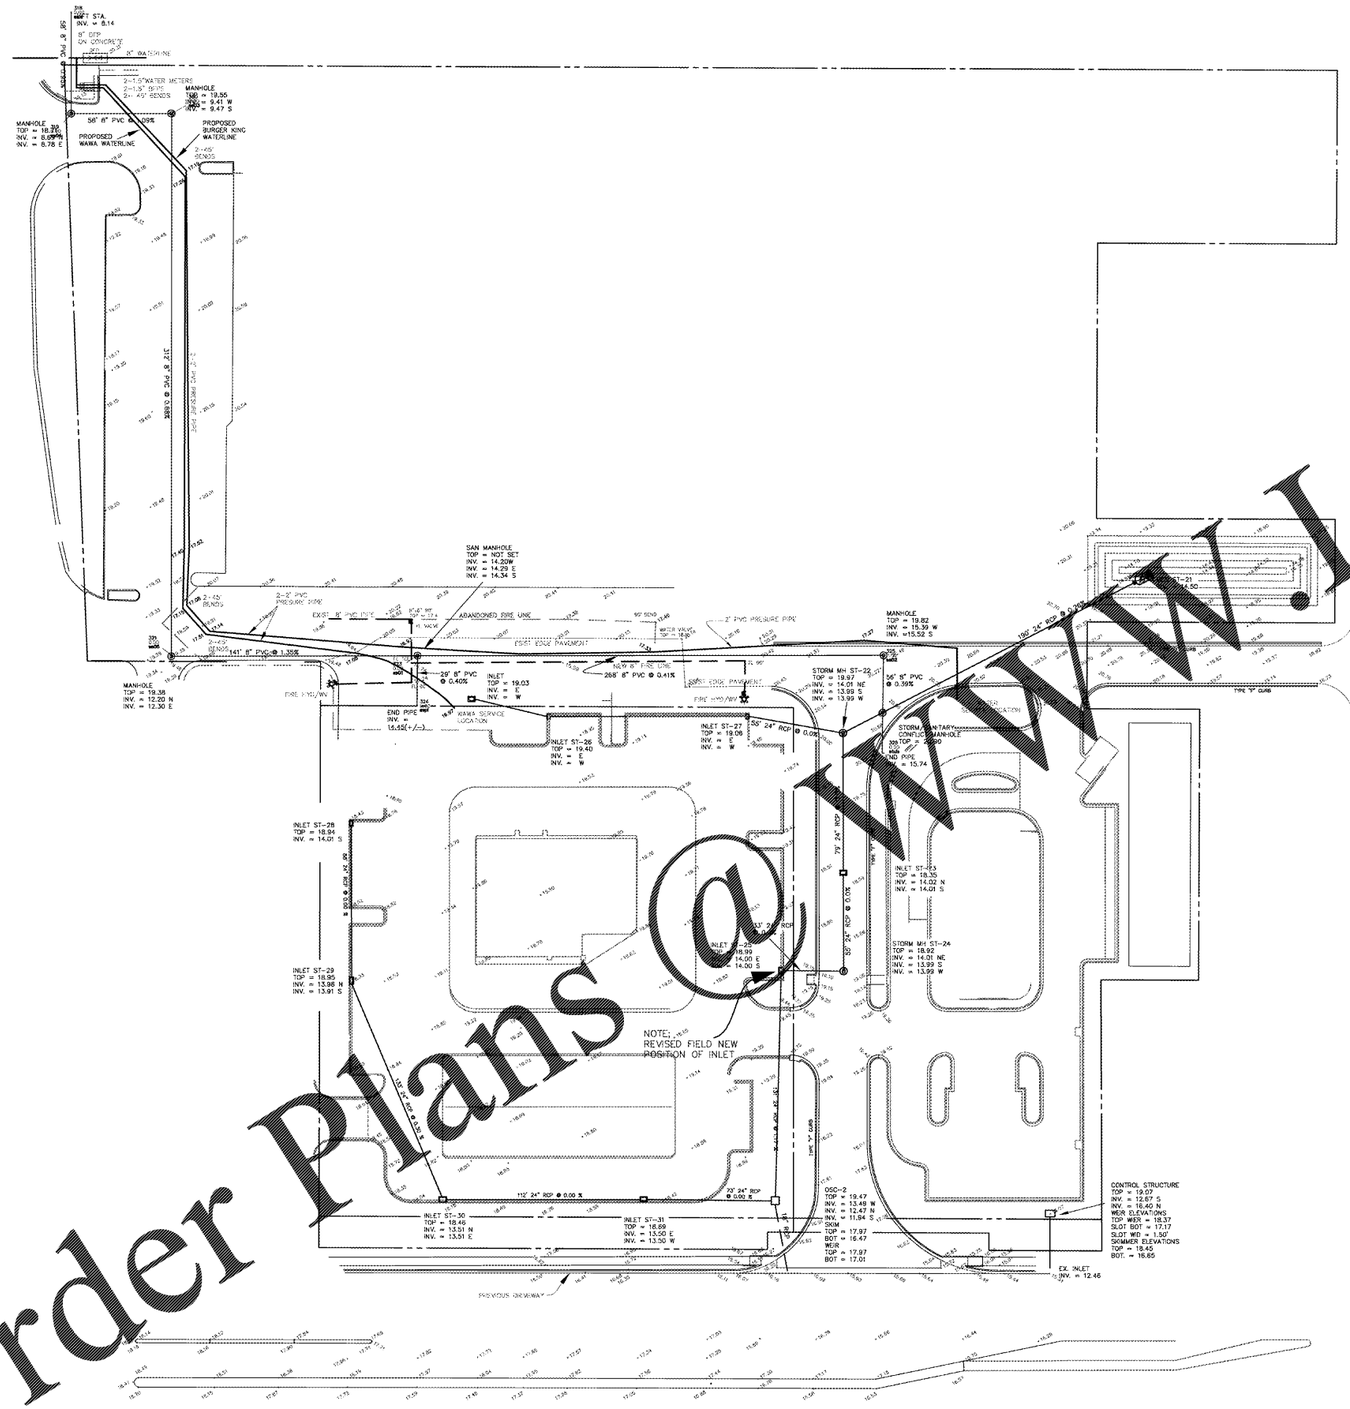

LEGEND

(C)= Calculated Data
(R)= Radial Line
(D)= Data per Description
(M)= Measured Data
(P)= Data per Plat
+/- = Plus or Minus
A/C= Air Conditioner
BW/BF= Barbwire Fence
BFE= Base Flood Elevation
BFP= Backflow Preventer
CB = Chord Bearing
CH = Chord
CP.S.= Concrete Pad
C/CA= Covered Carport
C/SP= Concrete Slab
C/S/W= Concrete Sidewalk
CL = Centerline
CLF = Chain Link Fence
CLEAN = Cleanout
CONC = Concrete
CMP = Corrugated Metal Pipe
CONC = Concrete
CO = Sanitary Cleanout
EOA = Edge
EOB = Edge Book
DW = Driveway
DMH = Drainage Manhole
E/P= Edge of Pavement
EL= Elevation
EOW = Edge of Water
FIR/CAP= Found Iron Rod & Cap
FCM= Found Concrete Monument
FIR= Found Iron Rod No Cap
FND N/D= Found Nail & Disc
FOP= Found Open Pipe
FPP= Found Pinched Pipe
GI = Grate Inlet
GV= Gate Valve
HYD= Fire Hydrant
IE = Invert Elevation
LB= Corporate Certificate Number
LP= Light Pole
LFE= Lowest Floor Elevation
M.L. = More or Less
MES= Mitered End Section
MLP= Metal Light Pole
N/ID= No Identification
NFND= Not Found and Not Set
(NR)= Not Radial
OR = Official Records Book
OHW = Overhead Wires
P.B.= Plat Book
PCP= Permanent Control Point
PG(S)= Page(s)
PLS= Professional Land Surveyor
POB= Point of Beginning
POC= Point of Commencement
PRM= Permanent Reference Monument
PVC/P= Plastic Fence
R= Radius
R/W= Right-of-way
RCP= Reinforced Concrete Pipe
SCM= Set Concrete Monument PLS 4821
SCO= Sanitary Cleanout
SIR= Set Iron Rod & Cap PLS 4821
SN/D= Set Nail & Disc PLS 4821
SMH= Sanitary Manhole
TBM= Temporary Benchmark
TOB= Top Of Bank
TOS= Toe of Slope
UP= Utility Pole
W/F= Wood Fence
WM= Water Meter
WV= Water Valve

SYMBOL LEGEND

= Backflow Preventor
= Cable Box
= Centerline
= Cleanout
= Decorative Light
= Drainage Manhole
= Fire Hydrant
= Grease Trap
= Guy Anchor
= Handicap
= Lightpole
= Mailbox
= Power Box
= Sanitary Manhole
= Sign
= Spot Elevation
= Telephone Box
= Utility Pole
= Water Meter
= Water Valve
= Well

Order Plans @ WWW.LDILine.com

DRAWN BY: ETC	
SCALE: 1" = 40'	
CHECKED BY:	
SHEET 1 of 1	
JOB NO.: 18001	FIELD DATE: 1/12/2018 AS-BUILT DATA

EUGENE T. CAUDELL, PLS
2321 PINE OAK LANE EAST
CLEARWATER, FL 33759
PHONE: (727) 459-9186
PLS 4821