Order Plans @ WWW.LDILine.com

KEYNOTES	
15.405	PROPERLY CAP, PLUG AND CONCEAL ANY PIPING LEFT IN PLACE. CAP ABANDONED SEWER PIPING A MINIMUM OF 8" BELOW FINISHED FLOOR. MATCH EXISTING FLOOR CONSTRUCTION AND FINISHES. RE: ARCHITECTURAL PLANS. REMOVE UNUSED WATER AND VENT PIPING ABOVE CEILING AND CAP REMAINING PIPE.
15.406	PLUMBING CONTRACTOR TO MAKE ALL NECESSARY DISCONNECTS AND RECONNECTS OF PLUMBING FIXTURES BEING RELOCATED OR NEW.
15.436	REPLACE SINK AND ASSOCIATED TRIM. INCLUDING THE FAUCET, TAILPIECE, P-TRAP, SUPPLY LINES, AND SHUT-OFF VALVES.
15.445	REPLACE DAMAGED CLEANOUT/FLOOR DRAIN COVER WITH NEW COVER OF LIKE DUTY AND MATERIAL. CONTRACTOR SHALL FURNISH AND INSTALL REPLACEMENT COVERS.

GENERAL NOTES
REFER TO MP1 FOR GENERAL NOTES PERTAINING TO THIS SHEET.

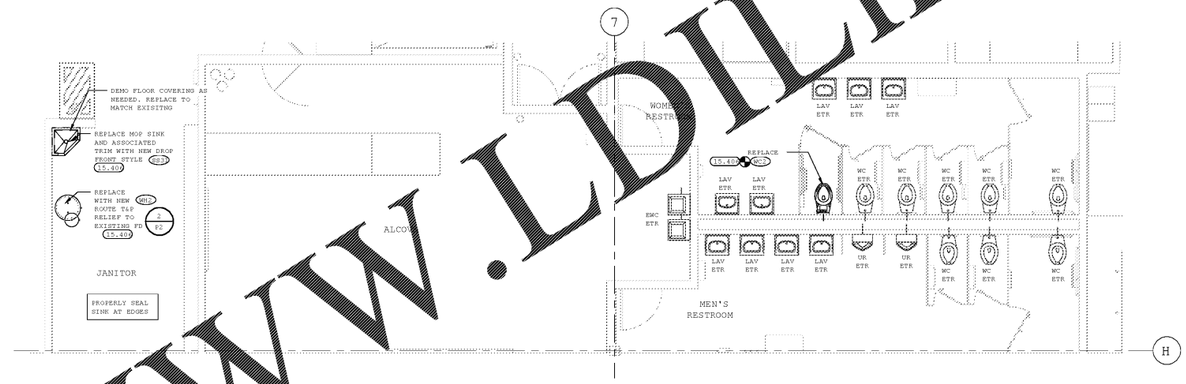

4 REAR RESTROOM PLUMBING PLAN
1/4" = 1'-0"

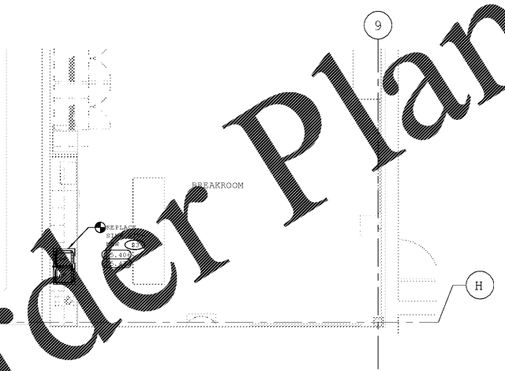

3 BREAKROOM PLUMBING PLAN
1/4" = 1'-0"

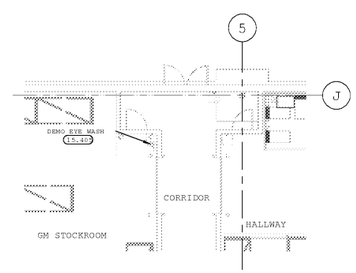

2 GR RECIEVING PLUMBING PLAN
1/8" = 1'-0"

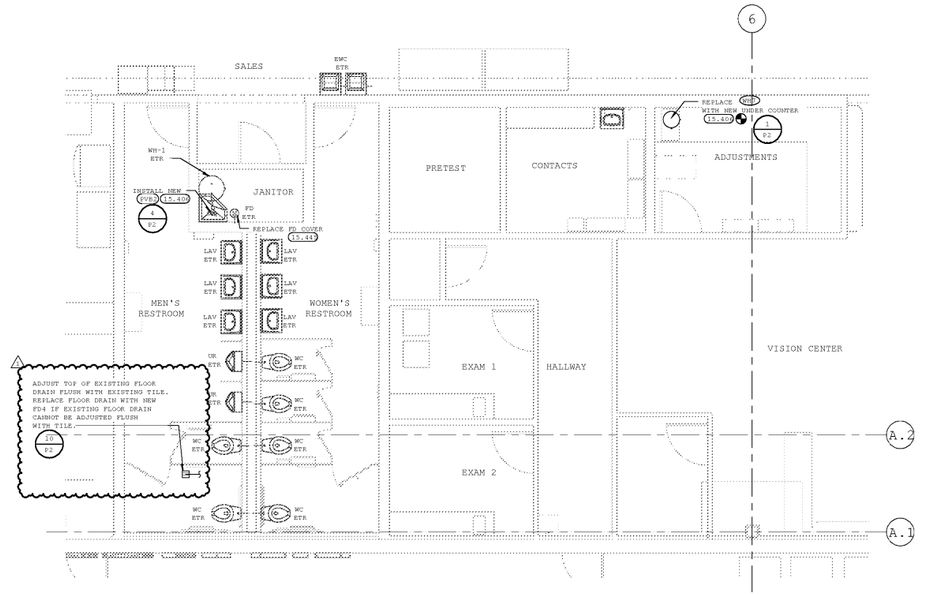

1 FRONT RESTROOM PLUMBING PLAN
1/4" = 1'-0"

EXISTING CONDITIONS WERE TAKEN FROM ORIGINAL DRAWINGS AND MAY NOT REFLECT EXACT "AS-BUILT" CONDITIONS. CONTRACTOR SHALL FIELD VERIFY ALL EXISTING CONDITIONS PRIOR TO SUBMITTING FINAL BIDS. CONTRACTOR SHALL CAREFULLY COORDINATE NEW WORK AND DEMOLITION WITH ALL OTHER DISCIPLINES AND EXISTING CONDITIONS.

EACH SUBCONTRACTOR IS RESPONSIBLE FOR HAVING A THOROUGH KNOWLEDGE OF ALL DRAWINGS AND SPECIFICATIONS IN THEIR RELATED FIELD. THE FAILURE TO ACQUAINT THEMSELF WITH THIS KNOWLEDGE DOES NOT RELIEVE THE RESPONSIBILITY OF PERFORMING THE WORK PROPERLY. NO ADDITIONAL COMPENSATION SHALL BE ALLOWED BECAUSE OF CONDITIONS THAT OCCUR DUE TO FAILURE TO FAMILIARIZE WORKERS WITH THIS KNOWLEDGE.

1921 Prospect Ave
Orlando, FL 32814
p (407) 894-2000
f (407) 894-3010
www.fpcdesign.com
FPC DESIGN
Engineering Consultants

STIPULATION FOR USE OF DRAWINGS
THESE DRAWINGS ARE PREPARED FOR USE ON THIS PROJECT ONLY AND ARE NOT TO BE USED IN WHOLE OR IN PART FOR ANY OTHER CONSTRUCTION WITHOUT THE WRITTEN PERMISSION OF FPC DESIGN. ALL RIGHTS RESERVED. COPYRIGHT © 2018 FPC DESIGN. ALL RIGHTS RESERVED. THE SUBMITTAL OF THESE PLANS TO ANY AUTHORITY FOR REVIEW DOES NOT PUBLISH THESE DRAWINGS IN DEROGATION OF THE COPYRIGHT OF FPC DESIGN. ANY REUSE OF THESE DRAWINGS, WITHOUT THE WRITTEN PERMISSION OF FPC DESIGN FOR SPECIFIC APPLICATION, IS PROHIBITED AND WILL BE UNLAWFUL. ANY REUSE SHALL BE AT THE USER'S SOLE RISK AND WITHOUT LIABILITY TO FPC DESIGN. ANY REUSE SHALL BE CONTRARY TO THE LAW.

CONSULTANTS

Walmart
JESUP, GA
STORE NO: 2630
3180278 | FPC#154
139
JOB NUMBERS:

ISSUE BLOCK		
1	PP#1	10/26/18

CHECKED BY:	JJD
DRAWN BY:	JM
PHOTO CYCLE:	07/27/18
DOCUMENT DATE:	10/26/18

NOT FOR CONSTRUCTION

ENLARGED PLUMBING PLANS

SHEET:
P1

10/26/2018 11:51:16 AM
C:\Users\jmiller\Documents\3180278_FPC_154_R_MEP_P1C_jmiller.rvt