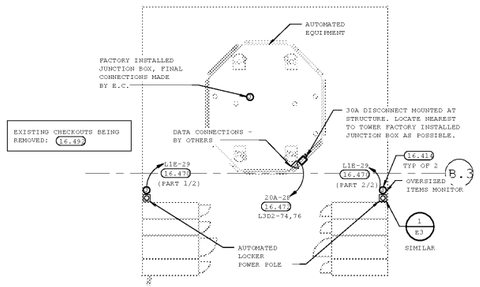

5 IN-LANE TOWER POWER PLAN
1/4" = 1'-0"

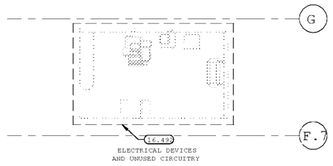

4 PHOTOLAB POWER DEMO PLAN
1/8" = 1'-0"

▼F VOICE/DATA BOX PRE-INSTALLED BY CABINET MANUFACTURER.

ΦF OUTLET BOX PRE-INSTALLED BY CABINET MANUFACTURER. FURNISH AND INSTALL RECEPTACLE, COVERPLATE, AND CIRCUITRY.

ALL EQUIPMENT IS SINGLE PHASE.

ROUTE ALL CIRCUITRY THROUGH COUNTERS AND WALLS UNLESS OTHERWISE NOTED.

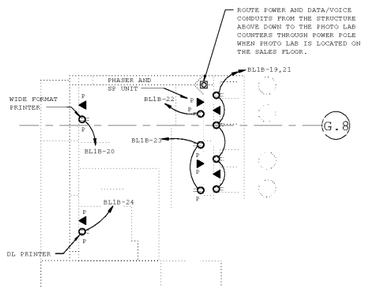

3 PHOTOLAB POWER PLAN
1/4" = 1'-0"

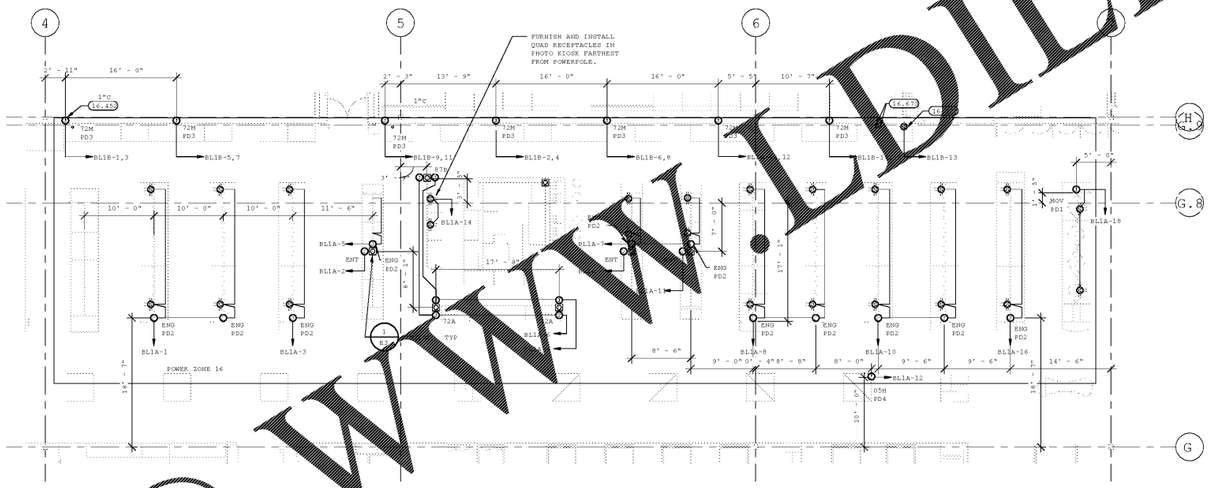

2 ELECTRONICS POWER PLAN
1/8" = 1'-0"

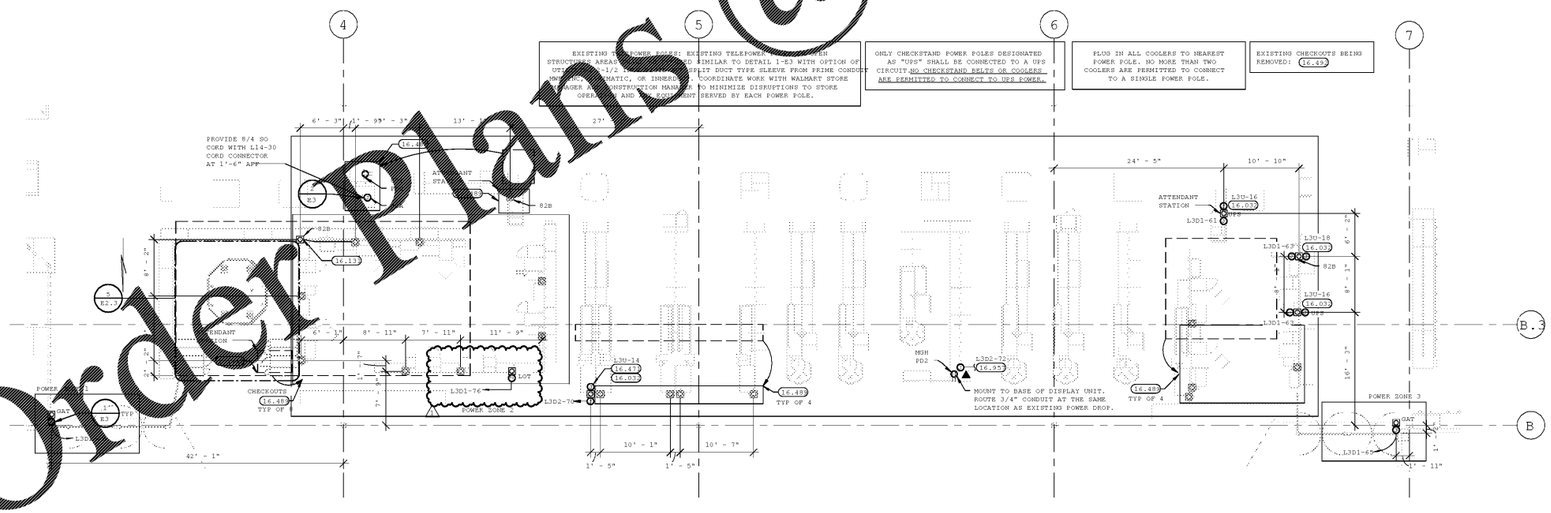

1 FRONT CHECKOUT POWER PLAN
1/8" = 1'-0"

REFER TO SHEET E2.1 FOR POWER DROP SCHEDULE AND NOTES.

EXISTING CONDITIONS WERE TAKEN FROM ORIGINAL DRAWINGS AND MAY NOT REFLECT EXACT "AS-BUILT" CONDITIONS. CONTRACTOR SHALL FIELD VERIFY ALL EXISTING CONDITIONS PRIOR TO SUBMITTING FINAL BIDS. CONTRACTOR SHALL CAREFULLY COORDINATE NEW WORK AND DEMOLITION WITH ALL OTHER DISCIPLINES AND EXISTING CONDITIONS.

EACH SUBCONTRACTOR IS RESPONSIBLE FOR HAVING A THOROUGH KNOWLEDGE OF ALL DRAWINGS AND SPECIFICATIONS IN THEIR RELATED FIELD. THE FAILURE TO ACQUAINT THEMSELF WITH THIS KNOWLEDGE DOES NOT RELIEVE THE RESPONSIBILITY OF PERFORMING THE WORK PROPERLY. NO ADDITIONAL COMPENSATION SHALL BE ALLOWED BECAUSE OF CONDITIONS THAT OCCUR DUE TO FAILURE TO FAMILIARISE WORKERS WITH THIS KNOWLEDGE.

KEYNOTES

16.032 CONNECT TO POWER POLE ORANGE TWIST-LOCK.

16.131 CONNECT TO EXISTING CIRCUIT. E.C. SHALL VERIFY PRIOR TO ROUGH-IN THAT EXISTING CIRCUIT HAS SPARE CAPACITY TO ACCOMMODATE ADDITIONAL LOAD.

16.228 INSTALL RECEPTACLE IN PROVIDED DATA ENCLOSURE. COORDINATE LOCATION OF RECEPTACLE WITH ISD CABLE VENDOR.

16.414 MOUNT JUNCTION BOX AT STRUCTURE. AFTER INSTALLATION OF DROP POLE AND TV COMPONENT TRAY, EXTEND CONDUCTORS IN 1/2" FLEXIBLE METAL CONDUIT ROOTED TO DROP POLE TO TV COMPARTMENT TRAY TO MAINTAIN NEC REQUIRED SEPARATION OF POWER AND DATA. PROVIDE DUPLEX RECEPTACLE AND FINAL TERMINATION IN TV COMPONENT TRAY.

16.452 SOUND SYSTEM CONDUIT: PROVIDE CONDUIT WITH PULL WIRE. FROM BELOW DELIVERING UNIT TO BAR JOIST. PROVIDE ONE BOX AT EACH END.

16.470 FURNISH AND INSTALL NEW 20 AMP, 125 VOLT CIRCUIT(S). FEED FROM PANEL AS INDICATED. PROVIDE 20A-1P CIRCUIT BREAKER IF NEEDED. E.C. SHALL MATCH MANUFACTURER, TYPE AND AIC RATINGS OF EXISTING CIRCUIT BREAKERS. E.C. SHALL VERIFY PRIOR TO ROUGH-IN THAT EXISTING PANELBOARD HAS SPARE CAPACITY TO ACCOMMODATE ADDITIONAL LOAD.

16.471 FURNISH AND INSTALL NEW 20 AMP, 120 VOLT ISOLATED GROUND CIRCUIT(S). FEED FROM PANELBOARD AS INDICATED. PROVIDE 20A-1P CIRCUIT BREAKER IF NEEDED. E.C. SHALL MATCH MANUFACTURER, TYPE AND AIC RATINGS OF EXISTING CIRCUIT BREAKERS. PROVIDE ORANGE COVER PLATES ON ALL ISOLATED GROUND DEVICES WITH CIRCUIT NUMBER ENGRAVED UNLESS NOTED OTHERWISE. E.C. SHALL VERIFY PRIOR TO ROUGH-IN THAT EXISTING PANELBOARD HAS SPARE CAPACITY TO ACCOMMODATE ADDITIONAL LOAD.

16.472 FURNISH AND INSTALL NEW CIRCUIT BREAKER (##A-#P) IN EXISTING PANELBOARD INDICATED. E.C. SHALL MATCH MANUFACTURER, TYPE AND AIC RATINGS OF EXISTING CIRCUIT BREAKERS. E.C. SHALL VERIFY PRIOR TO ROUGH-IN THAT EXISTING PANELBOARD HAS SPARE CAPACITY TO ACCOMMODATE ADDITIONAL LOAD.

16.489 RELOCATE, EXTEND, AND RECONNECT CIRCUITRY AND ELECTRICAL DEVICES FOR RELOCATED AND/OR NEW EQUIPMENT. VERIFY CONDITION OF BRANCH CIRCUITRY, CONDUIT AND WIRE TO ENSURE THEY MEET ALL U.L. RATINGS AND REPLACE AS REQUIRED. VERIFY FINAL LOCATION OF RELOCATED/NEW EQUIPMENT WITH WALMART CONSTRUCTION MANAGER PRIOR TO ROUGH-IN.

16.492 E.C. SHALL COORDINATE WITH GENERAL CONTRACTOR AND ARCHITECTURAL DEMOLITION PLANS THE EXTENT OF ELECTRICAL DEMOLITION. REMOVE CONDUITS AND WIRES ALL THE WAY BACK TO ORIGINATING JUNCTION BOXES OR PANELBOARDS. DEMOLITION SHALL NOT AFFECT ACTIVE CIRCUITS. LABEL DEMOLISHED CIRCUIT(S) IN PANELBOARDS AS "SPARE". COORDINATE EXACT REQUIREMENTS WITH EXISTING CONDITIONS PRIOR TO BID.

16.673 CONDUIT SLEEVE: PROVIDE (2) 2" CONDUITS (WITH PULL WIRE) FROM BAR JOIST TO PROVIDED DATA ENCLOSURE AND TERMINATE WITH BUSHINGS.

16.957 CONNECT CIRCUIT(S) TO EXISTING BRANCH CIRCUITRY. MINIMUM WIRE SIZE AND PANELBOARD CIRCUIT ARE NOTED. VERIFY SIZE, RATING AND CONDITION OF EXISTING BRANCH CIRCUIT CONDUIT AND WIRE PRIOR TO USE TO ENSURE THAT THEY MEET REQUIRED SIZE, AND ALL U.L. RATINGS AND REPLACE AS REQUIRED.

3952 Prospect Ave
Orlando, FL 32814
p (407) 894-2030
f (407) 894-3010
www.jfr.com
JFR DESIGN
Architecture Engineering

CERTIFICATION FOR PERMIT: I HEREBY CERTIFY THAT THESE DOCUMENTS WERE PREPARED OR APPROVED BY ME, AND THAT I AM A DULY LICENSED PROFESSIONAL ENGINEER UNDER THE LAWS OF THE STATE OF FLORIDA, LICENSE NUMBER 68000. THIS PROJECT REQUIRES THE SERVICES OF A LICENSED PROFESSIONAL ENGINEER. REPRODUCTION OF THESE DOCUMENTS IS PROHIBITED WITHOUT THE WRITTEN CONSENT OF JFR DESIGN. ANY REVISIONS MADE TO THESE DOCUMENTS BY OTHERS WITHOUT THE WRITTEN AUTHORIZATION OF JFR DESIGN SHALL RELIEVE JFR DESIGN OF ALL RESPONSIBILITY FOR THE DOCUMENTS AND ANY RESULTING CLAIMS, DAMAGES, OR EXPENSES ATTRIBUTABLE TO SUCH REVISIONS. ANY REUSE OF THESE DRAWINGS AND SPECIFICATIONS ON OTHER PROJECTS OR EXTENSIONS OF THIS PROJECT ARE PROHIBITED EXCEPT BY AGREEMENT IN WRITING AND APPROPRIATE COMPENSATION TO JFR DESIGN. ANY REUSE WITHOUT SUCH AGREEMENT SHALL BE AT THE USER'S SOLE RISK AND WITHOUT LIABILITY OR LEGAL EXPOSURE TO JFR DESIGN. ALL TITLES, CLAIMS, AND RIGHTS TO COPYRIGHT SHALL BE RETAINED BY JFR DESIGN. ANY REUSE OF THESE DOCUMENTS BY OWNER OR ANY OTHER PARTY WHICH IS NOT EXPRESSLY AUTHORIZED BY JFR DESIGN IN WRITING SHALL BE AT THE USER'S SOLE RISK AND WITHOUT LIABILITY OR LEGAL EXPOSURE TO JFR DESIGN. 

CONSULTANTS

Walmart
JESUP, GA
STORE NO: 2630
2182278 | 2907D1 139
JOB NUMBERS

ISSUE BLOCK

1	PP#1	10/26/18

CHECKED BY:	JPM
DRAWN BY:	MD
PHOTO CYCLE:	07/27/18
DOCUMENT DATE:	10/26/18

NOT FOR CONSTRUCTION

ENLARGED POWER PLANS

SHEET:
E2.3

Order Plans @ WWW.LDILine.com