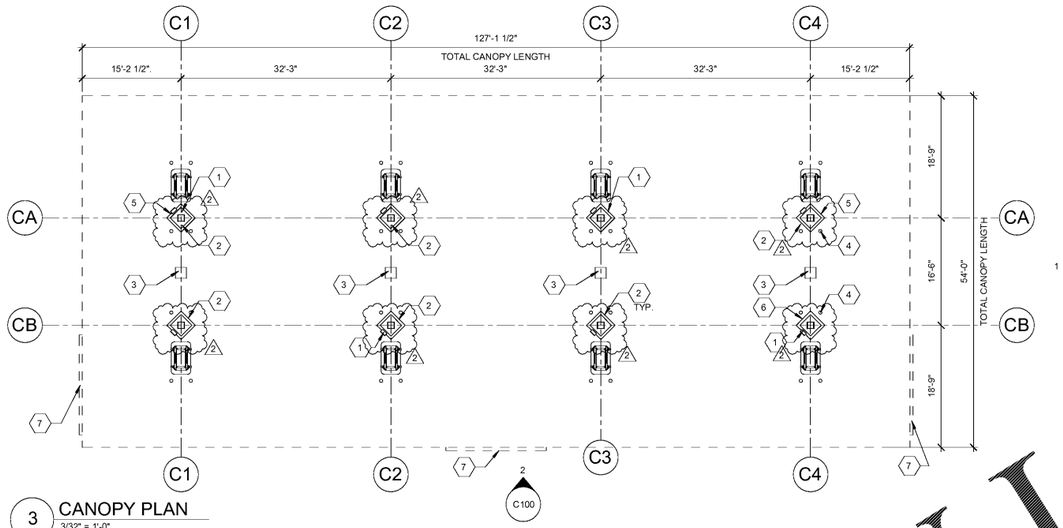

3 CANOPY PLAN
3/32" = 1'-0"

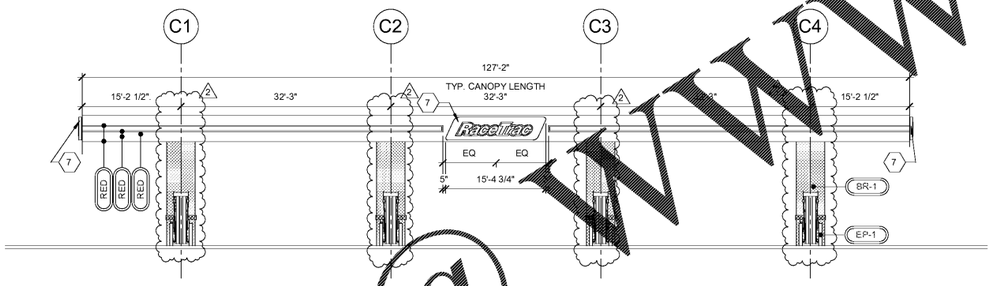

2 CANOPY FRONT ELEVATION
3/32" = 1'-0"

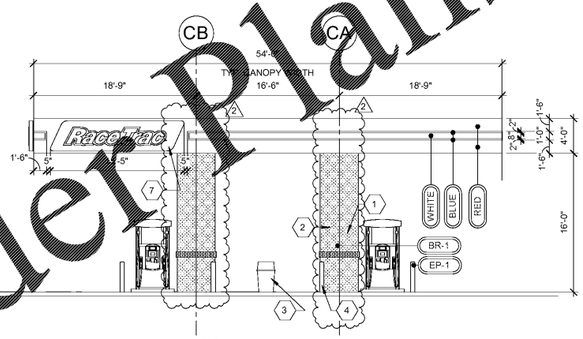

1 CANOPY ELEVATION
1/8" = 1'-0"

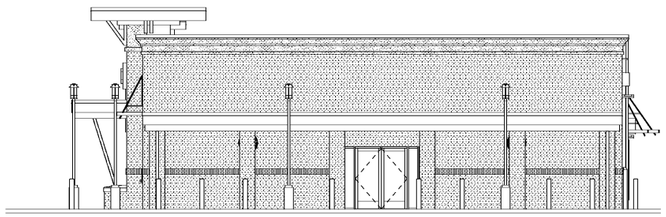

GENERAL NOTES

1. AREA WITHIN 18'-0" OF DISPENSER BOTH HORIZONTALLY AND VERTICAL SHALL BE CLASS I, DIVISION 2.
2. EXTINGUISHERS SHALL BE PROVIDED AND SO LOCATED THAT NO PUMP DISPENSER OR FILL-PIPE OPENING SHALL BE A GREATER DISTANCE THAN 50'-0"FROM SUCH DISPENSER.
3. NO SMOKING SIGNS SHALL BE POSTED IN ACCORDANCE WITH LOCAL JURISDICTION REQUIREMENT.
4. PVC PIPE SHALL NOT BE USED ON TOP OF CANOPY. ONLY 3/4" EMT WITH WATER TIGHT CONNECTIONS SHALL BE PERMITTED.
5. REFER TO ELECTRICAL SCHEDULES FOR CANOPY CIRCUITS.
6. REFER TO SITE ELECTRICAL PLAN FOR SECURITY CAMERA LOCATIONS AND MOUNTING.
7. REFER TO FINISH SCHEDULES FOR MATERIAL SPECIFICATIONS.
8. REFER TO SITE PLAN FOR NUMBER OF CANOPY SEALS TO BE PLACED.
9. REFER TO MANUFACTURERS SHOP DRAWINGS FOR ALL STRUCTURAL DETAILS.
10. REFER TO SITE SPECIFIC PLAN FOR CANOPY LIGHTING.
11. REFER TO SITE SPECIFIC PLAN FOR CONCRETE ISLAND LAYOUT.
12. REFER TO CANOPY MANUFACTURER'S DRAWINGS FOR ADDITIONAL INFORMATION ON COLUMN SURROUND.

SHEET KEYNOTES

1	M2M RED MARK II CABINET WITH RED COVER, ON BACK SIDE OF COLUMN COVER. PROVIDE ONE 80-B RATED EXTINGUISHER.
2	TOWEL DISPENSER *DCI MARKETING* ITEM NUMBER SBWC BLACK.
3	TRASH CAN. REFER TO SITE PLANS.
4	BUMPER POST. REFER TO CIVIL SITE DETAIL SHEETS.
5	WOODFORD Y-34 FREEZERLESS IOWA YARD HYDRANT
6	STEEL CANOPY COLUMN, PAINTED EP-1
7	RACETRAC LOGO; REFER TO SIGN PLAN

FUEL CANOPY MATERIAL SCHEDULE

ID	MANUF.	MATERIAL	COMMENTS
BRICK			
BR-1	BORAL	LAREDO BRICK	MORTAR COLOR "LIGHT BUFF"
FASCIA			
BLUE	-		2" BLUE STRIPE
RED	-		REFER TO SPECIFICATION CHART ON SHEET C100
WHITE	-		8" WHITE STRIPE
PAINT			
EP-1	SHERWIN WILLIAMS	EXTERIOR PAINT TO SW #7020 "BLACK FOX"	

STANDARD CANOPY FASCIA COLOR SPECIFICATION CHART

COLOR CALLOUT	CANOPY MANUFACTURER	STANDARD COLOR SPECIFICATION
"TAN"	LANE CANOPIES	ETT TAN FASCIA
	McGEE CANOPIES	ETT TAN FASCIA
	MADISON CANOPIES	PUEBLO TAN FASCIA
"RED"	LANE CANOPIES	TRD RED FASCIA
	McGEE CANOPIES	TRD RED FASCIA - PROGRAM RED
	MADISON CANOPIES	PROGRAM RED FASCIA

RaceTrac.
COPYRIGHT NOTICE
THESE PLANS ARE SUBJECT TO FEDERAL COPYRIGHT LAWS: ANY USE OF SAME WITHOUT THE EXPRESSED WRITTEN PERMISSION OF RACETRAC PETROLEUM, INC. IS PROHIBITED. 2018 RACETRAC PETROLEUM INC.

DESIGN PROFESSIONALS
HILL FOLEY ROSS & ASSOCIATES
ARCHITECTURE
ENGINEERING
3680 Pleasant Hill Road
Suite 200
Duluth, Georgia 30096
p 770.622.9858
f 770.622.9535
www.hillfoleyrossi.com

© Copyright (as dated below)
This drawing and all reproductions thereof are the property of Hill Foley Ross & Associates, LLC.(HFR). It is intended for the sole use of the project named hereon. Reproduction without the written consent of HFR is unlawful. All rights are to be retained to HFR upon project completion.

ISSUE/REVISION RECORD

DATE	DESCRIPTION
08/21/18	ISSUED FOR PERMIT
11/08/18	REV-2 RT COMMENTS

RaceTrac.
RACETRAC PETROLEUM, INC.
200 GALLERIA PKWY SE
SUITE 900
ATLANTA, GEORGIA 30339
(770) 431-7600

PROJECT NAME

EAST MAIN STREET

CARTERSVILLE
GEORGIA
1325 E. MAIN ST.
CARTERSVILLE, GA 30121

RACETRAC PROJECT NUMBER

1310

PROTOTYPE SERIES 5.5K 2.0

2018 RH MO

PLAN MODIFICATION NOTICE

SPB NO. DATE

STANDARD PLAN BULLETINS (SPB) MODIFY THE PROTOTYPE SERIES SET NOTED ABOVE. THE LISTED SPB REPRESENTS THE LATEST MODIFICATION INCORPORATED TO THIS PROTOTYPE SERIES SET AT ORIGINAL RL RELEASE. THE ISSUE/REVISION RECORD COLUMN ABOVE LISTS ANY REVISIONS OR SPB INCORPORATED IN THIS SET AFTER THE ORIGINAL RELEASE. CONTACT RACETRAC ENGINEERING AND CONSTRUCTION FOR ANY SUBSEQUENT BULLETINS NOT INCORPORATED HEREIN.

PROFESSIONAL SEAL

STATE OF GEORGIA
JON B. ERICKSON
CERTIFICATE NO. 026107
REGISTERED ARCHITECT
11/08/18

PROJECT NUMBER

18.714.00

SHEET TITLE

FUEL CANOPY PLANS AND ELEVATIONS

SHEET NUMBER

C100

ISSUE FOR PERMIT

Order Plans @ WWW.LDILine.com