MIAMI-DADE COUNTY
DEPARTMENT OF REGULATORY AND ECONOMIC RESOURCES (RER)
BOARD AND CODE ADMINISTRATION DIVISION

MIAMI-DADE COUNTY
PRODUCT CONTROL SECTION
11805 SW 26 Street, Room 208
T (786) 315-2590 F (786) 315-2599
www.miamidade.gov/economy

NOTICE OF ACCEPTANCE (NOA)

QuikServ Corp.
11441 Brittmoore Park Drive
Houston, TX 77240

SCOPE:
This NOA is being issued under the applicable rules and regulations governing the use of construction materials. The documentation submitted has been reviewed and accepted by Miami-Dade County RER-Product Control Section to be used in Miami-Dade County and other areas where allowed by the Authority Having Jurisdiction (AHJ).
This NOA shall not be valid after the expiration date stated below. The Miami-Dade County Product Control Section (In Miami-Dade County) and/ or the AHJ (in areas other than Miami-Dade County) reserve the right to have this product or material tested for quality assurance purposes. If this product or material fails to perform in the accepted manner, the manufacturer will incur the expense of such testing and the AHJ may immediately revoke, modify, or suspend the use of such product or material within their jurisdiction. RER reserves the right to revoke this acceptance, if it is determined by Miami-Dade County Product Control Section that this product or material fails to meet the requirements of the applicable building code.
This product is approved as described herein, and has been designed to comply with the Florida Building Code, including the High Velocity Hurricane Zone.

DESCRIPTION: Series "Commercial" Aluminum Pass-Through Horizontal Sliding Window – L.M.I.

APPROVAL DOCUMENT: Drawing No. 15-016, titled "Commercial Pass-Thru Windows – Large Missile Impact Resistant", sheets 01 through 14 of 14, dated 11/15/13, with revision no. "1" dated 03/11/15, prepared by Tilteco, Inc., signed and sealed by Walter A. Tillit, P. E., bearing the Miami-Dade County Product Control Revision stamp with the Notice of Acceptance number and Expiration date by the Miami-Dade County Product Control Section.

MISSILE IMPACT RATING: Large and Small Missile Impact Resistant

LABELING: Each unit shall bear a permanent label with the manufacturer's name or logo, city, state, series, and following statement: "Miami-Dade County Product Control Approved", unless otherwise noted herein.

RENEWAL of this NOA shall be considered after a renewal application has been filed and there has been no change in the applicable building code negatively affecting the performance of this product.

TERMINATION of this NOA will occur after the expiration date or if there has been a revision or change in the materials, use, and/or manufacture of the product or process. Misuse of this NOA as an endorsement of any product, for sales, advertising or any other purposes shall automatically terminate this NOA. Failure to comply with any section of this NOA shall be cause for termination and removal of NOA.

ADVERTISEMENT: The NOA number preceded by the words Miami-Dade County, Florida, and followed by the expiration date may be displayed in advertising literature. If any portion of the NOA is displayed, then it shall be done in its entirety.

INSPECTION: A copy of this entire NOA shall be provided to the user by the manufacturer or its distributors and shall be available for inspection at the job site at the request of the Building Official.
This NOA revises NOA No. 13-1203.09 and consists of this page 1 and evidence pages E-1 and E-2, as well as approval document mentioned above.
The submitted documentation was reviewed by Jaime D. Gascon, P. E.

MIAMI-DADE COUNTY APPROVED

NOA No. 15-0316.03
Expiration Date: March 25, 2019
Approval Date: April 09, 2015
Page 1

QuikServ Corp.

NOTICE OF ACCEPTANCE: EVIDENCE SUBMITTED

A. DRAWINGS
1. Manufacturer's die drawings and sections.
(Submitted under NOA No. 08-1210.04)
2. Drawing No. 15-016, titled "Commercial Pass-Thru Windows – Large Missile Impact Resistant", sheets 01 through 14 of 14, dated 11/15/13, with revision no. "1" dated 03/11/15, prepared by Tilteco, Inc., signed and sealed by Walter A. Tillit, P. E.

B. TESTS
1. Test reports on: 1) Air Infiltration Test, per FBC, TAS 202-94
2) Uniform Static Air Pressure Test, Loading per FBC, TAS 202-94
3) Water Resistance Test, per FBC, TAS 202-94
4) Large Missile Impact Test per FBC, TAS 201-94
5) Cyclic Wind Pressure Loading per FBC, TAS 203-94
6) Forced Entry Test, per FBC 2411.3.2.1, and TAS 202-94
along with marked-up drawings and installation diagram of an aluminum horizontal sliding window, prepared by Architectural Testing, Inc., Test Report No. ATI-85482.01-801-18, dated 12/01/08, signed and sealed by Joseph A. Reed, P. E.
(Submitted under NOA No. 08-1210.04)

C. CALCULATIONS
1. Anchor verification calculations and structural analysis, complying with FBC 5th Edition (2014), prepared by Tilteco, Inc., dated 03/11/15, signed and sealed by Walter A. Tillit, P. E.
2. Glazing complies with ASTM E1300-04/ 09

D. QUALITY ASSURANCE
1. Miami-Dade Department of Regulatory and Economic Resources (RER)

E. MATERIAL CERTIFICATIONS
1. Notice of Acceptance No. 14-0423.16 issued to Eastman Chemical Company (MA) for their "Saflex HP Clear or Color Glass Interlayers" dated 06/19/14, expiring on 04/14/18.
2. Material Safety Data Sheet of MSDS-17 High Density Polyethylene, dated 09/11/08 and issued by Quadrant Engineering Plastic Products USA, Inc., the latest revision dated 09/01/10 by M. Lykins.

Jaime D. Gascon, P. E.
Product Control Section Supervisor
NOA No. 15-0316.03
Expiration Date: March 25, 2019
Approval Date: April 09, 2015

E-1

QuikServ Corp.

NOTICE OF ACCEPTANCE: EVIDENCE SUBMITTED

F. STATEMENTS
1. Statement letter of conformance, complying with FBC 5th Edition (2014), dated 03/12/15, signed and sealed by Walter A. Tillit, P. E.
2. Department of State Certification of QuikServ Corporation as a foreign profit corporation, active and organized under the laws of the State of Florida, dated 01/13/15 and e-filed by the Secretary of State.
3. Statement letter of conformance, complying with FBC-2010, dated 11/13/13, signed and sealed by Walter A. Tillit, P. E.
(Submitted under NOA No. 13-1203.09)
4. Department of State Certification of QuikServ Corp. as a For-Profit Corporation, active and organized under the laws of the State of Texas, dated 01/07/14 and e-filed by the Secretary of State.
(Submitted under NOA No. 13-1203.09)
5. Statement letter of no financial interest, dated 12/02/08, signed and sealed by Walter A. Tillit, P. E.
(Submitted under NOA No. 08-1210.04)
6. Department of State Certification of QuikServ Corp. as a For-Profit Corporation, active and organized under the laws of the State of Texas, dated 07/15/08, filed and signed by Phil Wilson, Secretary of State.
(Submitted under NOA No. 08-1210.04)
7. Laboratory addendum letter for Test Report No. ATI-85482.01-801-18, issued by Architectural Testing, Inc., dated 02/16/09, signed and sealed by Joseph A. Reed, P. E.
(Submitted under NOA No. 08-1210.04)
8. Laboratory compliance letter for Test Report No. ATI-85482.01-801-18, issued by Architectural Testing, Inc., dated 12/05/08, signed and sealed by Joseph A. Reed, P. E.
(Submitted under NOA No. 08-1210.04)

G. OTHERS
1. Notice of Acceptance No. 13-1203.09, issued to QuikServ Corp. for their Series "Impact Pass-Thru Horizontal Sliding Aluminum Pass-Through Window – L.M.I.", approved on 02/13/14 and expiring on 03/25/19.

Jaime D. Gascon, P. E.
Product Control Section Supervisor
NOA No. 15-0316.03
Expiration Date: March 25, 2019
Approval Date: April 09, 2015

E-2

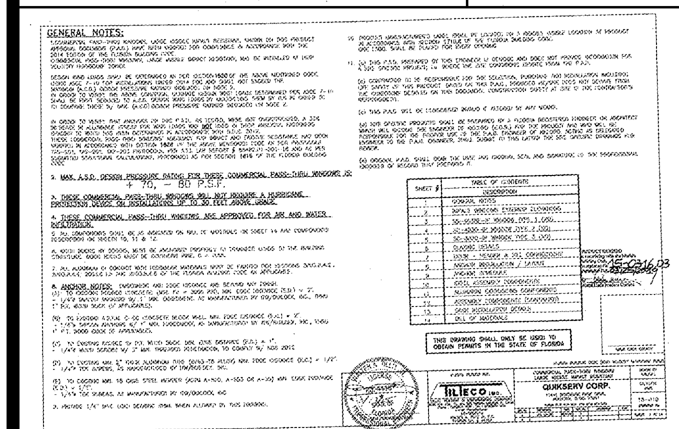

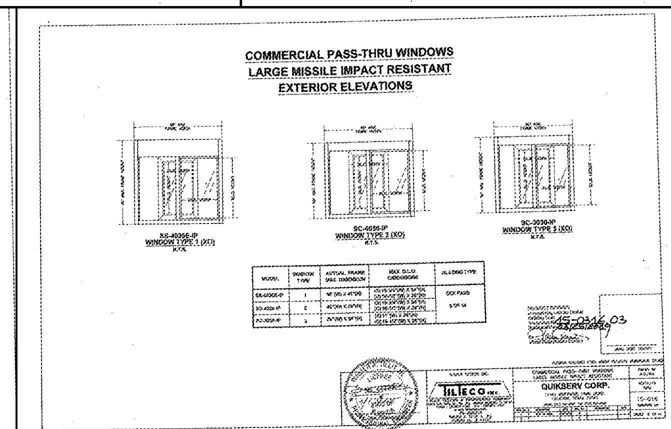

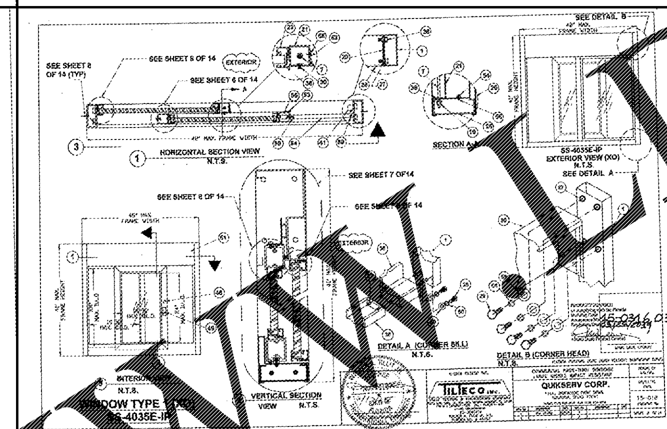

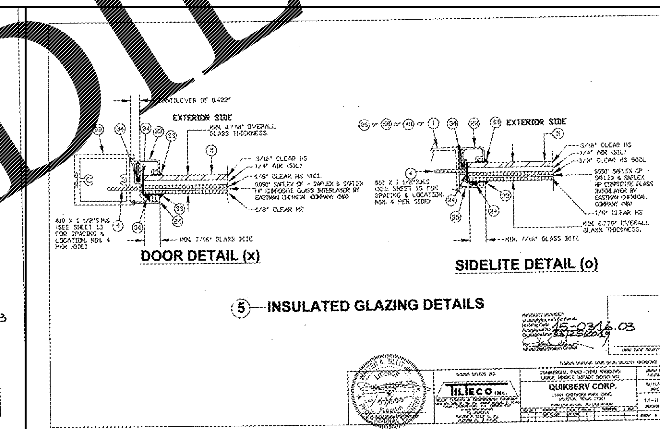

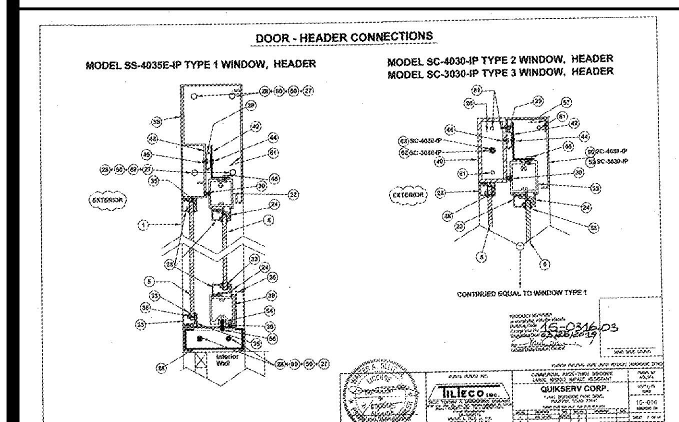

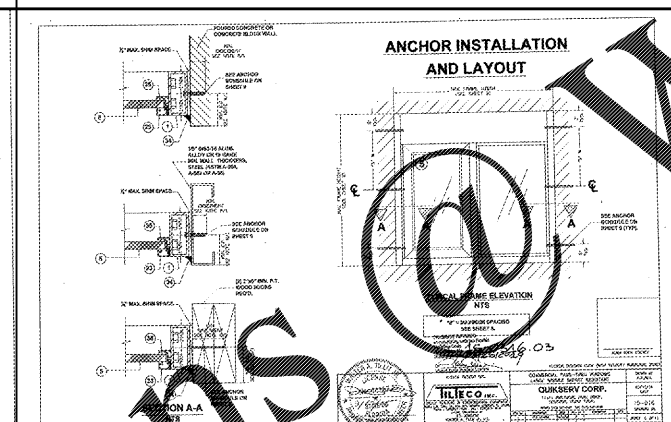

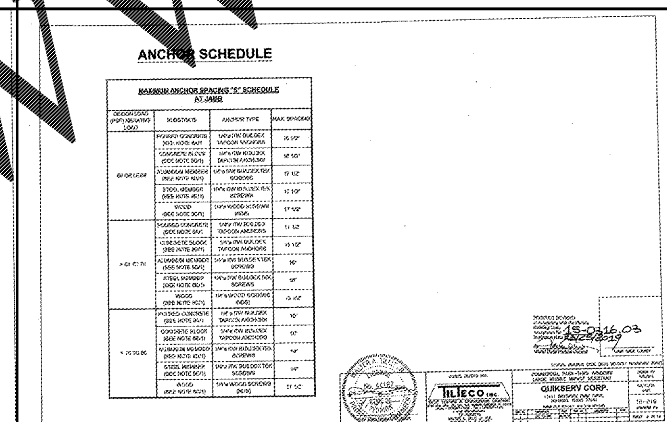

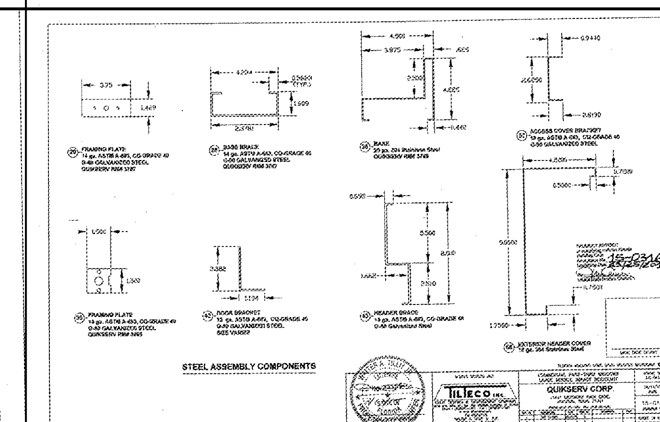

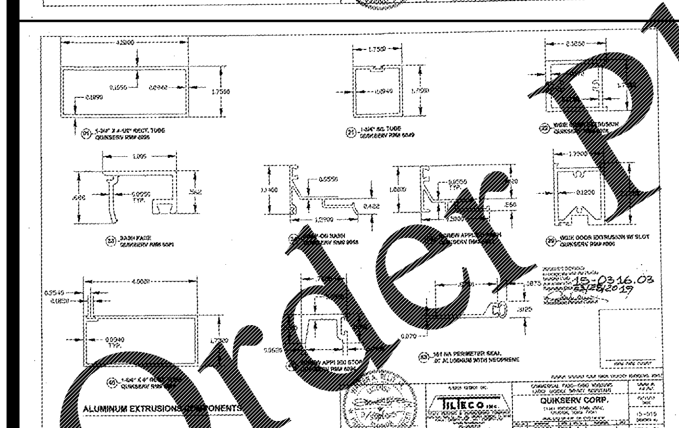

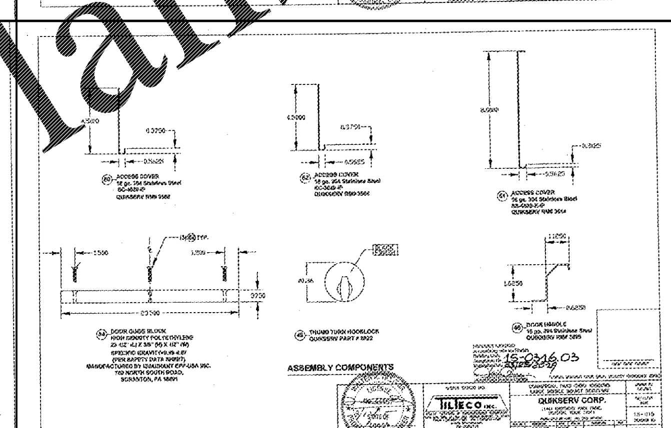

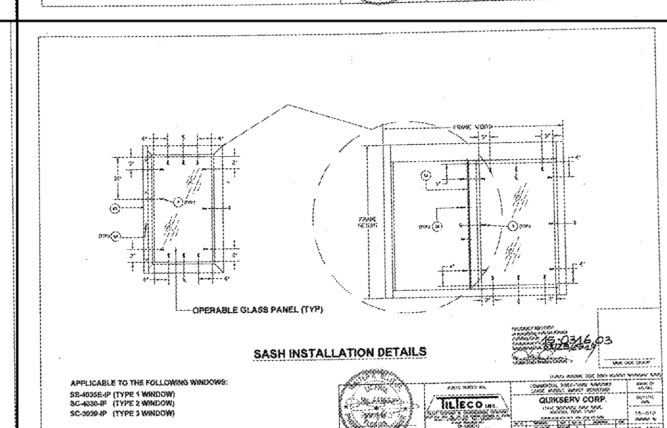

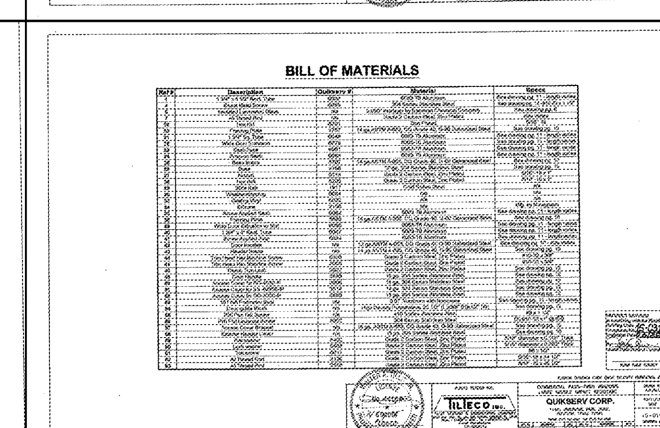

Order Plans @ WWW.LDILine.com

PANDA EXPRESS, INC.
1683 Walnut Grove Ave.
Rosemead, California
91770
Telephone: 626.799.9898
Facsimile: 626.372.8288

All ideas, designs, arrangement and plans indicated or represented by this drawing are the property of Panda Express Inc. and were created for use on this specific project. None of these ideas, designs, arrangements or plans may be used by or disclosed to any person, firm, or corporation without the written permission of Panda Express Inc.

REVISIONS:

ISSUE DATE:

1st	ISSUE FOR BUILDING PERMIT	08-16-18
2nd	ISSUE FOR BID	11-29-18

DRAWN BY: RR

PANDA PROJECT #: S8-19-D6558
ARCH PROJECT #: 1804

RANDY REYNOLDS ARCHITECT
315 WALTER ROBERTS ST * FRANKLIN, TN 37064
PHONE (615) 496-6750 * FAX (866) 584-1225
REGISTERED FLORIDA ARCHITECT # AR0015528

FL NOA DOCUMENTATION — FOR INFORMATION ONLY

PANDA EXPRESS
US 98 and PORTSIDE DRIVE
3868 GULF BREEZE PARKWAY
GULF BREEZE, FL

2200 TRUE - R1 - DAB 12

NOA - 3

NOA DOCUMENTATION
DRIVE-THRU WINDOW SYSTEM