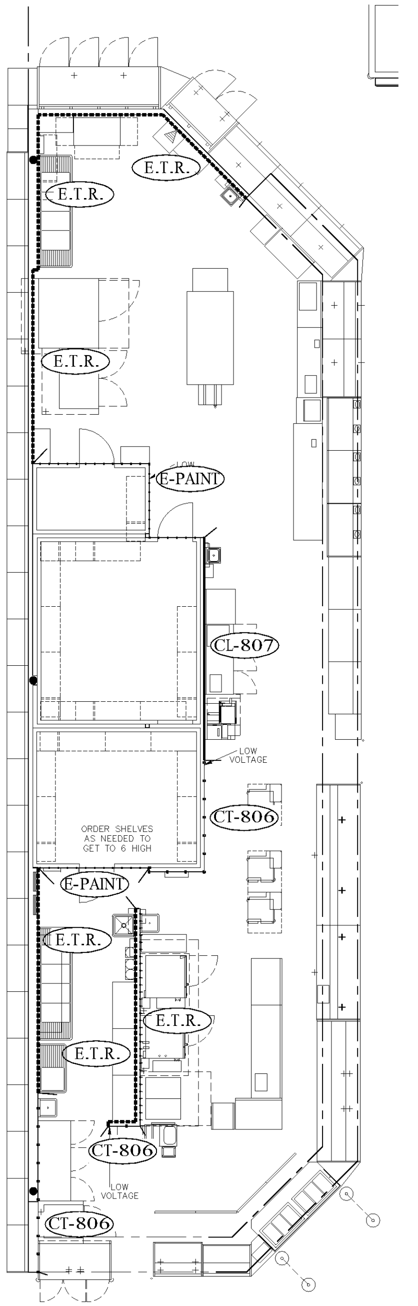

DELI / BAKERY WALL FINISH PLAN
SCALE: 3/16" = 1'-0"

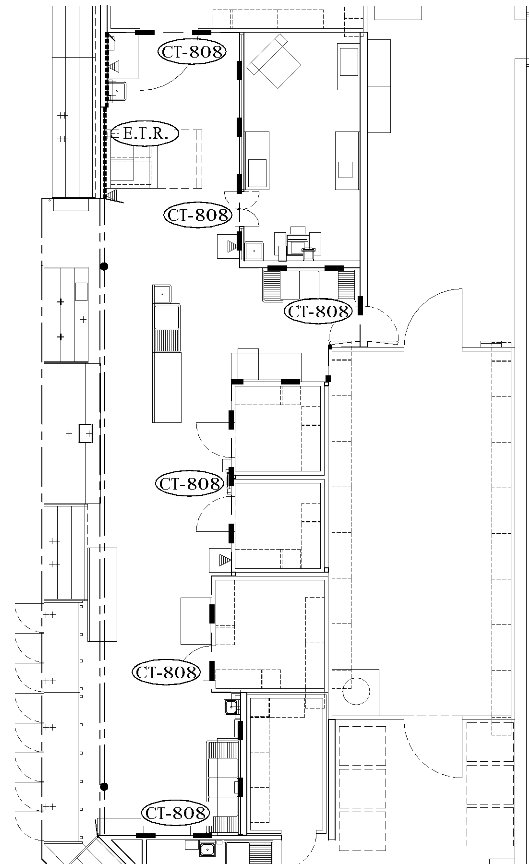

SERVICE MEAT & SEAFOOD WALL FINISH PLAN
SCALE: 3/16" = 1'-0"

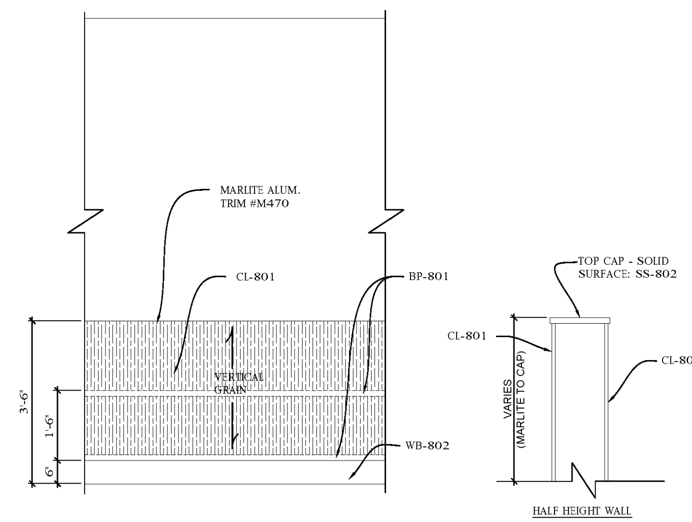

A — TYP. WALL/HALF WALL WAINSCOT DETAIL
SCALE: 3/4"=1'-0"
NOTE: CONTINUE WALL COVERING 6" MIN BEYOND FIXTURES (TYP)

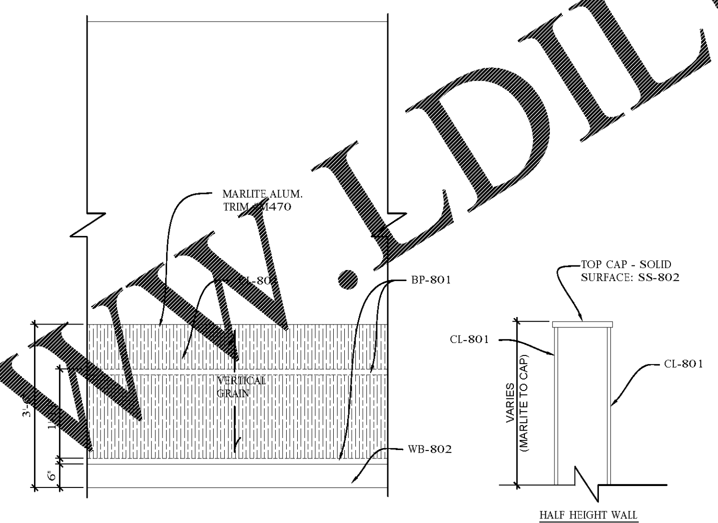

C — TYP. WALL/HALF WALL WAINSCOT DETAIL PHARMACY SEATING
SCALE: 3/4"=1'-0"
NOTE: CONTINUE WALL COVERING 6" MIN BEYOND FIXTURES (TYP)

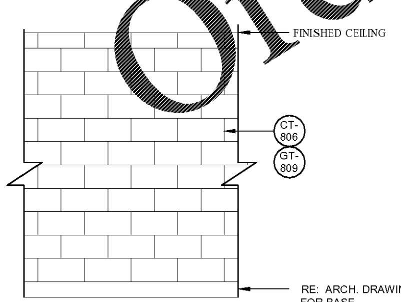

CT806 — TILE DETAIL AT DELI SERVICE AREA
SCALE: 3/4"=1'-0"

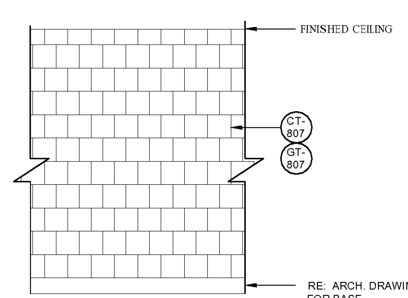

CT807 — TILE DETAIL AT BAKERY SERVICE AREA
SCALE: 3/4"=1'-0"

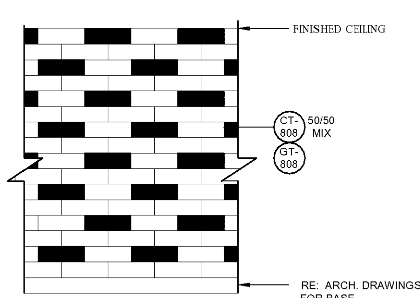

CT808 — TILE DETAIL AT MEAT/SEAFOOD SERVICE AREA
SCALE: 3/4"=1'-0"

WALL FINISH LEGEND

SYMBOL	DESCRIPTION
	~~CERAMIC TILE CT-204,CT-205~~
	~~FRP (KEMLITE PEBBLE) CL-803~~
	~~MURRAY'S CERAMIC TILE CT-801~~
	~~FRP (MARLITE ARTIZAN) CL-812~~
	~~GALVANIZED COOLER PANEL~~
	~~STAINLESS STEEL~~
	~~ELECTROSTATICALLY PAINTED PANELS~~
	~~WINE & BAR TILE CT-805~~
	DELI PREP CERAMIC TILE CT-806
	BAKERY PREP CERAMIC TILE CT-807
	MEAT/SEAFOOD CERAMIC TILE CT-808

FINISH SCHEDULE

FOR REFERENCE ONLY. REFER TO ARCH. CD'S FOR SPECIFICATIONS.

SYMBOL	DESCRIPTION	NOTES	KROGER DIRECT BUY	FURNISHED BY G.C.
	BUMPER & CORNER GUARD:			
BP-201	BOSTON BUMPER (OR EQUAL) 1" ECOFLEX 1000 - BLACK	WALL SURFACES FOR USE ON CL-201		•
BP-801	McCUE BUMPER - GREENGUARD 2 #609 DARK PUTTY	WALL SURFACES FOR USE ON CL-801		
~~CG-201~~	~~CORNER GUARD 3/4" X 3/4" EXTRUDED PLASTIC KOROGARD G875 OYSTER~~	~~WALLCOVERING EDGES~~		•
	CLADDING:			
~~SS-801~~	~~SOLID SURFACE - CANYON SWANSTONE~~	~~COUNTERTOPS FOR FIXTURES AND MILLWORK~~		
SS-802	SOLID SURFACE - ARISTECH SURFACES, LLC AVONITE - F1-8106, IVORY SOLID SURFACE - E.I. du PONT de NEMOURS & CO., CORIAN - BONE	WINDOW STOOLS & CAPS FOR LOW WALL LESS THAN 6'-0" AFF		•
SS-803	SOLID SURFACE - E.I DU PONT DE NEMOURS & CO. CORIAN - DEEP NIGHT SKY	SEATING AREA FOR LOW WALL LESS THAN 6'-0" AFF		•
CL-201	MARLITE WAINSCOT PANELING #5409 TOWNSEND FINISHED TOP - MARLITE ALUM. TRIM #M470 TIM PINNOW (330) 260-7631	WAINSCOT TO 3'-6" EXISTING TO REMAIN		•
CL-801	MARLITE FRP PANELING - VERTICAL GRAIN ARTIZAN FRP - #5345 COASTAL SILVER	WAINSCOT TO 3'-6"		•
CL-802	MARLITE - CUTSOM PATTERN PRINTED FRP PANELING - ARTIZAN FRP 196989 (B) ARZ 1115 MADAGASCAR	SEATING AREA WAINSCOT ...		•
CL-803	FIBERGLASS REINFORCED PLASTIC (FRP) PANELS CRANE COMPOSITES - KEMLITE GLASBORD WHITE, PEBBLE SURFACE	WAINSCOT PREP WALLS NOT VISIBLE TO CUSTOMER		•
~~CL-805~~	~~POWDER COATED STEEL COLUMN WRAP - MODRIX~~ CUSTOM - PC 031 SILVER VEIN	COLUMNS		•
CL-811	SLOTTED FIBERBOARD WALL PANELS - MARLITE SLATWALL, 2000 SERIES WILSONART 8210K-28 PORTICO TEAK	FOR USE IN FLORAL		•
~~CL-812~~	~~MARLITE FRP PANELING - CUSTOM PATTERN G12" X 24", PANEL SIZE 48" X 120" ARTIZAN FRP- #5408 MONTEREY SAND~~			•
~~CL-813~~	~~MARLITE - PRINTED FRP PANEL INDURO ... P610 HARD ROCK~~	CUSTOMER FACE LOW WALL NON-MURRAY CHEESE ISLAND		•
	CERAMIC TILE:			
~~CT-801~~	~~MOSAIC TILE -TEN THIRTY CERAMIC TILE 4"X12", 5/16" THICK - 13110 WHITE~~	~~TALL PREP WALLS BEHIND MURRAY'S CHEESE~~		•
CT-802	RECTIFIED PORCELAIN TILE 12" X24", 3/8" THICK URBAN COLLECTION - THREADS, OLIVE FINISH MATTE	TOILET ROOM FLOORS		•
CT-803	PORCELAIN TILE 4" X 12" SATIN FINISH URBAN COLLECTION - LTD17 EDGE OF SEVENTEEN	TOILET ROOM WALL TILE		•
CT-804	PORCELAIN TILE 4" X 12" GLOSS FINISH URBAN COLLECTION - LTD06 SIXTH SENSE	TOILET ROOM WALL STRIPE ACCENT BAND		•
CT-805	GLASS METAL, STONE TILE 4" X 15" - DALTILE ENDEAVORS, F162 ZEN STD F16258RANDSWTCH	WINE/ GROWLERS BAR		•
CT-806	CERAMIC TILE 6" X12", GLOSS FINISH, MOSA TILE MURALS BLEND #16630: PLAIN GREY BEIGE, #30590:MID WARM GREY #4	DELI PREP WALL TILE 50/50 MIX OF TWO COLORS,HORIZONTALLY BRICKLAY PATTERN		•
CT-807	CERAMIC TILE - 6" X 6", MATTE FINISH - MOSA TILE MURALS BLEND #32110: AIR BLEND #1	BAKERY PREP WALL TILE		•
CT-808	CERAMIC TILE -4" X12" 50/50 GLOSS/MATTE FINISH CROSSVILLE - WT09: NINE LIVES	MEAT/SEAFOOD WALL TILE, HORIZONTALLY BRICKLAY PATTERN		•
~~CT-809~~	~~PAVER TILE 2"X8" - DALTILE - BRICKWORK~~ ALCOVE BW04	DECORATIVE TILE ACCENT WALL RALPH'S & FRY'S		•
~~CT-810~~	~~QUARRY TILE - DALTILE - QUARRY TEXTURES 6X6~~ 0T08 SAHARA SAND	GROUT TO BE GT-805		•
~~CT-811~~	~~QUARRY TILE COVE BASE - DALTILE~~ QUARRY TEXTURES- 0T08 SAHARA SAND	GROUT TO BE GT-805		•
~~CT-812~~	~~PORCELAIN TILE 12" X12" URBAN COLLECTION~~ FUSHION, RIG	VESTIBULES UNSTAINED CONCRETE FLOOR		•
~~CT-813~~	~~PORCELAIN TILE 12" X12" URBAN COLLECTION~~ FUSHION, OTTO	VESTIBULES STAINED CONCRETE FLOOR		•
~~CT-814~~	~~PORCELAIN TILE 12" X24", MATTE FINISH~~ ATLAS CONCORD, DWELL, OFF WHITE	WINE / GROWLER BAR FRONT. GROUT TO BE GT-801. HORIZONTAL STACK PATTERN		•
~~CT-815~~	~~DALTILE - IRONCRAFT -CHARCOAL GRAY IC13~~ 12X24 LIGHT POLISHED, RUNNING BOND PATTERN	BAR PREP WALL		•
	GROUT:			
GT-801	TEC POWERGROUT #973, WARM TAUPE	WALL APPLICATION ONLY		•
~~GT-802~~	~~TEC ACCUCOLOR EFX EPOXY SPECIAL EFFECTS~~ #933, STANDARD GRAY	FLOOR APPLICATION ONLY		•
~~GT-803~~	~~TEC POWERGROUT #927, LIGHT PEWTER~~	WALLS		•
~~GT-804~~	~~TEC POWERGROUT #929, CHARCOAL GRAY~~	WINE/GROWLER BAR BACKSPLASH		•
~~GT-805~~	~~TEC ACCUCOLOR EFX EPOXY SPECIAL EFFECTS~~ #945, LIGHT BUFF	QUARRY TILE FLOORS		•
~~GT-806~~	~~TEC ACCUCOLOR EFX EPOXY SPECIAL EFFECTS~~ #929, CHARCOAL GRAY	VESTIBULE FLOOR ONLY		•
~~GT-807~~	~~TEC POWERGROUT #910, BRIGHT WHITE~~			•
~~GT-808~~	~~TEC POWERGROUT #939, MIST~~			•
~~GT-809~~	~~TEC POWERGROUT #903, BIRCH~~			•
	VINYL TILE:			
~~VT-801~~	~~LUXURY VINYL TILE - TP SERIES - ARMSTRONG TP063 DRIFTWOOD BRONZE - 9" X 48"~~	~~SPECIALTY DEPTS.~~		
~~VT-802~~	~~LUXURY VINYL TILE - TP SERIES - ARMSTRONG TP 331: CLASSICS BRACO MORTAR - 12" X 24"~~	~~MAIN FLOORS~~		
~~VT-803~~	~~LUXURY VINYL TILE - TP SERIES - ARMSTRONG TP 332: CLASSICS BRACO PUFFY - 12" X 24"~~	~~MAIN FLOORS~~		
~~VT-807~~	~~LUXURY VINYL TILE - TP SERIES - ARMSTRONG~~ TP 532: DELICATO OYSTER- 12" X 24"	REMODELS ONLY, SPECIALTY DEPTS.		
	PAINT:			
~~PT-801~~	~~#SW 7723 - COLONY BUFF~~	~~REMODELS AND~~ EXPANSIONS		•
PT-802	#SW 7009 - PEARLY WHITE	DRYWALL CEILINGS		•
PT-803	#SW 7069 - IRON ORE	HOLLOW METAL DOORS, FRAMES & ACCENT WALLS		•
PT-804	#SW 7019 - GAUNTLET GRAY			•
PT-805	#SW 6768 - GULFSTREAM			•
PT-806	#SW 6772 - CAY			•
PT-807	SW 6683 - BEE			•
PT-808	#SW 6681 - BUTTER UP			•
PT-809	#SW 9032 - STAY IN LIME			•
PT-810	#SW 7016 - MINDFUL GRAY			•
~~PT-811~~	~~#SW 6803 - DANUBE~~			•
~~PT-812~~	~~#SW 6802 - JACARANDA~~	LIQUOR STORE WALL COLOR		•
PT-814	#SW 9140 - BLUSTERY SKY	RESTROOM WALLS ABOVE TILE		
~~PT-815~~	~~#SW 4090 - BLACK~~			•
~~PT-816~~	~~#SW 4084 - SAFETY YELLOW~~			•
~~PT-817~~	~~#SW 7012 - CREAMY~~			
PT-818	#SW 6767 - AQUAMARINE	PAINTED WALL STENCILS		•
PT-819	#SW 6712 - LUAU GREEN	PAINTED WALL STENCILS		•
~~PT-820~~	~~#SW 6671 - CURRY~~	PAINTED WALL STENCILS		•
~~PT-821~~	~~#SW 6868 - REAL RED~~	MURRAY'S BAR & MURRAY'S STENCILS		•
~~PT-823~~	~~#SW 7007 - CEILING BRIGHT WHITE~~	PAINTED WALL STENCILS		•
~~PT-842~~	~~#SW 7037 - BALANCED BEIGE~~	FOR EXISTING PAINTED COOLER		•
~~PT-850~~	~~#SW 4091 - SILVER BRITE~~	METAL PIPE RAILINGS		•
WB-201	RENEW PLASTICS BUMPER TRIM W/ BEVELED TOP 1-1/2" X 7-1/2" BLACK	HIGH TRAFFIC AREAS; REFER TO DRAWINGS		•
WB-802	JOHNSONITE - RUBBER COVER BASE - 6"H - BLACK			•
	WALL COVERING			
WP-1	ZINSSER SHIELDZ - WALL COVERING PRIMER	PER DRAWINGS		•
	CARPET TILE:			
~~CP-801~~	CARPET TILE - 24" X 24" - BIGELOW/ MOHAWK ~~RENEGADE COLLECTION PATTERN: INSURGENT~~ 358 THRILL SEEKER	PHARMACY & ASSOC. AREAS & OPTIONAL C/S	NAT'L ACCOUNT AGREEMENT ITEM	•
~~CP-802~~	CARPET TILE - 12" X 36" - BIGELOW/ MOHAWK ~~LICHEN COLLECTION PATTERN: FIELD OVERLAY/~~ GT-403, 969 SUBSTRATE	DIP DEPT. FITTING ROOMS. INSTALL IN RANDOM PATTERN		•

d|fab DESIGN FABRICATIONS
1100 EAST MANDOLINE AVE. SUITE 100
MADISON HEIGHTS, MI 48071
T 800.968.9440
F 248.597.0989
designers@dfabdesign.com

COPYRIGHT © 2019
ALL DRAWINGS AND DESIGNS ARE THE SOLE PROPERTY OF DESIGN FABRICATIONS, INC. THESE DRAWINGS ARE NOT TO BE COPIED WITHOUT WRITTEN CONSENT FROM DESIGN FABRICATIONS, INC. THESE DRAWINGS WERE PREPARED EXCLUSIVELY FOR THIS PROJECT. IT IS ILLEGAL FOR UNAUTHORIZED PERSONS TO USE THESE DRAWINGS OR DESIGNS FOR ANY OTHER PROJECT.
DO NOT SCALE DRAWINGS- USE FIGURED DIMENSIONS ONLY.

SHEET TITLE: ENLARGED FINISH PLAN

PROJECT NAME: KROGER GA-478

PROJECT LOCATION: 3162 JOHNSON FERRY ROAD MARIETTA, GA

ISSUED FOR	DATE
80% REVIEW	03/22/19

NO.	REVISED BY:	DATE
⚠	XXX	XXX

DRAWN: BP / RA
CHECKED: CW
SCALE: SCALE: 3/16"=1'-0"
JOB NO.: NA
SHEET #: I1.5

Order Plans @ WWW.LDILine.com