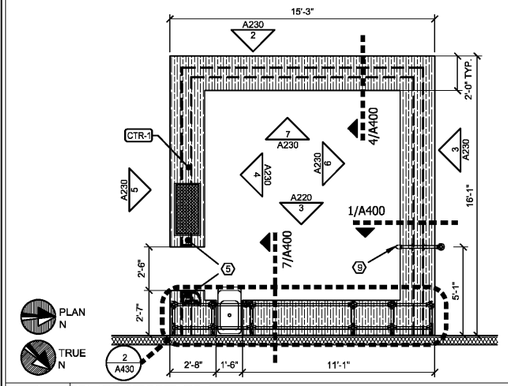

1 | KEY PLAN: BAR
1/4" = 1'-0" | NOTE:

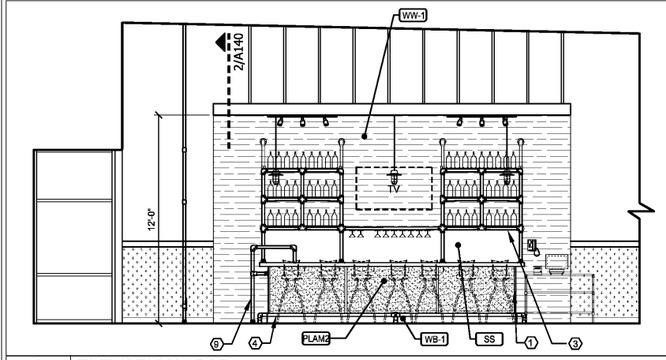

2 | ELEVATION : BAR
1/4" = 1'-0" | NOTE:

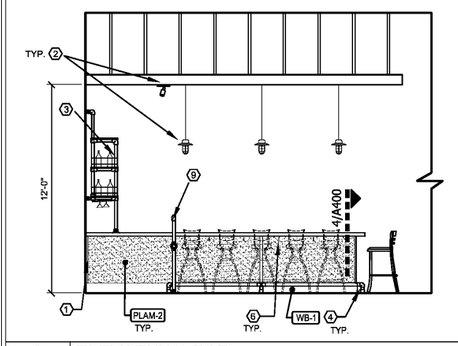

3 | ELEVATION : BAR
1/4" = 1'-0" | NOTE:

GENERAL NOTES:

1. SEE SHEETS K3-K5 FOR EQUIPMENT SCHEDULE.
2. SEE SHEET A127 FOR WALL FINISH PLAN.
3. ALL NOTES SHOWN ARE TYP. AT SIMILAR CONDITIONS.
4. PLAM-1 JOINTS: PROVIDE 1-1/2" X 1-1/2" GALVANIZED STEEL ANGLE TRIM AT CORNERS, 1-1/2" GALVANIZED STEEL FLAT STOCK TO COVER BUTT PANEL JOINTS, ATTACH WITH SILICONE ADHESIVE.

KEY NOTES: ⓧ

1. 1-1/2" X 1-1/2" STEEL ANGLE TRIM AT CORNERS, 1-1/2" STEEL FLAT STOCK TO COVER BUTT PANEL JOINTS, PLAM-2 AS NECESSARY.
2. LIGHT FIXTURE. SEE A600 FOR LIGHTING FIXTURES.
3. BAR SHELVES: 1 1/2" (INNER DIA.) GALVANIZED PIPE W/ KEE KLAMP FITTINGS.
4. 1 1/2" DIA. GALVANIZED PIPE FOOTRESTS W/ KEE KLAMP FITTINGS, 4/A400.
5. PROVIDE 3"X3" STEEL STIFFENER AT FREE ENDS OF WALL, EXPANSION ANCHOR TO SLAB, CONNECT TO WALL FRAMING.
6. PURSE HOOK: 1 PER SEAT AT 2'-0" APART.
7. 1X4 SELECT GRADE POPLAR TRIM, PAINT PT-6.
8. METAL SCREEN. SEE DETAILS ON SHEET A430.
9. PIPE RAIL DIVIDER: 1 1/2" (INNER DIA.) GALVANIZED PIPE W/ KEE KLAMP FITTINGS.
10. PROVIDE 2"X2" SQUARE PIPE SINK DECK SUPPORT. WELD LATERAL SUPPORT TO VERTICAL SECTION EMBEDDED IN WALL & BOLTED TO STUDS & FLOOR.
11. 1/8" X 1-1/2" WIDE GALVANIZED STEEL FLAT STOCK TRIM, SILICONE TO STEEL DIAMOND PLATE, TYP. AT ALL VERTICAL JOINTS NOT IN CORNERS.
12. 1/8" X 1-1/2" WIDE GALVANIZED STEEL ANGLE TRIM, SILICONE TO STEEL DIAMOND PLATE.

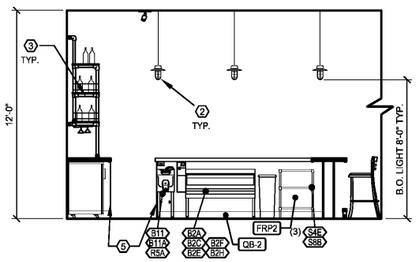

4 | ELEVATION : BAR
1/4" = 1'-0" | NOTE:

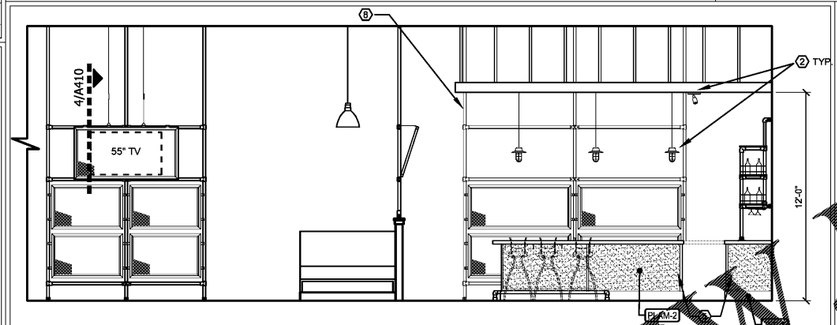

5 | ELEVATION : BAR
1/4" = 1'-0" | NOTE:

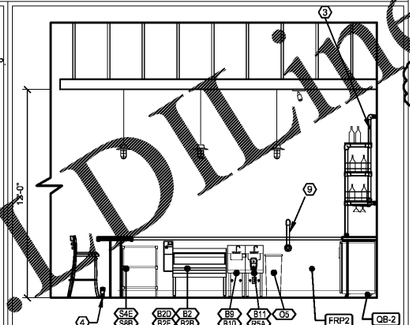

6 | ELEVATION : BAR
1/4" = 1'-0" | NOTE:

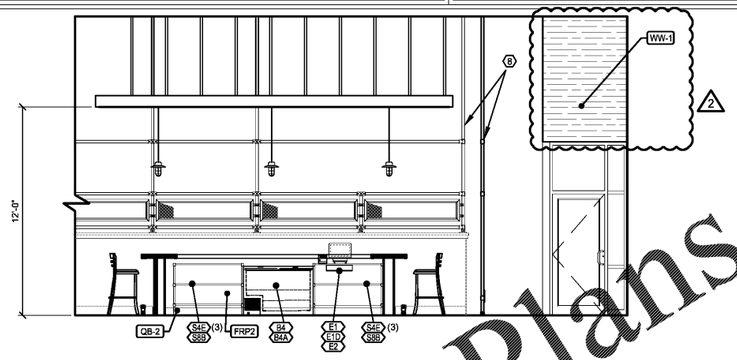

7 | ELEVATION: BAR
1/4" = 1'-0" | NOTE:

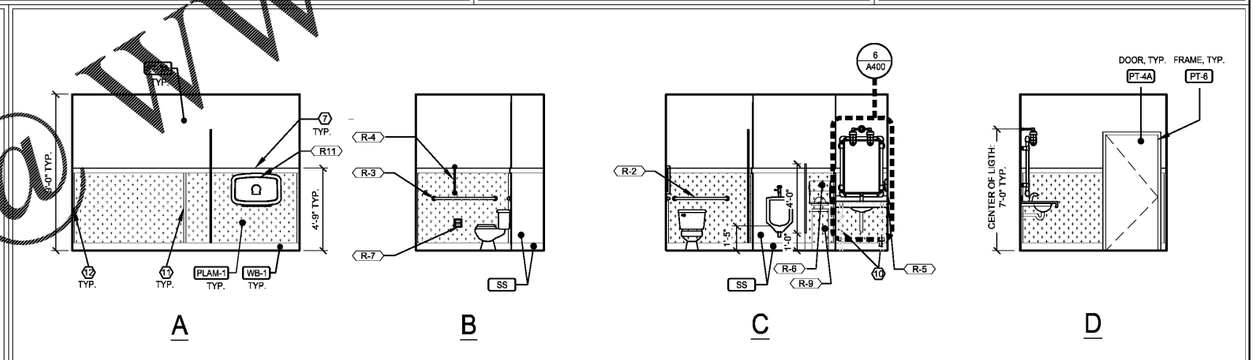

8 | ELEVATION: MEN'S RESTROOM
1/4" = 1'-0" | NOTE:

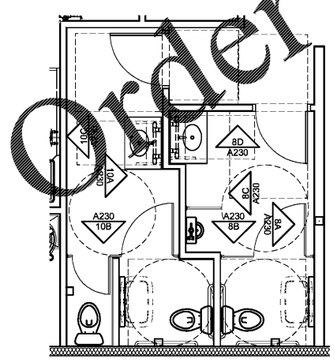

9 | KEY PLAN: RESTROOMS
1/4" = 1'-0" | NOTE:

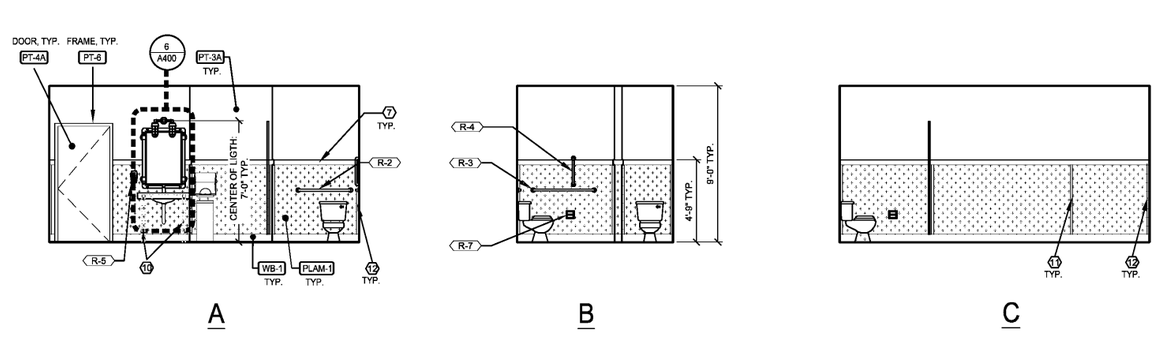

10 | ELEVATION: WOMEN'S RESTROOM
1/4" = 1'-0" | NOTE:

Order Plans @ www.LDLine.com

CONSULTANT:
JOHN SPONSELLER, ARCHITECT
8025 W. 25TH PL
LAKEWOOD, CO 80214
TEL: (303) 815-0161

GOOD TIMES RESTAURANTS, INC.
141 Union Blvd, Suite 400
Lakewood, CO 80228
303-384-1430

BAD DADDY'S BURGER BAR
"SANDY PLAINS"
3460 SANDY PLAINS RD N.E.
SUITE 110
MARIETTA, GA 30062

Issue Record:
6.7.2019 FOR PLAN REVIEW

Revisions:
△ 08.01.2019 BAR FIXT. TO GREASE WST.
△ 08.28.2019 OWNER REVS

Drawn: DRAWN BY: JS, KC
Checked: CHECKED BY: JS
Project No. PROJECT#: 19-213
Contents: INTERIOR ELEVATIONS

A230
2
Date of Last Print: 8.28.2019