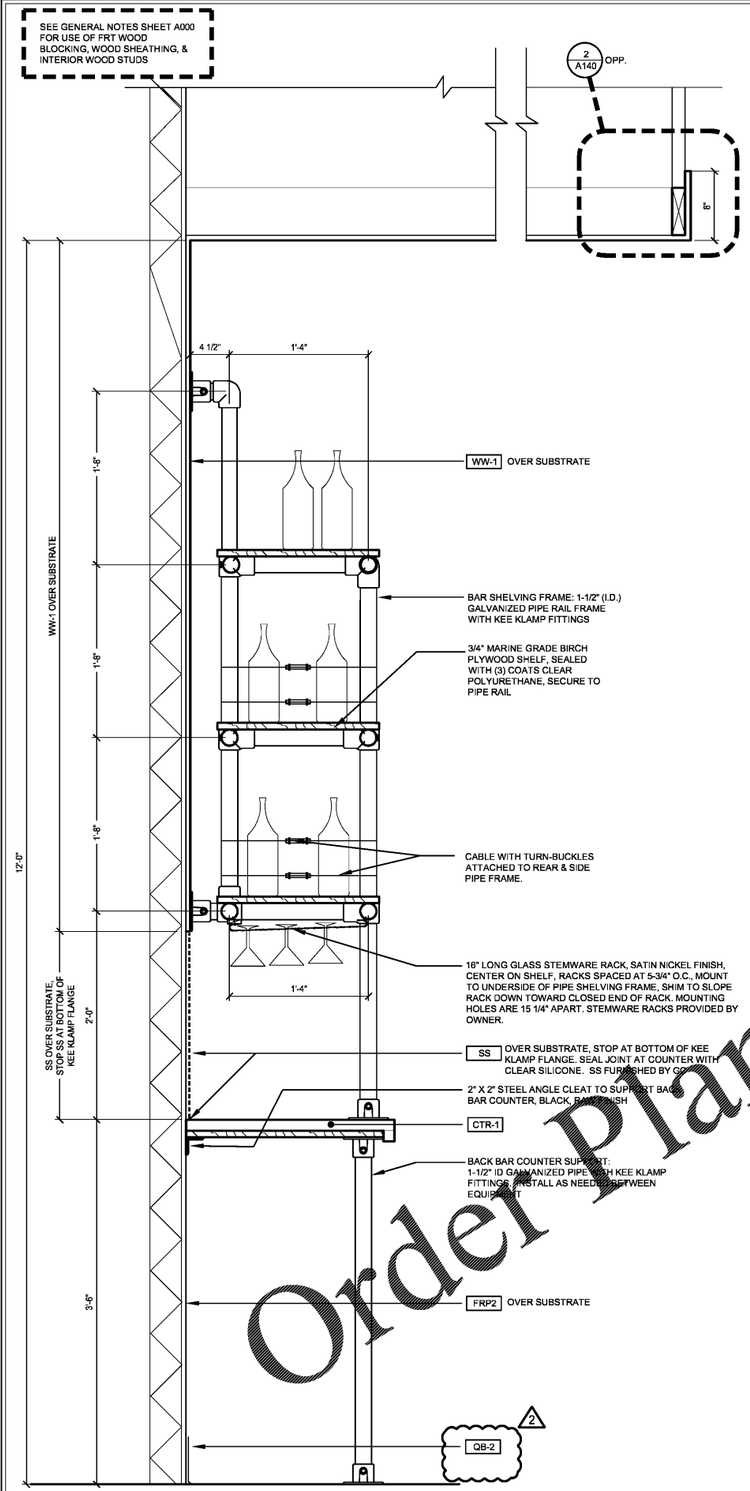

7 DETAIL : BAR SHELVING

1 1/2" = 1'-0" NOTE:

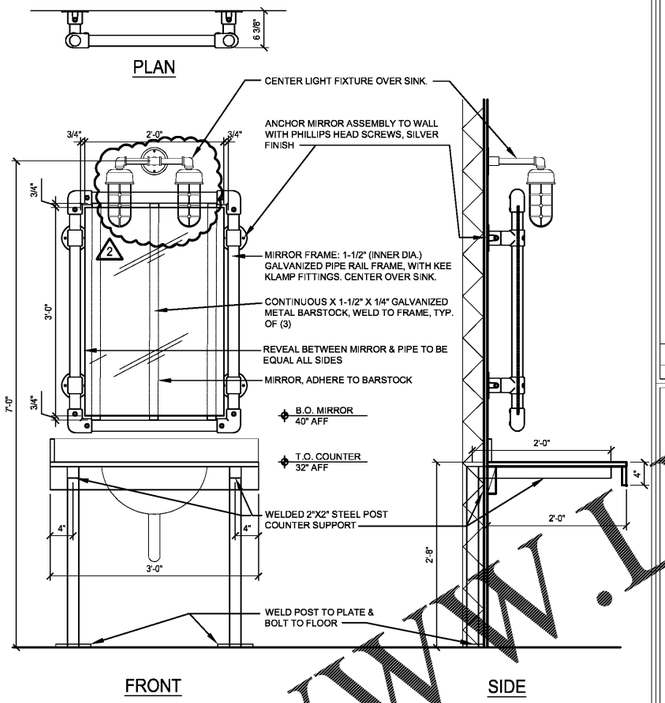

6 DETAIL: BATHROOM MIRROR FRAME

1" = 1'-0" NOTE:

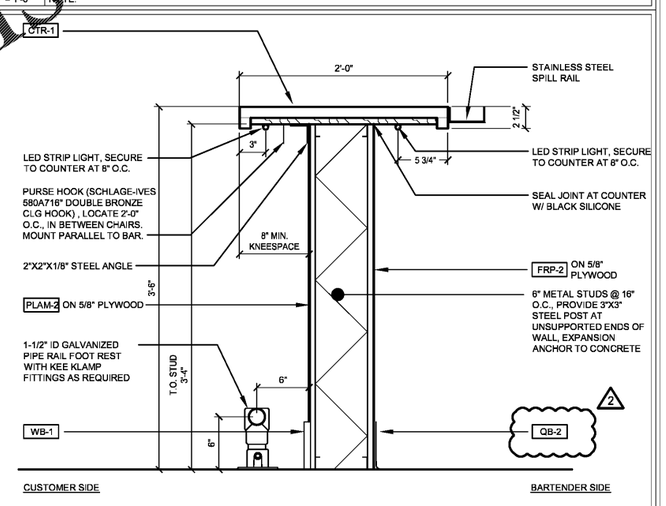

4 DETAIL: BAR COUNTER TYP.

1 1/2" = 1'-0" NOTE:

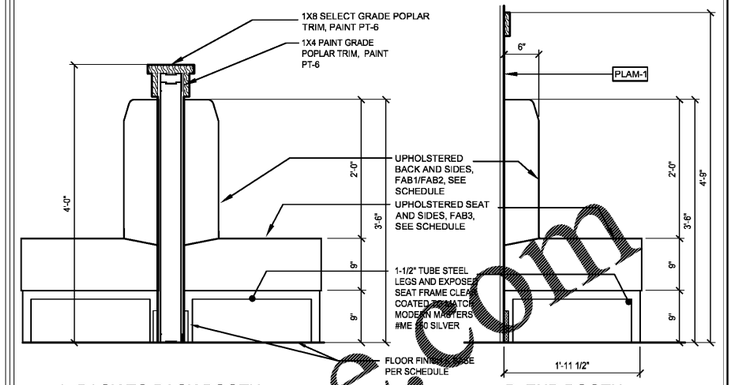

3 DETAIL: BOOTHS

1" = 1'-0" NOTE:

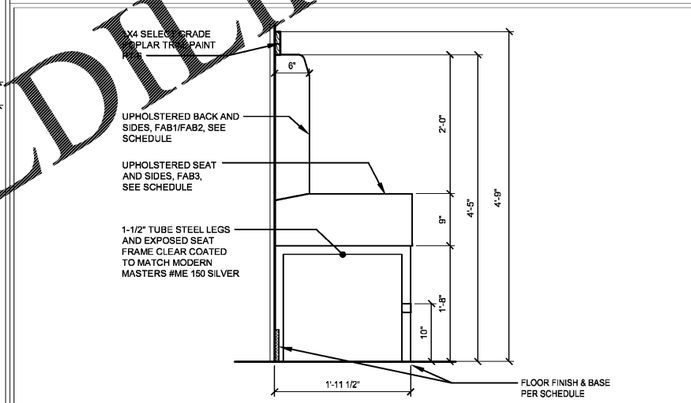

2 DETAIL: BANQUETTE AT BAR

1" = 1'-0" NOTE:

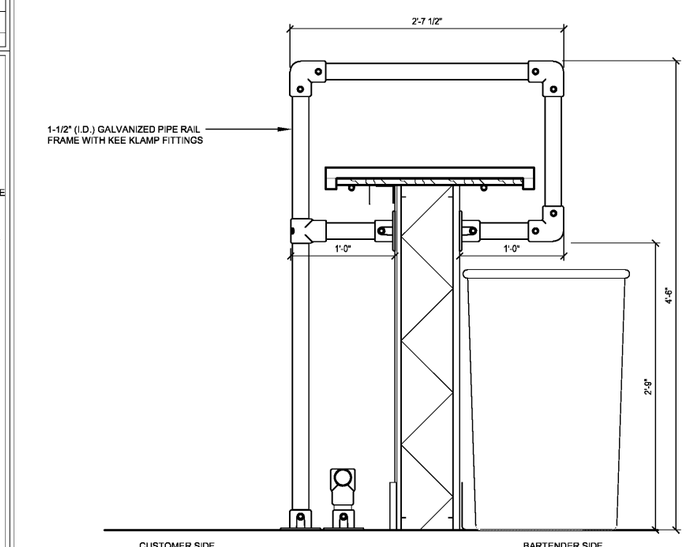

1 DETAIL: PIPE RAIL DIVIDER AT BAR COUNTER

1 1/2" = 1'-0" NOTE:

Order Plans @ WWW.LDRLine.com

CONSULTANT:
JOHN SPONSELLER, ARCHITECT
8025 W. 25TH PL
LAKEWOOD, CO 80214
TEL: (303) 815-0161

GOOD TIMES RESTAURANTS, INC.
141 Union Blvd, Suite 400
Lakewood, CO 80228
303-384-1430

BAD DADDY'S BURGER BAR
"SANDY PLAINS"
3460 SANDY PLAINS RD N.E.
SUITE 110
MARIETTA, GA 30062

Issue Record:
6.7.2019 FOR PLAN REVIEW

Revisions:
△1 08.01.2019 BAR FIXT. TO GREASE WST.
△2 08.28.2019 OWNER REVS

Drawn: DRAWN BY: JS, KC

Checked: CHECKED BY: JS

Project No. PROJECT#: 19-213

Contents: DETAILS

A400

Date of Last Print: 8.28.2019