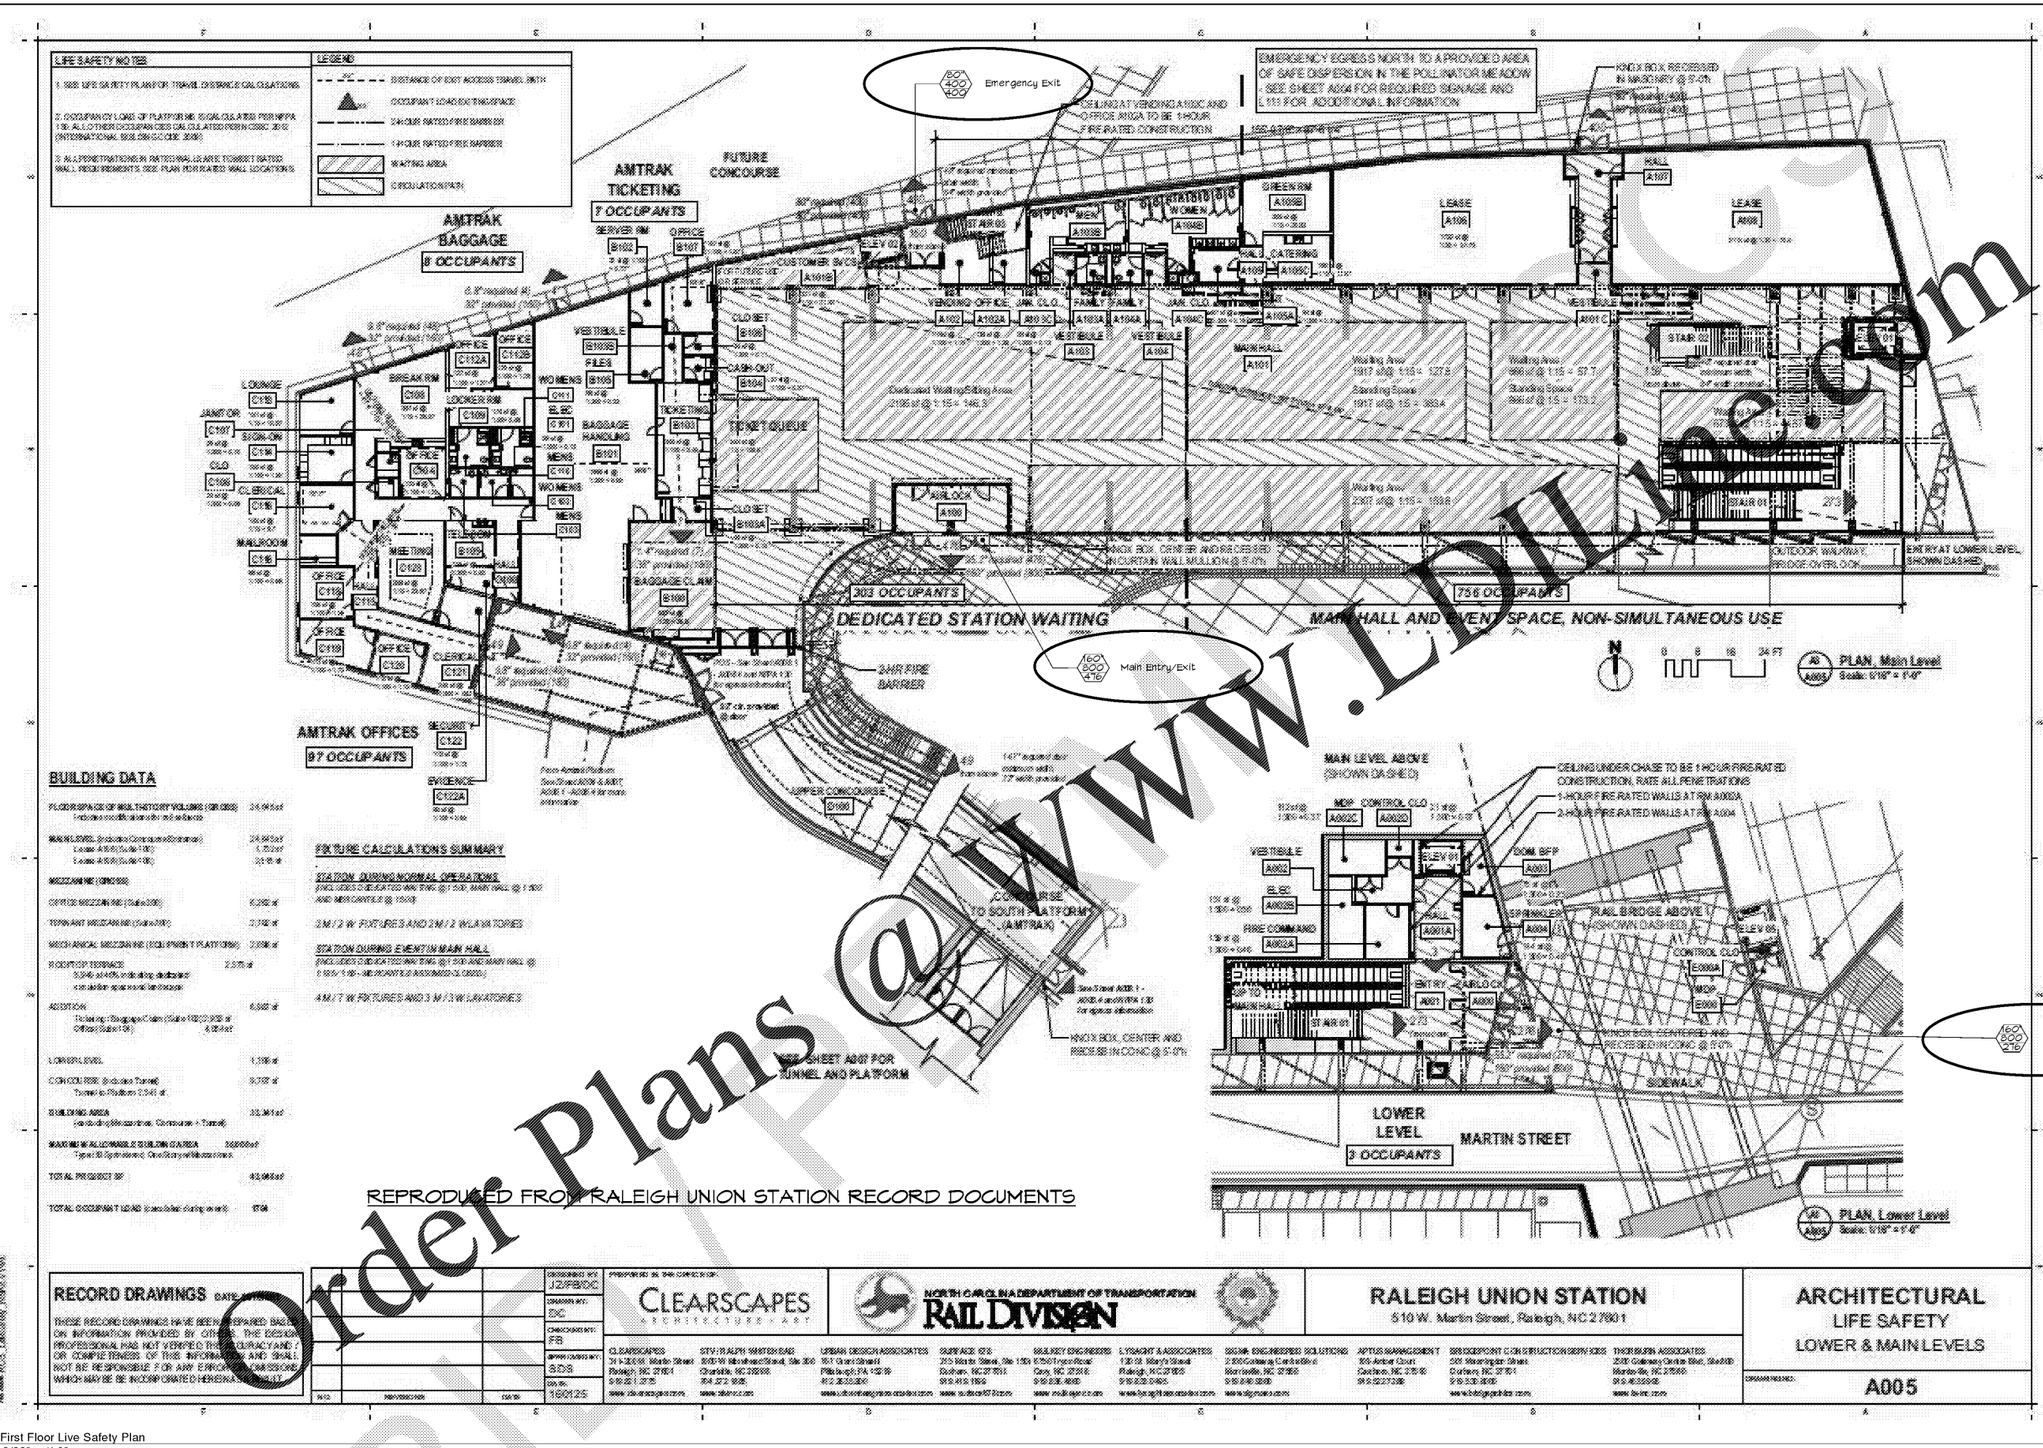

REPRODUCED FROM RALEIGH UNION STATION RECORD DOCUMENTS

Order Plans @ www.LDILine.com

BID / PERMIT SET

RECORD DRAWINGS

THESE RECORD DRAWINGS HAVE BEEN PREPARED BASED ON INFORMATION PROVIDED BY OTHERS. THE DESIGN PROFESSIONAL HAS NOT VERIFIED THE ACCURACY AND / OR COMPLETENESS OF THIS INFORMATION AND SHALL NOT BE RESPONSIBLE FOR ANY ERRORS OR OMISSIONS WHICH MAY BE BE INCORPORATED HEREIN AS A RESULT.

DESIGNED BY: JZ/PB/DC
DRAWN BY: DC
CHECKED BY: FB
APPROVED BY: SDS
DATE: 160125

PREPARED BY THE CONSULTANT: CLEARSCAPES ARCHITECTURE + ART

NORTH CAROLINA DEPARTMENT OF TRANSPORTATION RAIL DIVISION

RALEIGH UNION STATION
510 W. Martin Street, Raleigh, NC 27601

ARCHITECTURAL
LIFE SAFETY
LOWER & MAIN LEVELS

DRAWING NO.: A005

1 First Floor Live Safety Plan
3/32" = 1'-0"

BUY AMERICAN PROGRAM REQUIREMENTS

ALL PRODUCTS PROVIDED ON THIS PROJECT MUST BE MANUFACTURED IN COMPLIANCE WITH THE BUY AMERICAN PORGRAM FOR FEDERALLY FUNDED TRANSPORTATION PROJECTS PER CODE OF FEDERAL REGULATIONS 49 CFR 661. THESE REQUIREMETNS ARE DISTINCT AND DIFFERENT FROM THOSE OF THE BUY AMERICAN ACT OF 1933.

INNOVATIVE DESIGN
850 W. MORGAN STREET
RALEIGH, NORTH CAROLINA 27603
919-832-6303
919-832-3339 FAX

Bid / Permit Documents

SEAL: 11/8/2019

Union Station Mezzanine Office Fit Up
City of Raleigh Transit Division
510 W Martin St, Raleigh, NC 27601

NO.	SUBMISSION	DATE
10		
9		
8		
7		
6		
5		
4		
3	Bid / Permit Set	11/8/19
2	CD	10/31/19
1	SD	9/25/19

CHECKED BY: Checker
DRAWN BY: Author
PROJECT NUMBER: 1908
SHEET NAME: LIFE SAFETY PLAN
SHEET NUMBER: LS200

COPYRIGHT Innovative Design 2019

C:\Users\lou\Documents\1908 Union Station A Central V19_louisgerics.rvt