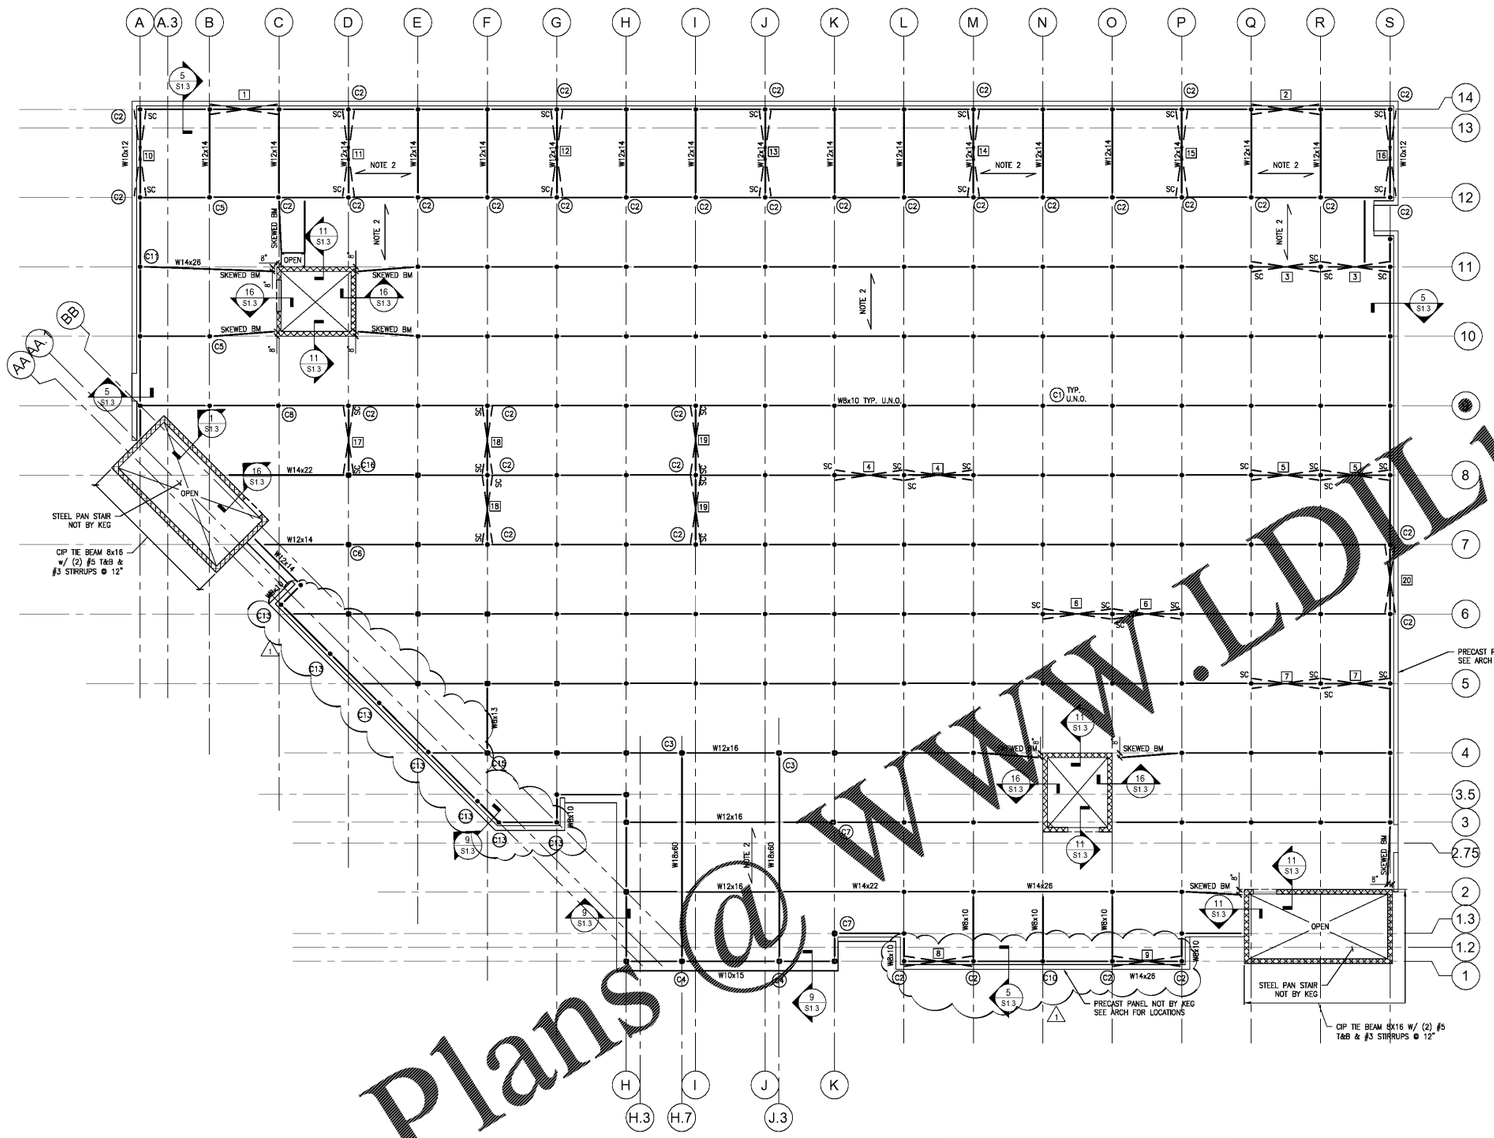

1 FIFTH FLOOR FRAMING PLAN
SCALE: 1/8"=1'-0"

PLAN NOTES:
1. COORDINATE ALL DIMENSIONS AND ELEVATIONS WITH THE ARCHITECTURAL DRAWINGS BEFORE COMMENCING CONSTRUCTION. ALL DISCREPANCIES SHALL BE BROUGHT TO THE ATTENTION OF THE ARCHITECT AND STRUCTURAL ENGINEER.
2. 3" 20ga. COMPOSITE METAL DECK (VULCRAFT 3VLI OR EQ.) w/2½" NORMAL WEIGHT CONCRETE (TOTAL = 5½"). REINFORCE w/ 6x6–W1.4xW1.4 WWF. OR 20 lb/yd3 OF 2" STEEL FIBERS OR 4# / CY OF MACRO SYNTHETIC FIBER (SEE STEEL REINF. NOTE ON SHEET S0.1 AND DETAILS). INSTALL DECK SPAN LENGTHS MINIMUM.
3. SEE TYPICAL DETAILS FOR DECK ATTACHMENT.
4. ELEVATIONS SHOWN ON THESE PLANS ARE RELATIVE ELEVATIONS WITHIN THE STRUCTURAL DRAWING SET ONLY WITH TOP OF SLAB AT GROUND LEVEL SET ARBITRARILY AT 0'-0". THE ELEVATIONS CONTAINED ON THESE PLANS DO NOT REPRESENT ACTUAL NGVD ELEVATIONS. REF ARCH AND CIVIL DRAWINGS FOR ACTUAL TOP OF SLAB, TOP OF STEEL AND TOP OF ROOF ELEVATIONS.
5. [1] INDICATES A BRACE MARK, SEE S4.2 THRU S4.3.
6. (C#) INDICATES POST, TYP. SEE SCHEDULE ON S0.1
7. SC INDICATES SLIP CRITICAL BOLTED CONNECTION.
8. INDICATES MOMENT CONNECTION.
9. PRECAST PANELS LOCATED OVER STOREFRONT OPENING, WINDOWS & DOORS SHALL SPAN OVER OPENINGS & PROVIDE SUPPORTING.
   INDICATES PRECAST PANEL NOT BY KEG.

NOTE:
STRUCTURE HAS BEEN DESIGNED AND DETAILED ASSUMING EXTERIOR BRACING SYSTEM FOR EXTERIOR PRECAST PANELS PROVIDED BY OTHERS. IF INTERIOR BRACING IS REQUIRED CONTACT KARINS ENGINEERING GROUP FOR REVIEW

POST LEGEND

C#	POST UP, THIS LEVEL
C#	POST THROUGH, THIS LEVEL
C#	INDICATES POST TERMINATES THIS LEVEL

Order Plans @ WWW.LDILine.com

Jay Dimercurio

Digitally signed by Jay Dimercurio
Date: 2019.12.20 10:05:49 -05'00'

ODa
overcash demmitt
210 south tryon st. suite 1a
charlotte north carolina 28203
office.704.332.1615
web.www.odarch.com

morningstar STORAGE

MORNINGSTAR STORAGE
9700 SOUTH U.S. 17-92
MAITLAND, FL 32752

ODA Project No. 183348

ISSUED

DATE 08.19.2019

REVISIONS

No.	Description	Date
1	OWNER REVISIONS/REVIEW COMMENTS REV 1	12.09.19

19DS-0481

Karins Engineering Group, Inc.
PE, Cert. of Auth. # 8370
1828 Ringling Boulevard, Suite 400
Sarasota, FL 34236
(941) 927-6529 Fax (941) 927-8075
Jerome DiMercurio, PE
FL. Registration # 54448

SEAL
JEROME J. DIMERCURIO
No. 54448
August 23 2019
STATE OF FLORIDA
PROFESSIONAL ENGINEER

THIS DOCUMENT HAS BEEN ELECTRONICALLY SIGNED BY JEROME J. DIMERCURIO, PE USING A DIGITAL SIGNATURE WHICH INCLUDES A SECURE HASH ALGORITHM AUTHENTICATION CODE. (SHA). PRINTED COPIES OF THIS DOCUMENT ARE NOT CONSIDERED SIGNED AND SEALED AND THE SHA AUTHENTICATION CODE MUST BE VERIFIED.

FIFTH FLOOR FRAMING PLAN

S2.5

Copyright 2017 Overcash Demmitt Architects

12/20/2019 9:34:04 AM