SHEET NOTES

1. REF SHEET N1 FOR FINISH KEY

4 TOILET TILE ELEVATION
1/4" = 1'-0"

3 FAMILY RESTROOM FINISH PLAN
3/8" = 1'-0"

2 REAR RESTROOM FINISH PLAN
3/8" = 1'-0"

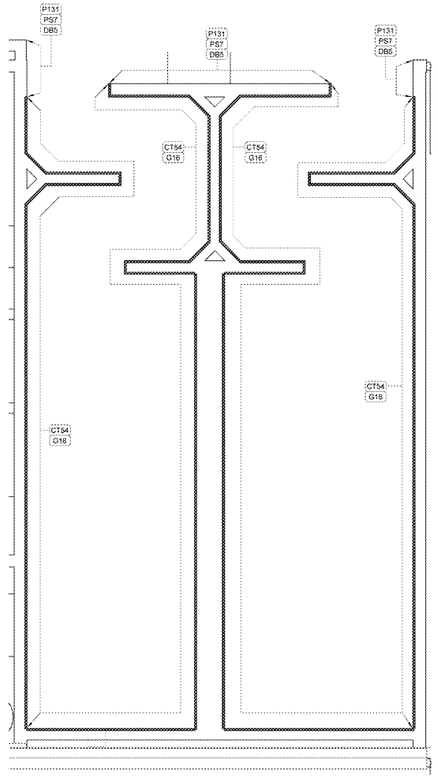

1 FRONT RESTROOM FINISH PLAN
3/8" = 1'-0"

ADD ENTIRE SHEET TO SET

Order Plans @ www.LDILine.com

SGA Design Group, P.C.
1437 South Boulder, Suite 950
Tulsa, Oklahoma 74119-3606
p: 918.587.8600
f: 918.587.8601
www.sgadesigngroup.com

STIPULATION FOR REUSE
THIS DRAWING AND SPECIFICATION ISSUE AND ALL RIGHTS THEREIN ARE EXPRESSLY RESERVED AT COMMON LAW AND UNDER THE COPYRIGHT LAWS OF THE UNITED STATES OF AMERICA. THESE DRAWINGS AND SPECIFICATIONS ARE NOT TO BE USED BY ANY PERSON, FIRM OR CORPORATION FOR ANY PURPOSE WHATSOEVER ON ANY PROJECT WHICH IS NOT THE EXACT PROJECT (SITE) REPRESENTED HEREIN, WITHOUT THE WRITTEN PERMISSION OF SGA DESIGN GROUP, P.C. IN THE EVENT OF UNAUTHORIZED REUSE BY ANY PARTY, SUCH PARTY SHALL INDEMNIFY AND HOLD HARMLESS SGA DESIGN GROUP, P.C. FROM ANY AND ALL CLAIMS, DAMAGES, LOSSES AND EXPENSES INCLUDING ATTORNEY'S FEES ARISING OUT OF OR RESULTING THEREFROM.

CONSULTANTS

Walmart

LELAND, NC
1112 NEW POINT BOULEVARD
STORE NO. 4273-226

2020 SPRB

JOB NUMBER: 19PAK09 PROTO: 195

ISSUE BLOCK

1	PR #1	06/15/20

CHECKED BY:	RO / AVT
DRAWN BY:	KM
PROTO CYCLE:	02/28/20
DOCUMENT DATE:	04/06/20

THE RECORD COPY OF THIS DRAWING IS ON FILE AT THE OFFICES OF SGA DESIGN GROUP, P.C. THIS ELECTRONIC DOCUMENT IS PREPARED FOR THE PURPOSE OF REPRODUCES, CORPORATION, INCLUDE FACILITY MANAGEMENT. THIS DRAWING IS NOT TO BE CONSIDERED FINAL OR COMPLETE UNLESS IT IS SIGNED AND SEALED BY THE ARCHITECT.

RESTROOM FINISH PLANS

SHEET: A5.3