NOTES: SEE SHEET A-401 FOR TOILET ACCESSORY SCHEDULE.
SEE SHEET A-703 FOR FINISH SCHEDULE.

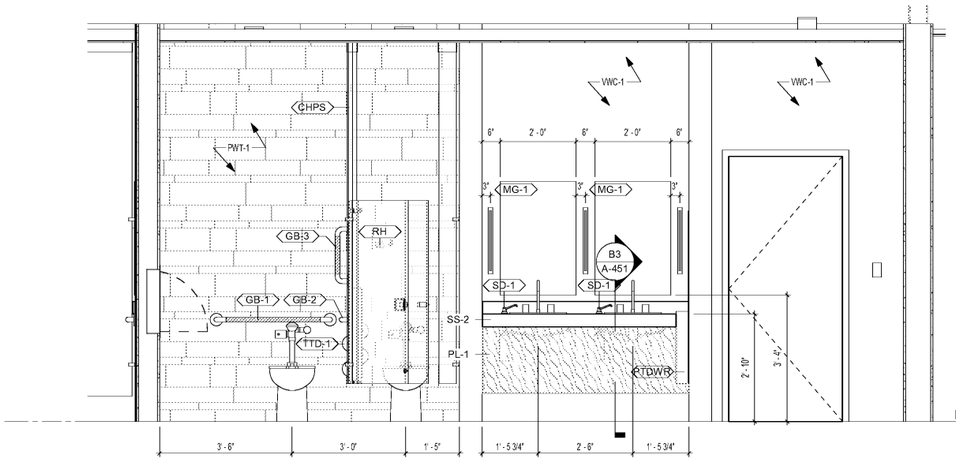

HP / SLAB
0' - 0"

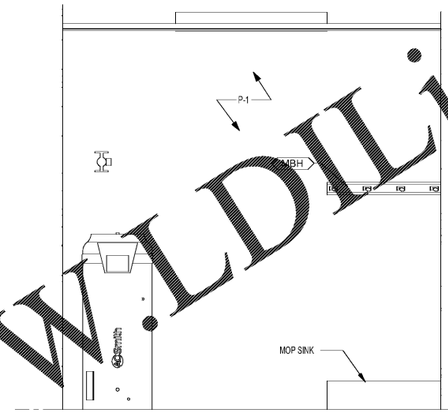

HP / SLAB
0' - 0"

C1 INTERIOR ELEVATION - PASSENGER WOMEN'S

SCALE: 1/2" = 1'-0"

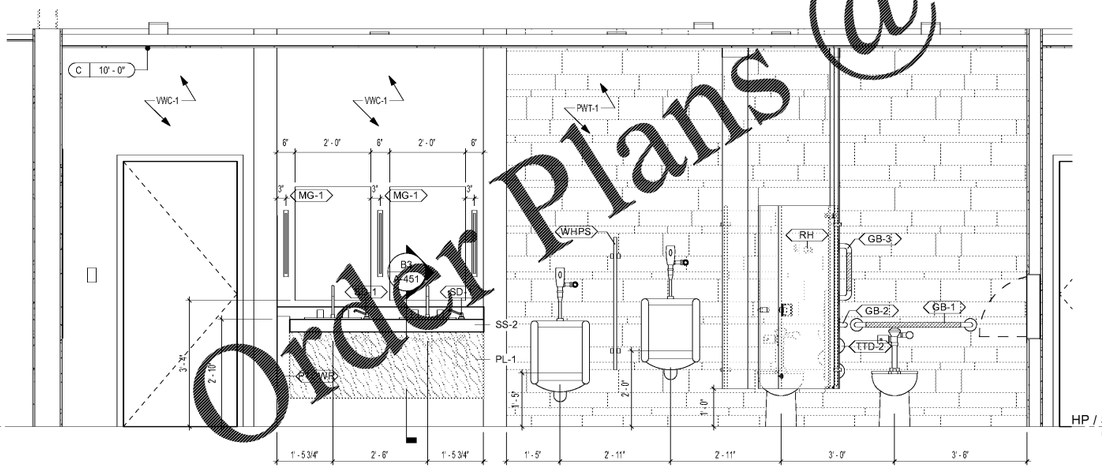

HP / SLAB
0' - 0"

C4 INTERIOR ELEVATION - JANITOR

SCALE: 1/2" = 1'-0"

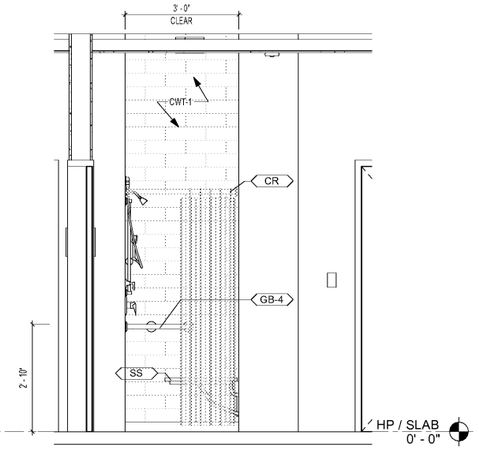

HP / SLAB
0' - 0"

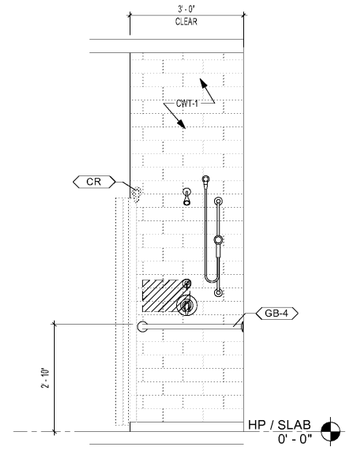

HP / SLAB
0' - 0"

A1 INTERIOR ELEVATION - PASSENGER MEN'S

SCALE: 1/2" = 1'-0"

A4 SHOWER ELEVATION - WEST

SCALE: 1/2" = 1'-0"

A5 SHOWER ELEVATION - SOUTH

SCALE: 1/2" = 1'-0"

2 0 2 4

SCALE: 1/2" = 1'-0"

Order Plans @ WWW.LDILine.com

NORFOLK SOUTHERN

MARK	DESCRIPTION	DATE

DESIGNED BY: E. Ames
DRAWN BY: B. Lilton / J. Im
CHECKED BY: K. Wilade-Teske
SUBMITTED BY: Ames
ISSUED FOR CONSTRUCTION: DD-MMM-YYYY

NORFOLK SOUTHERN CORP.
1200 PEACHTREE STREET, NE
ATLANTA, GEORGIA 30309
404-529-1230

POND
3500 Parkway Lane, Suite 500
Peachtree Corners, GA 30092
Phone (678) 336-7744
Fax (678) 336-7745

THESE DRAWINGS ARE:
VERSION 0.1 - PRELIMINARY

DOCUMENT CLASSIFICATION:
BUSINESS IBI AND STORAGE (BIT

THESE DRAWINGS ARE:
PIPE 09 - CONSTRUCTION
PIPE 08 - NON-CONSTRUCTIBLE

THESE WORK AS-BUILT DRAWINGS WERE PREPARED BASED ON FIELD MARK-UPS PROVIDED BY THE CONTRACTOR AND/OR OTHERS AND ARE NOT WARRANTED BY POND & COMPANY. THEY ARE INTENDED TO BE A GENERAL REPRESENTATION OF THE WORK AS CONSTRUCTED AND DO NOT REPRESENT A FIELD VERIFIED SURVEY OF THE AS-BUILT CONDITIONS. THE CONTRACTOR AND/OR OTHERS ARE RESPONSIBLE FOR FIELD VERIFYING ALL AS-BUILT CONDITIONS AND DIMENSIONS.

CORPORATE AIRCRAFT HANGAR FOR NORFOLK SOUTHERN CORPORATION
FULTON COUNTY AIRPORT-BROWN FIELD (FTY)
3252 AVIATION CIRCLE, SUITE 200
ATLANTA, GEORGIA 30336

INTERIOR ELEVATIONS

SHEET ID
A-421

Copyright © 2020 by Pond & Company. All rights reserved. No copying or duplication of these documents is allowed without the express written agreement of Pond & Company.

CONSTRUCTION DOCUMENTS

7/10/2020 10:41:46 AM BIM 360://1190557 - Pegasus/1190557_Pegasus_NS_Arch_CENTAL_v19_R3.rvt