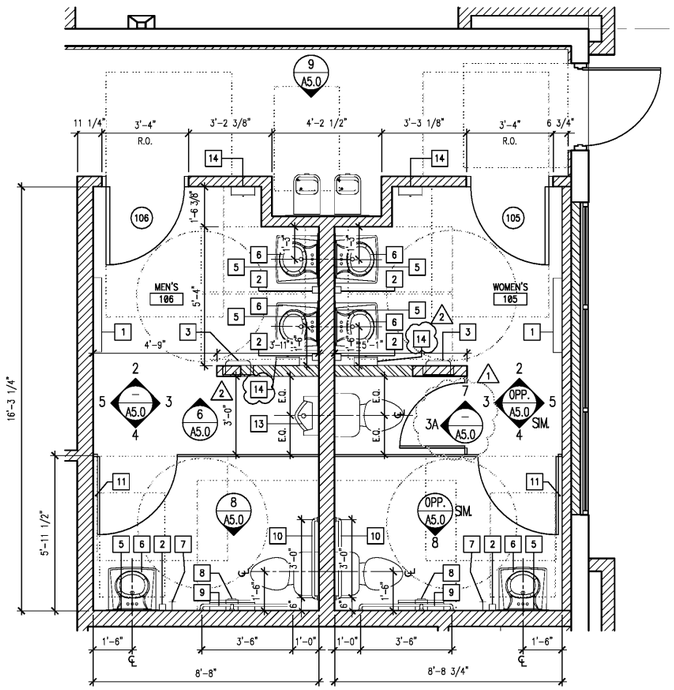

1 ENLARGED RESTROOM PLAN 3/8" = 1'-0"

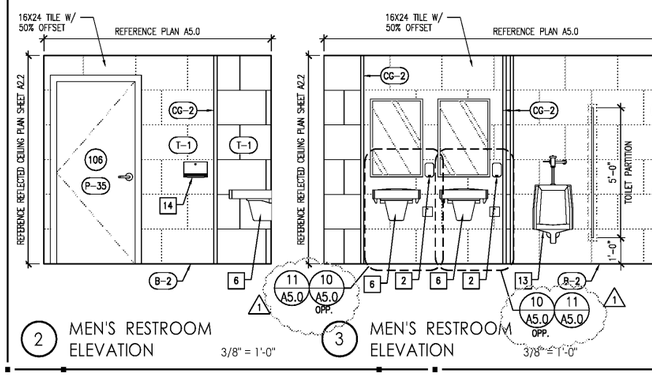

2 MEN'S RESTROOM ELEVATION 3/8" = 1'-0"

3 MEN'S RESTROOM ELEVATION 3/8" = 1'-0"

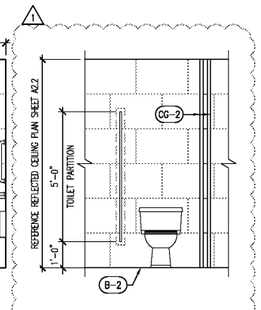

3A WOMEN'S RESTROOM ELEVATION 3/8" = 1'-0"

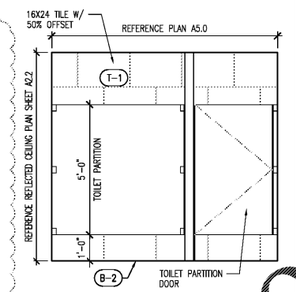

4 MEN'S RESTROOM ELEVATION 3/8" = 1'-0"

GENERAL NOTES

1. REFERENCE ACCESSORY MOUNTING SCHEDULE FOR MOUNTING DIMENSIONS OF TOILET & ACCESSORIES.
2. PROVIDE 2X FRT WOOD BLOCKING FOR ALL WALL MOUNTED PLUMBING FIXTURES, GRAB BARS, CABINETS, COUNTERS, TOILET ACCESSORIES, ETC.
3. TOILET FIXTURE TO BE MOUNTED 18" FROM FINISHED WALL TO CENTERLINE OF TOILET FIXTURE.
4. WATER CLOSET COMPARTMENT SHALL BE EQUIPPED WITH A DOOR THAT HAS AN AUTOMATIC-CLOSING DEVICE. THE DOOR IS REQUIRED TO HAVE A MINIMUM 9 INCH CLEARANCE FOR FOOTRESTS UNDERNEATH. THE INSIDE & OUTSIDE OF THE COMPARTMENT DOOR SHALL BE EQUIPPED WITH A LOOP OR U-SHAPED HANDLE IMMEDIATELY BELOW THE LATCH. THE LATCH SHALL BE FLIP-OVER STYLE, SLIDING OR OTHER HARDWARE NOT REQUIRING THE USER TO GRASP OR TWIST.
5. CONTROLS FOR FLUSH VALVES SHALL BE MOUNTED ON THE WIDE SIDE OF TOILET STALLS NO MORE THAN 44" AFF.
6. G.C. TO CAULK INSIDE CORNERS AND TOP OF TILE.
7. RESTROOM DOOR CLEARANCE TO COMPLY WITH LOCAL CODES.
8. HOT WATER & DRAIN PIPES EXPOSED UNDER SINKS SHALL BE INSULATED OR OTHERWISE CONFIGURED SO AS TO PROTECT AGAINST CONTACT. THERE SHALL BE NO SHARP OR ABRASIVE SURFACES UNDER SINKS.
9. FILLET GROUT LINES ARE TO BE USED AT WALL AND CEILING LOCATIONS WHERE THE TILE MEETS DRYWALL, MAXIMUM THICKNESS OF 1/4".

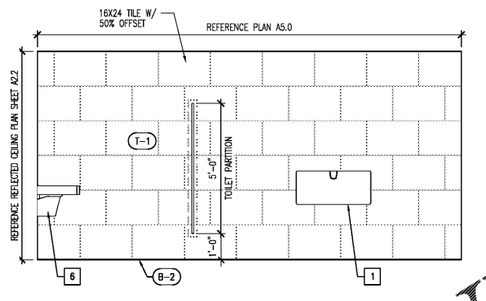

5 MEN'S RESTROOM ELEVATION 3/8" = 1'-0"

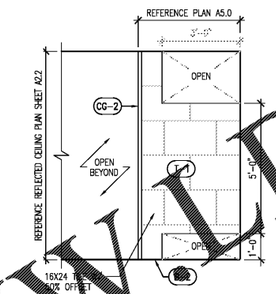

6 MEN'S RESTROOM ELEVATION 3/8" = 1'-0"

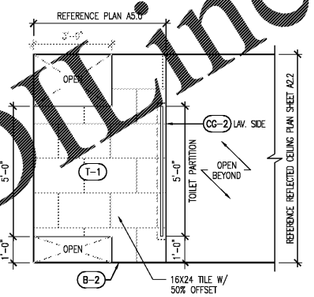

7 WOMEN'S RESTROOM ELEVATION 3/8" = 1'-0"

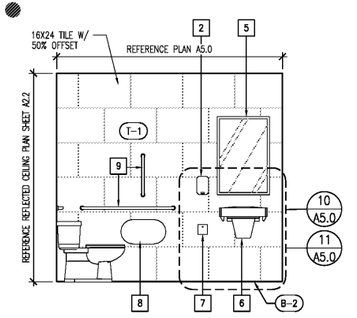

8 MEN'S RESTROOM ELEVATION 3/8" = 1'-0"

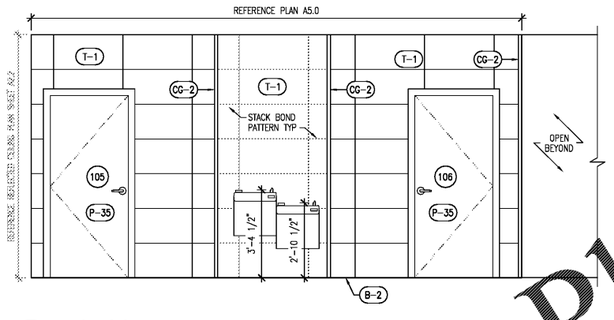

9 RESTROOM ELEVATION 3/8" = 1'-0"

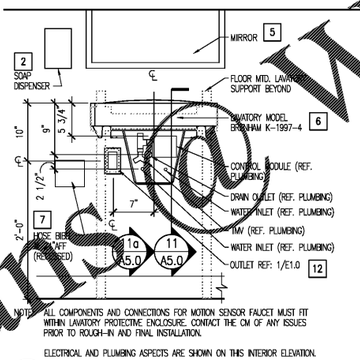

10 INT. ELEV. - LAVATORY 1" = 1'-0"

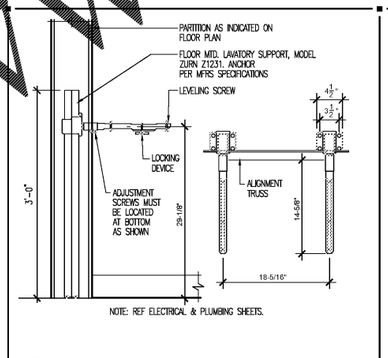

11 LAVATORY SADDLE DETAIL (TYP) 1" = 1'-0"

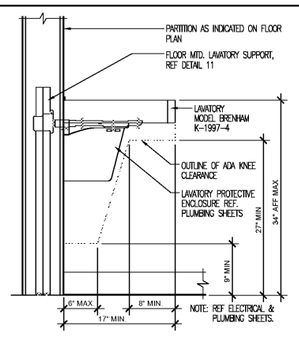

11a LAVATORY SECTION (TYP) 1" = 1'-0"

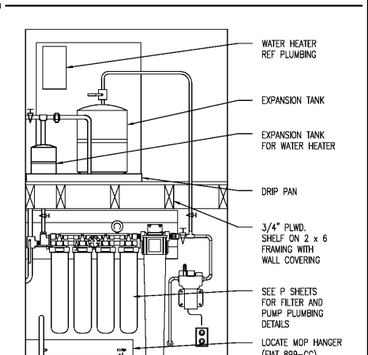

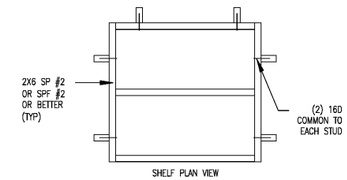

SHELF PLAN VIEW

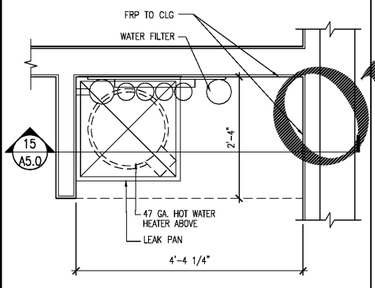

12 PLAN @ WATER HEATER 3/4" = 1'-0"

KEY NOTE DETAILS (NOT ALL ACCESSORIES MAY BE USED. REFER TO ENLARGED RESTROOM PLAN FOR LOCATION)

1 BABY CHANGE STATION	2 SOAP DISPENSER	3 ELECTRICAL HAND DRYER W/ RECESS KIT	4 ELECTRIC HAND DRYER	5 RESTROOM MIRROR	6 LAVATORY	7 HOSE BIBB	8 TOILET PAPER DISPENSER	9 42" GRAB BAR / 18" VERTICAL GRAB BAR	10 36" GRAB BAR	11 COAT HOOK	12 OUTLET FOR FAUCET SENSOR	13 ELECTRONIC FLUSH VALVE URINAL	14 PAPER TOWEL DISPENSER
44" MAX TO CONTROL; 34" MAX TO LIP; 27" MIN.	3'-4" MAX TO SPOUT	3'-4" MAX TO SPOUT	3'-4" MAX TO SPOUT	3'-4" MAX REFLECTIVE SURFACE	34" MAX	2'-0"	19" MIN; 17"-18"; 2" HOLD; 7'-9"	54" MIN; 42" MIN; 40"; 24" MIN; 3'-4"; 1'-6"; 33"-36"**; 17"-19"; **TO TOP OF GRIPPING SURFACE	36" MIN; 24" MIN; 12" MAX; 6"; 1 1/2" MIN; 28"; 17"-19"; 33"-36"**; 16"-18"; **TO TOP OF GRIPPING SURFACE	44"; 60"	2'-0"	1'-5" ADA DRAIN	3'-11" T.O. UNIT

FOR REFERENCE ONLY - FOLLOW ALL LOCAL JURISDICTION CODES

15 SECTION @ WATER HEATER 3/4" = 1'-0"

Order Plans Online.com
WWW

INTERPLAN LLC
ARCHITECTURE
ENGINEERING
INTERIOR DESIGN
PROJECT MANAGEMENT

LAUREL MARTIN, #AR99238
AR0011595
CA 8660

604 COURTLAND STREET
SUITE 100
ORLANDO, FLORIDA 32804
PH 407.645.5008
FX 407.629.9124

SEAL:

THIS DOCUMENT IS NOT FOR REGULATORY APPROVAL, PERMITTING, OR CONSTRUCTION.

FOR BIDDING ONLY 09/03/2020

2 07/30/20 PEER REVIEW COMMENTS
1 04/27/20 PEER COMMENTS
NO DATE REMARKS
REVISIONS

7-ELEVEN STORE #41559

1245 S. VOLUSIA AVENUE
Orange City, FL 32763

PROJECT NO: 2019.0743
DATE: APRIL 7, 2020

A5.0

ENLARGED RESTROOM PLAN AND INTERIOR ELEVATIONS

CHECKED: RW DRAWN: JM

COPYRIGHT © 2020 INTERPLAN LLC RESERVES COPYRIGHT & OTHER RIGHTS RESTRICTING THESE DOCUMENTS TO THE ORIGINAL SITE OR PURPOSE FOR WHICH THEY WERE PREPARED. REPRODUCTION, CHANGES OR ASSIGNMENTS ARE PROHIBITED.

JENARS - 09/01/2020 11:26:09 AM