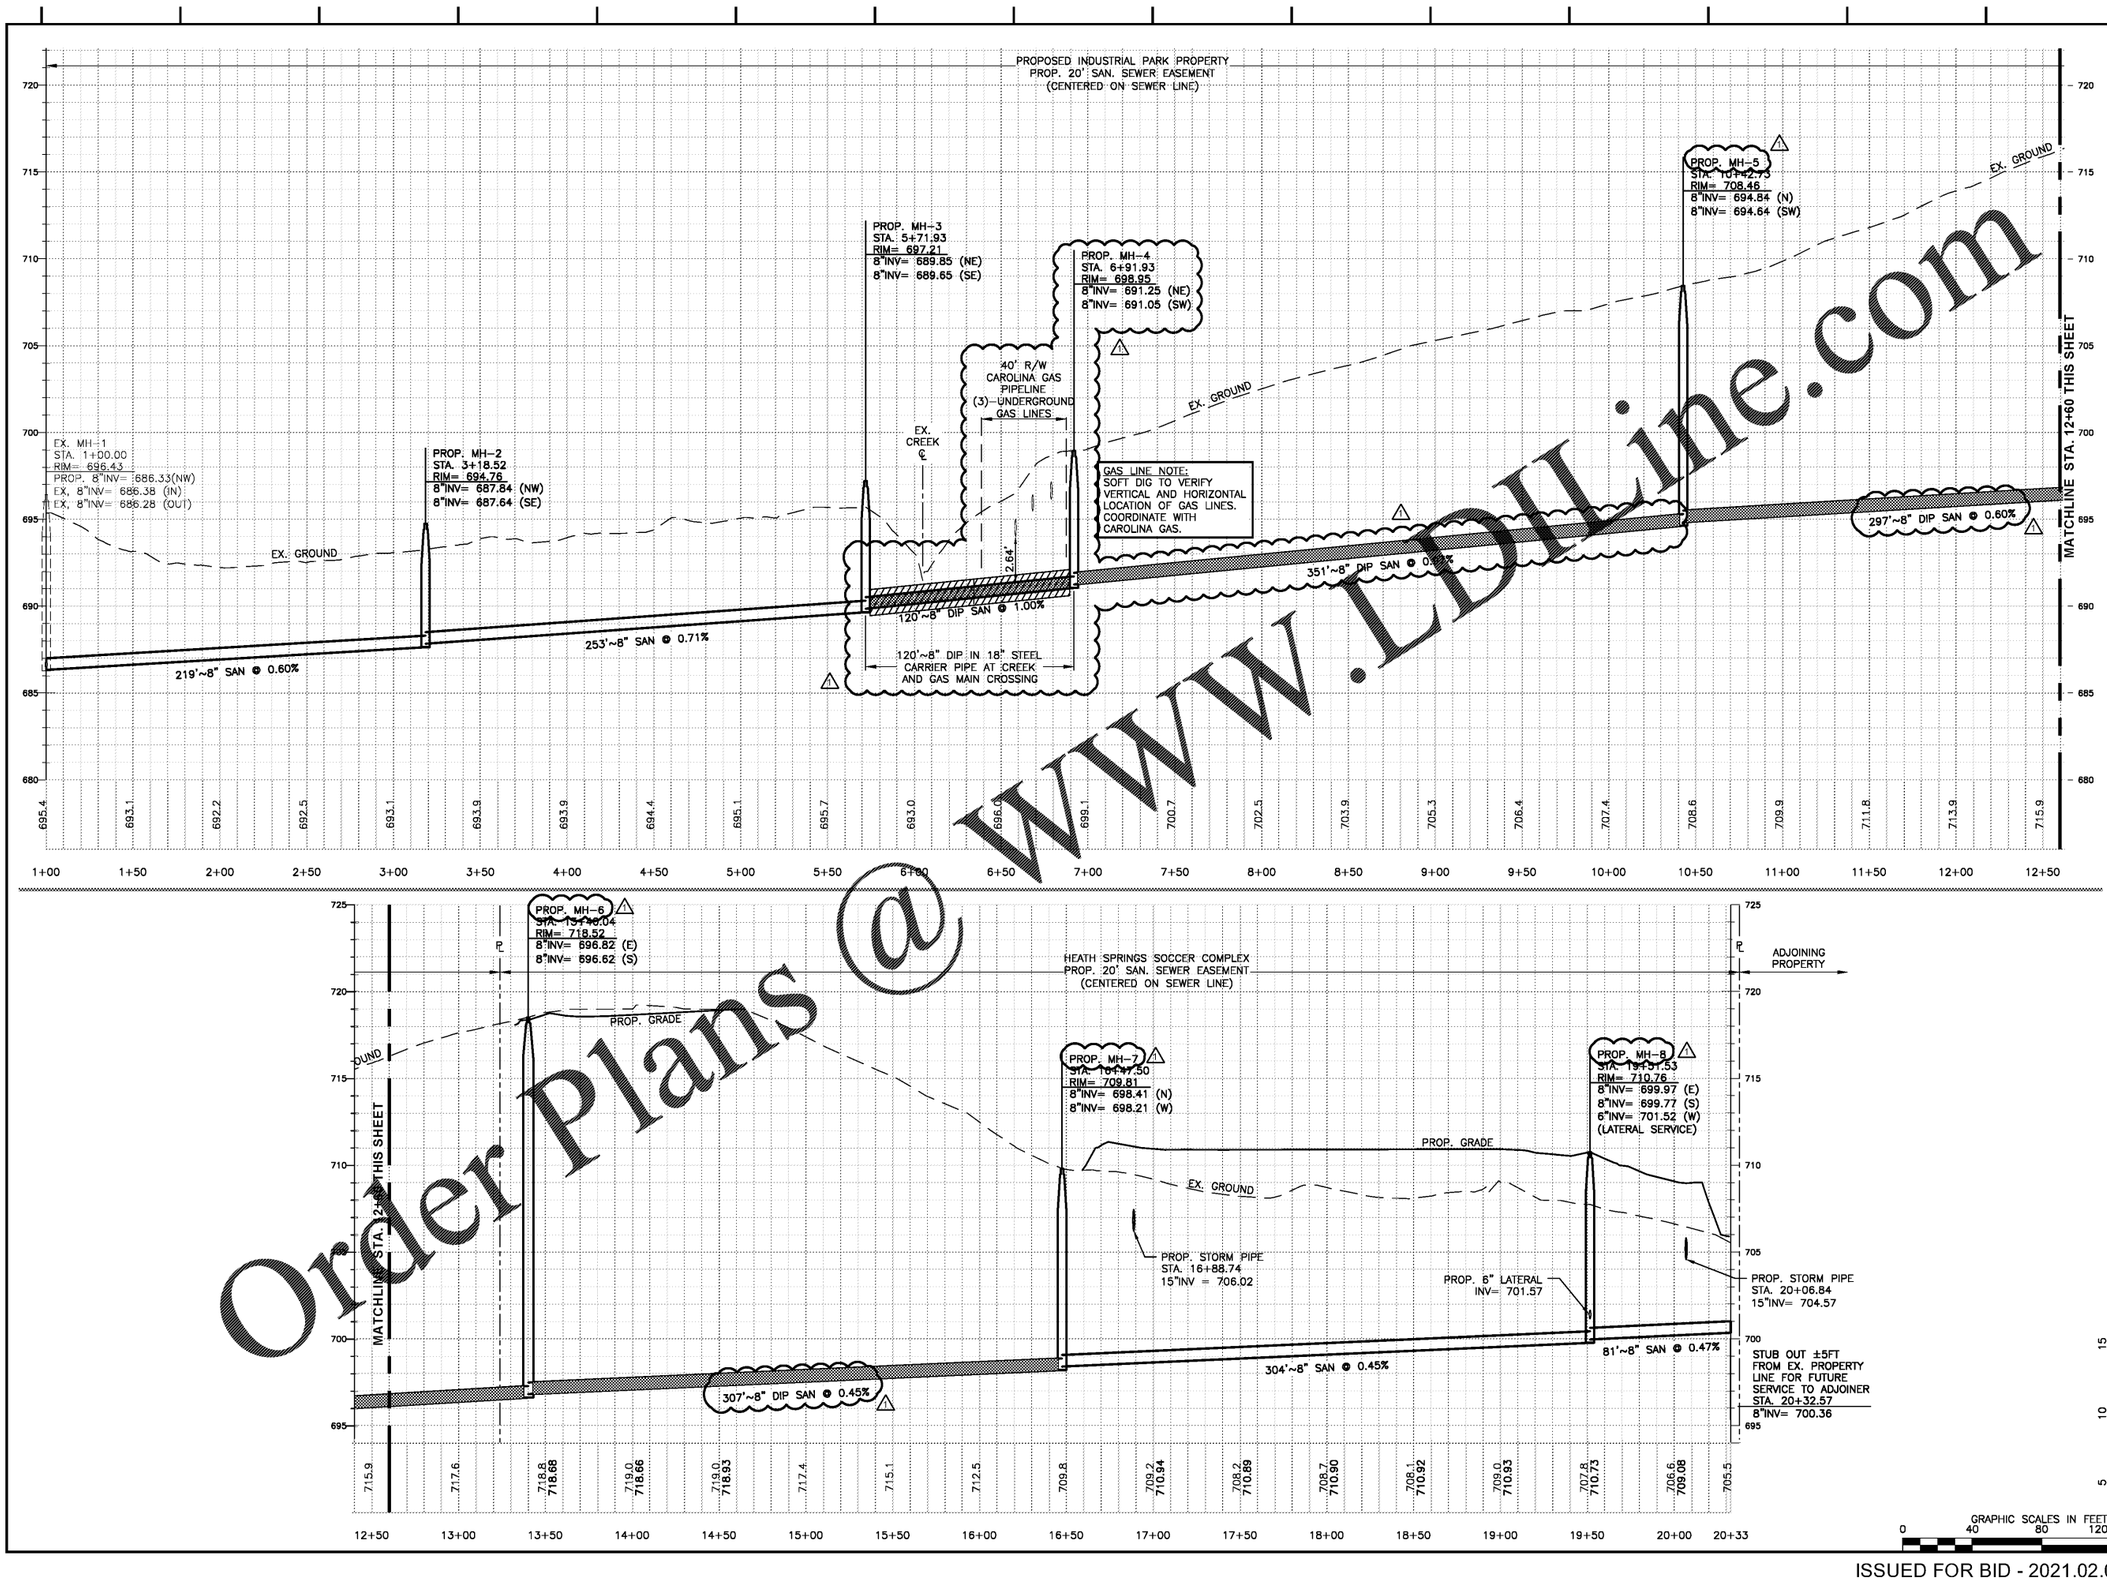

Order Plans @ WWW.LDLine.com

ISSUED FOR BID - 2021.02.04

WOOLPERT
ARCHITECTURE | ENGINEERING | GEOSPATIAL

11301 Camel Commons Blvd
Suite 300
Charlotte, NC 28226
704.525.6284
FAX: 704.525.0115

SOUTH CAROLINA PROFESSIONAL ENGINEER
No. 36763
Mary E Murray
MARY E MURRAY
1-29-2021

SOUTH CAROLINA
WOOLPERT INC
No. C02930
CERTIFICATE OF AUTHORIZATION

Lancaster County, South Carolina

Heath Springs Soccer Complex

200 Boyd Falls Road
Heath Springs, SC 29058

Revisions:
PER REVIEW COMMENTS - 1 1/28/2021

Proj. No.: 80703
Date: 10/09/2020

Sheet Name:
Utility Profile -
8" Sanitary Sewer
Main

L-603